



0376_654

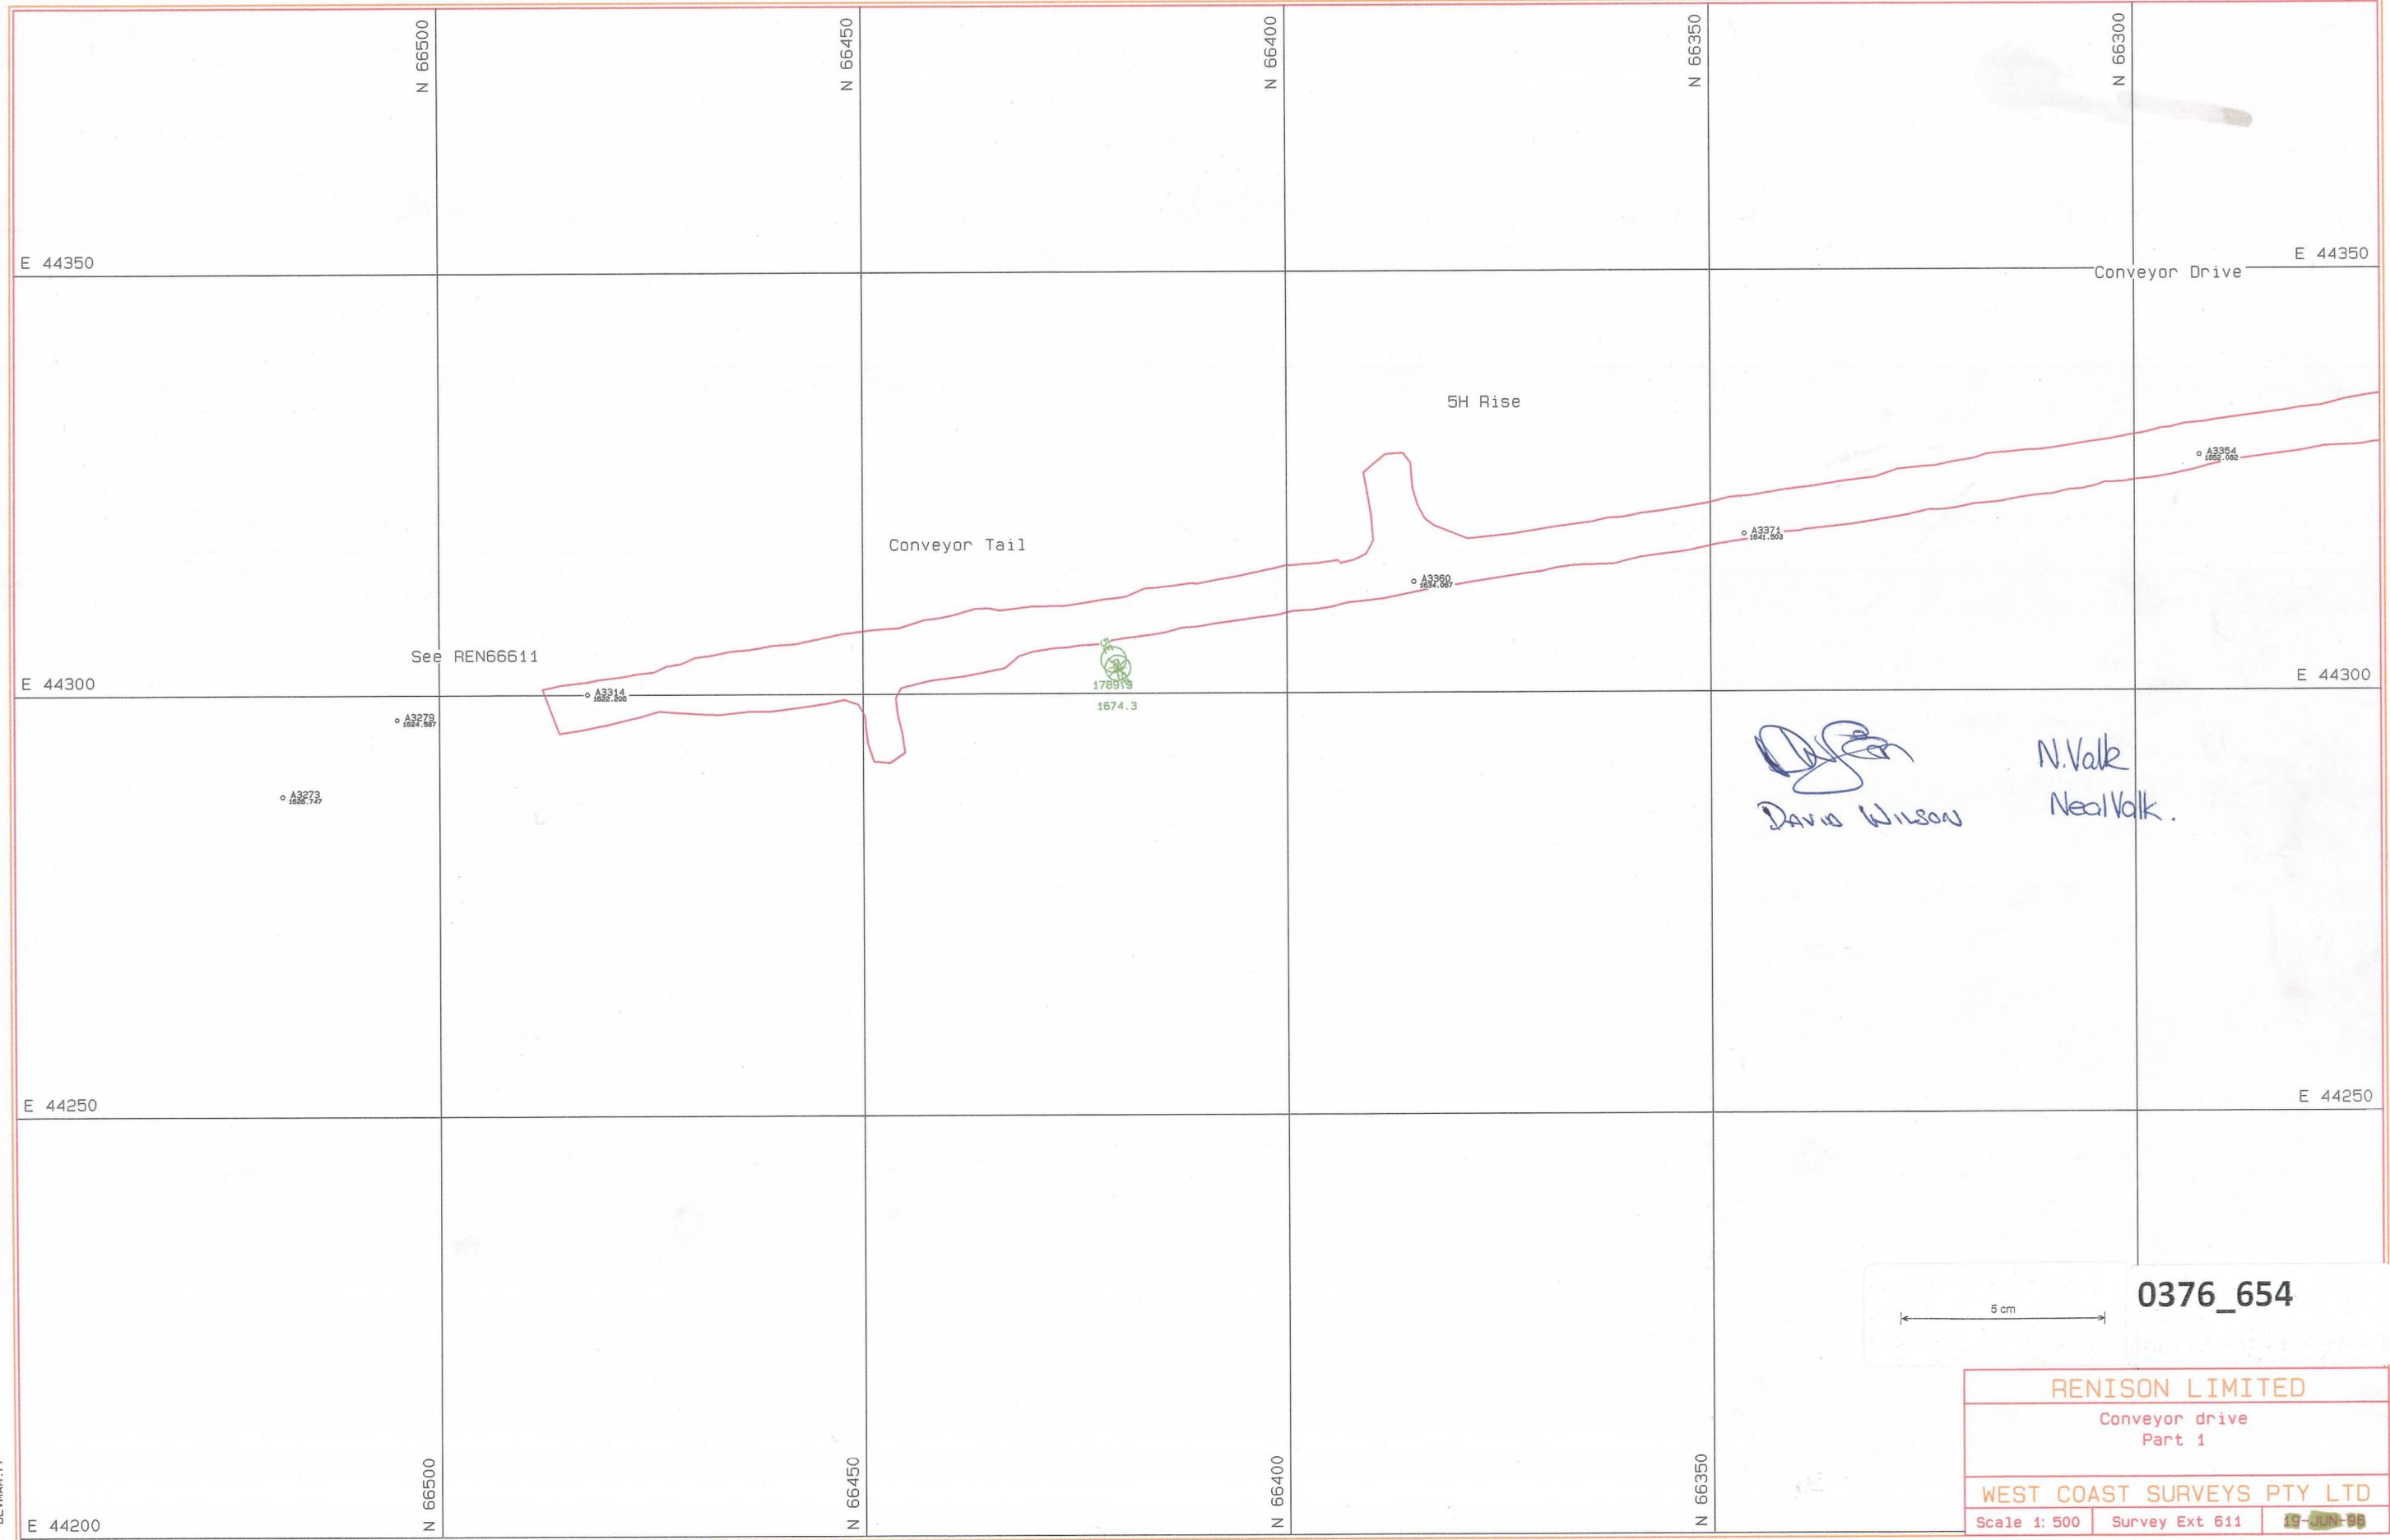

0376_654

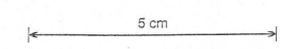

RENISON LIMITED		
Conveyor drive Part 1		
WEST COAST SURVEYS PTY LTD		
Scale 1: 500	Survey Ext 611	19-JUN-95

DEWAM. PF