


0376\_655

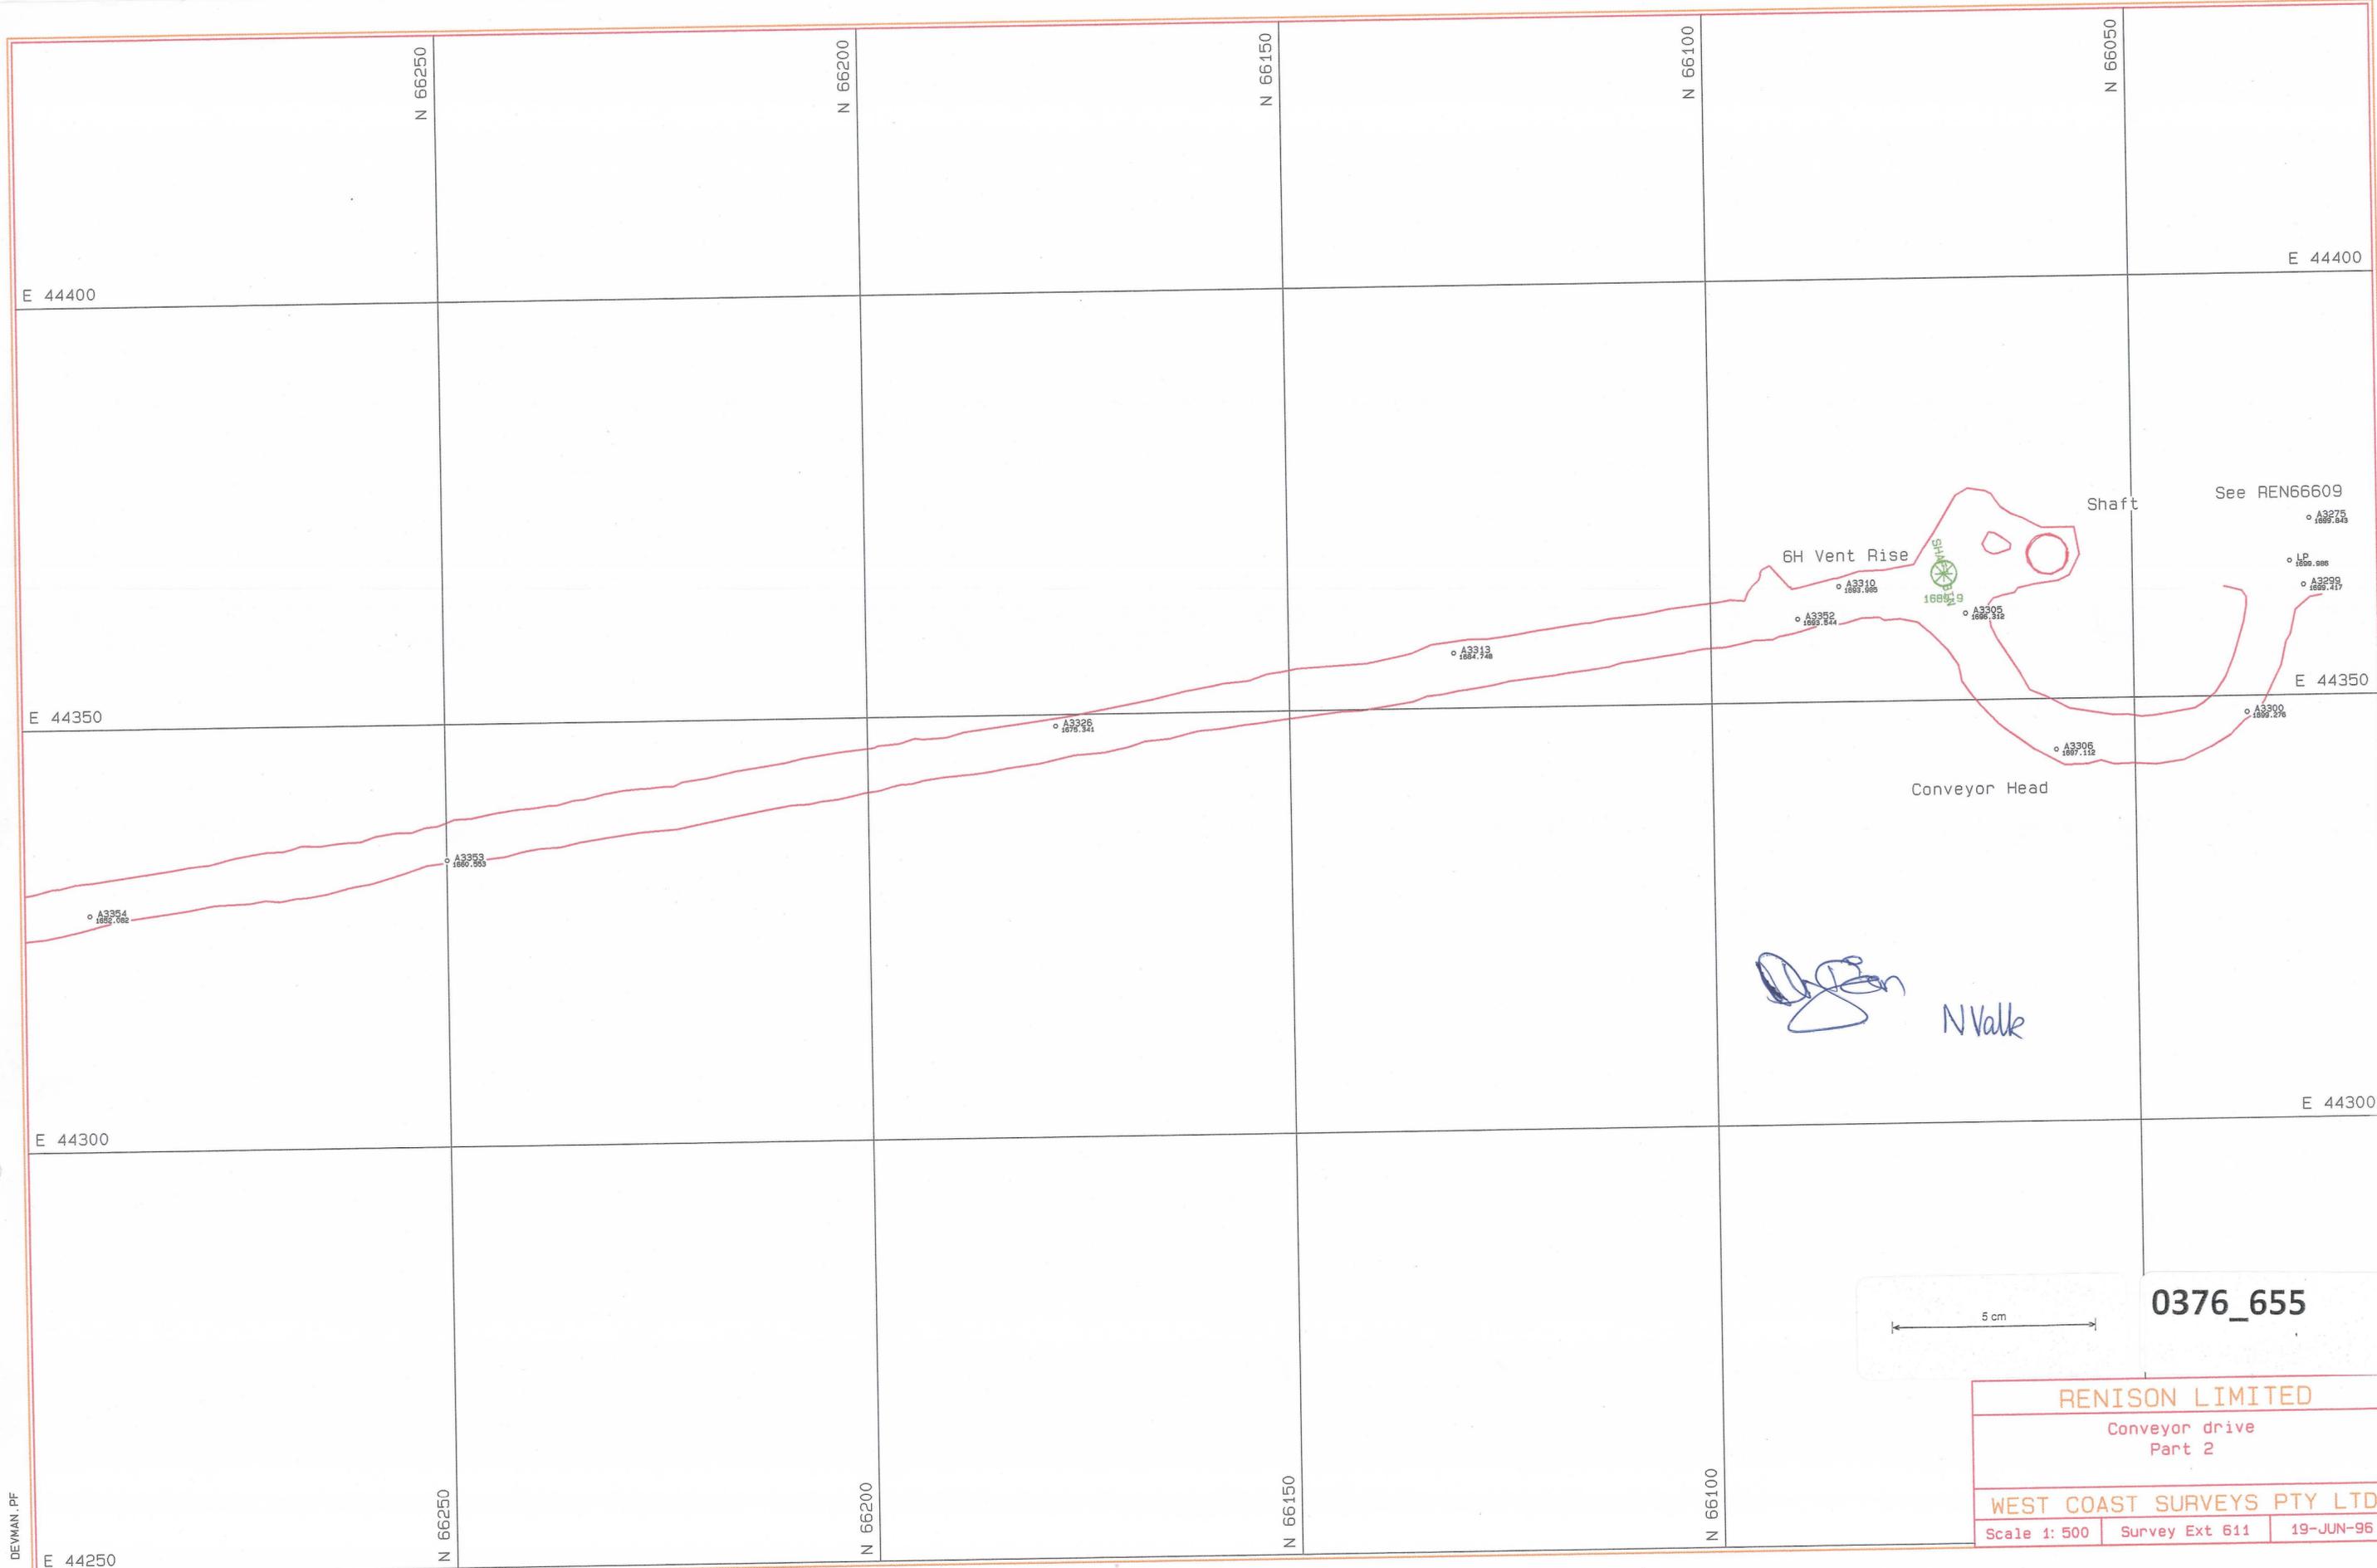

0376\_655

<b>RENISON LIMITED</b>		
Conveyor drive Part 2		
<b>WEST COAST SURVEYS PTY LTD</b>		
Scale 1: 500	Survey Ext 611	19-JUN-96

DEWMAN, PF