


0376_656

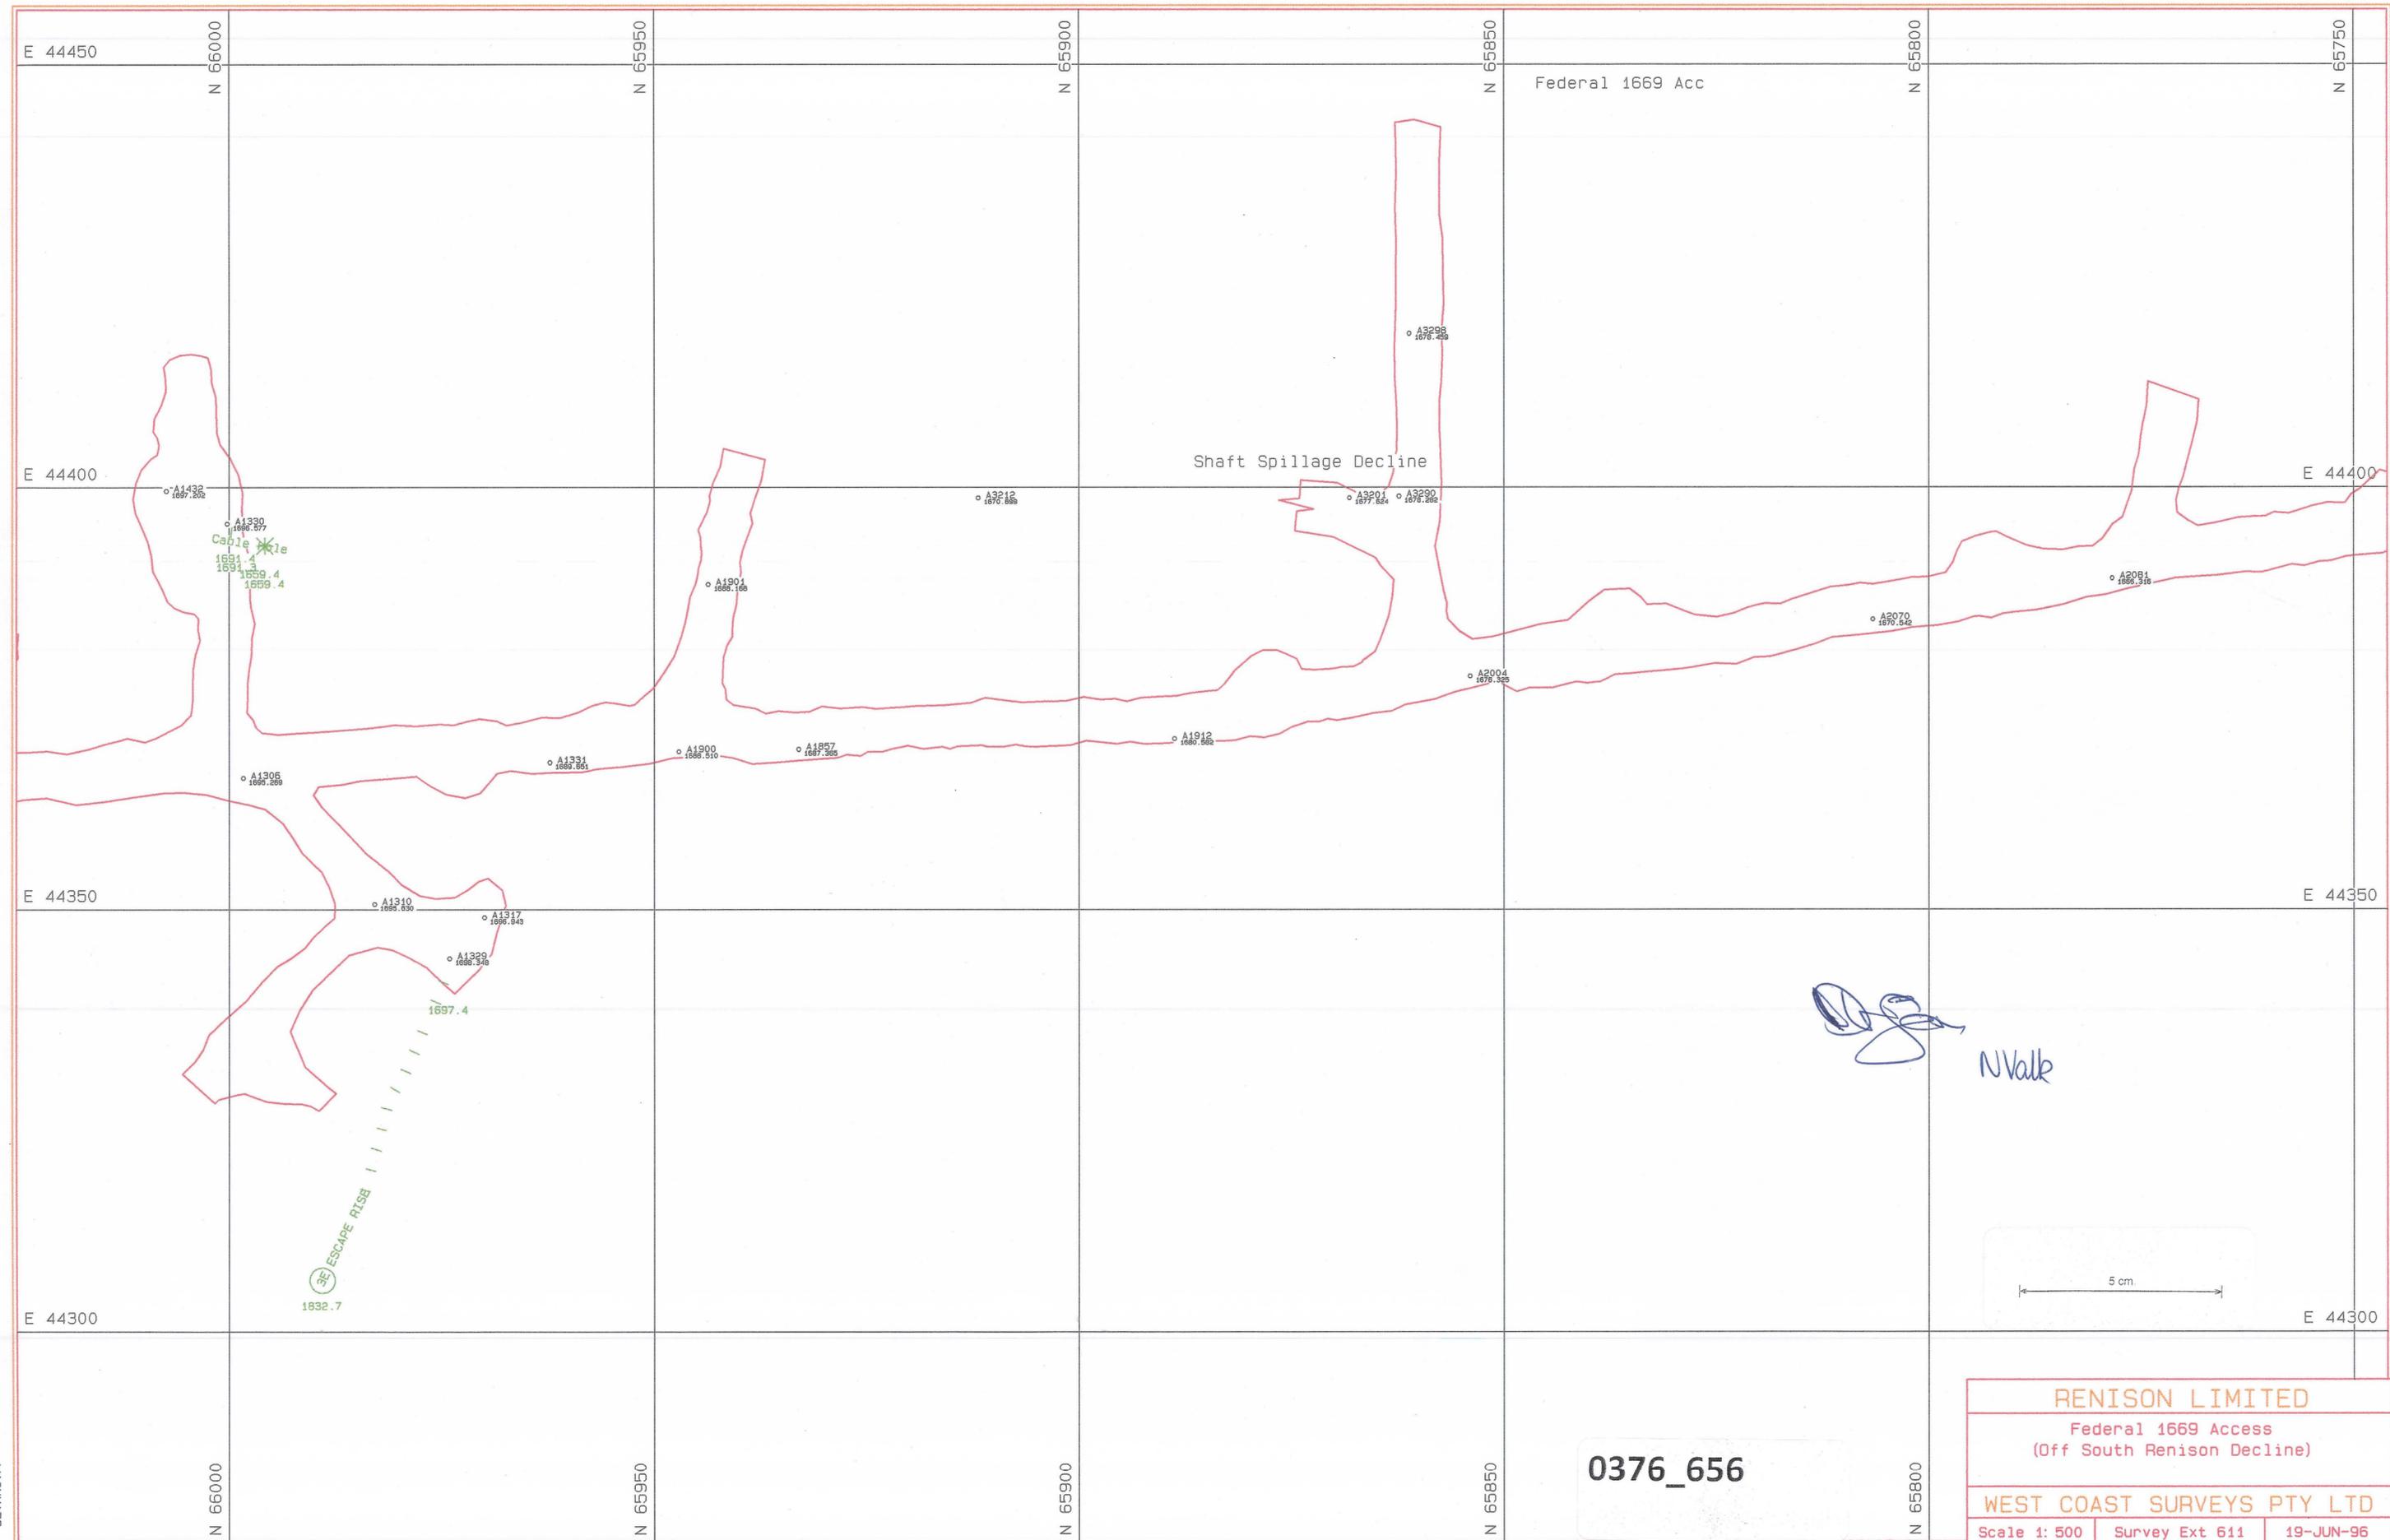

Federal 1669 Acc

Shaft Spillage Decline

Cable Xle

3E
ESCAPE RISE
1832.7

N Walk

5 cm

0376_656

RENISON LIMITED		
Federal 1669 Access (Off South Renison Decline)		
WEST COAST SURVEYS PTY LTD		
Scale 1: 500	Survey Ext 611	19-JUN-96

DEWMA0.PF