



0376_657

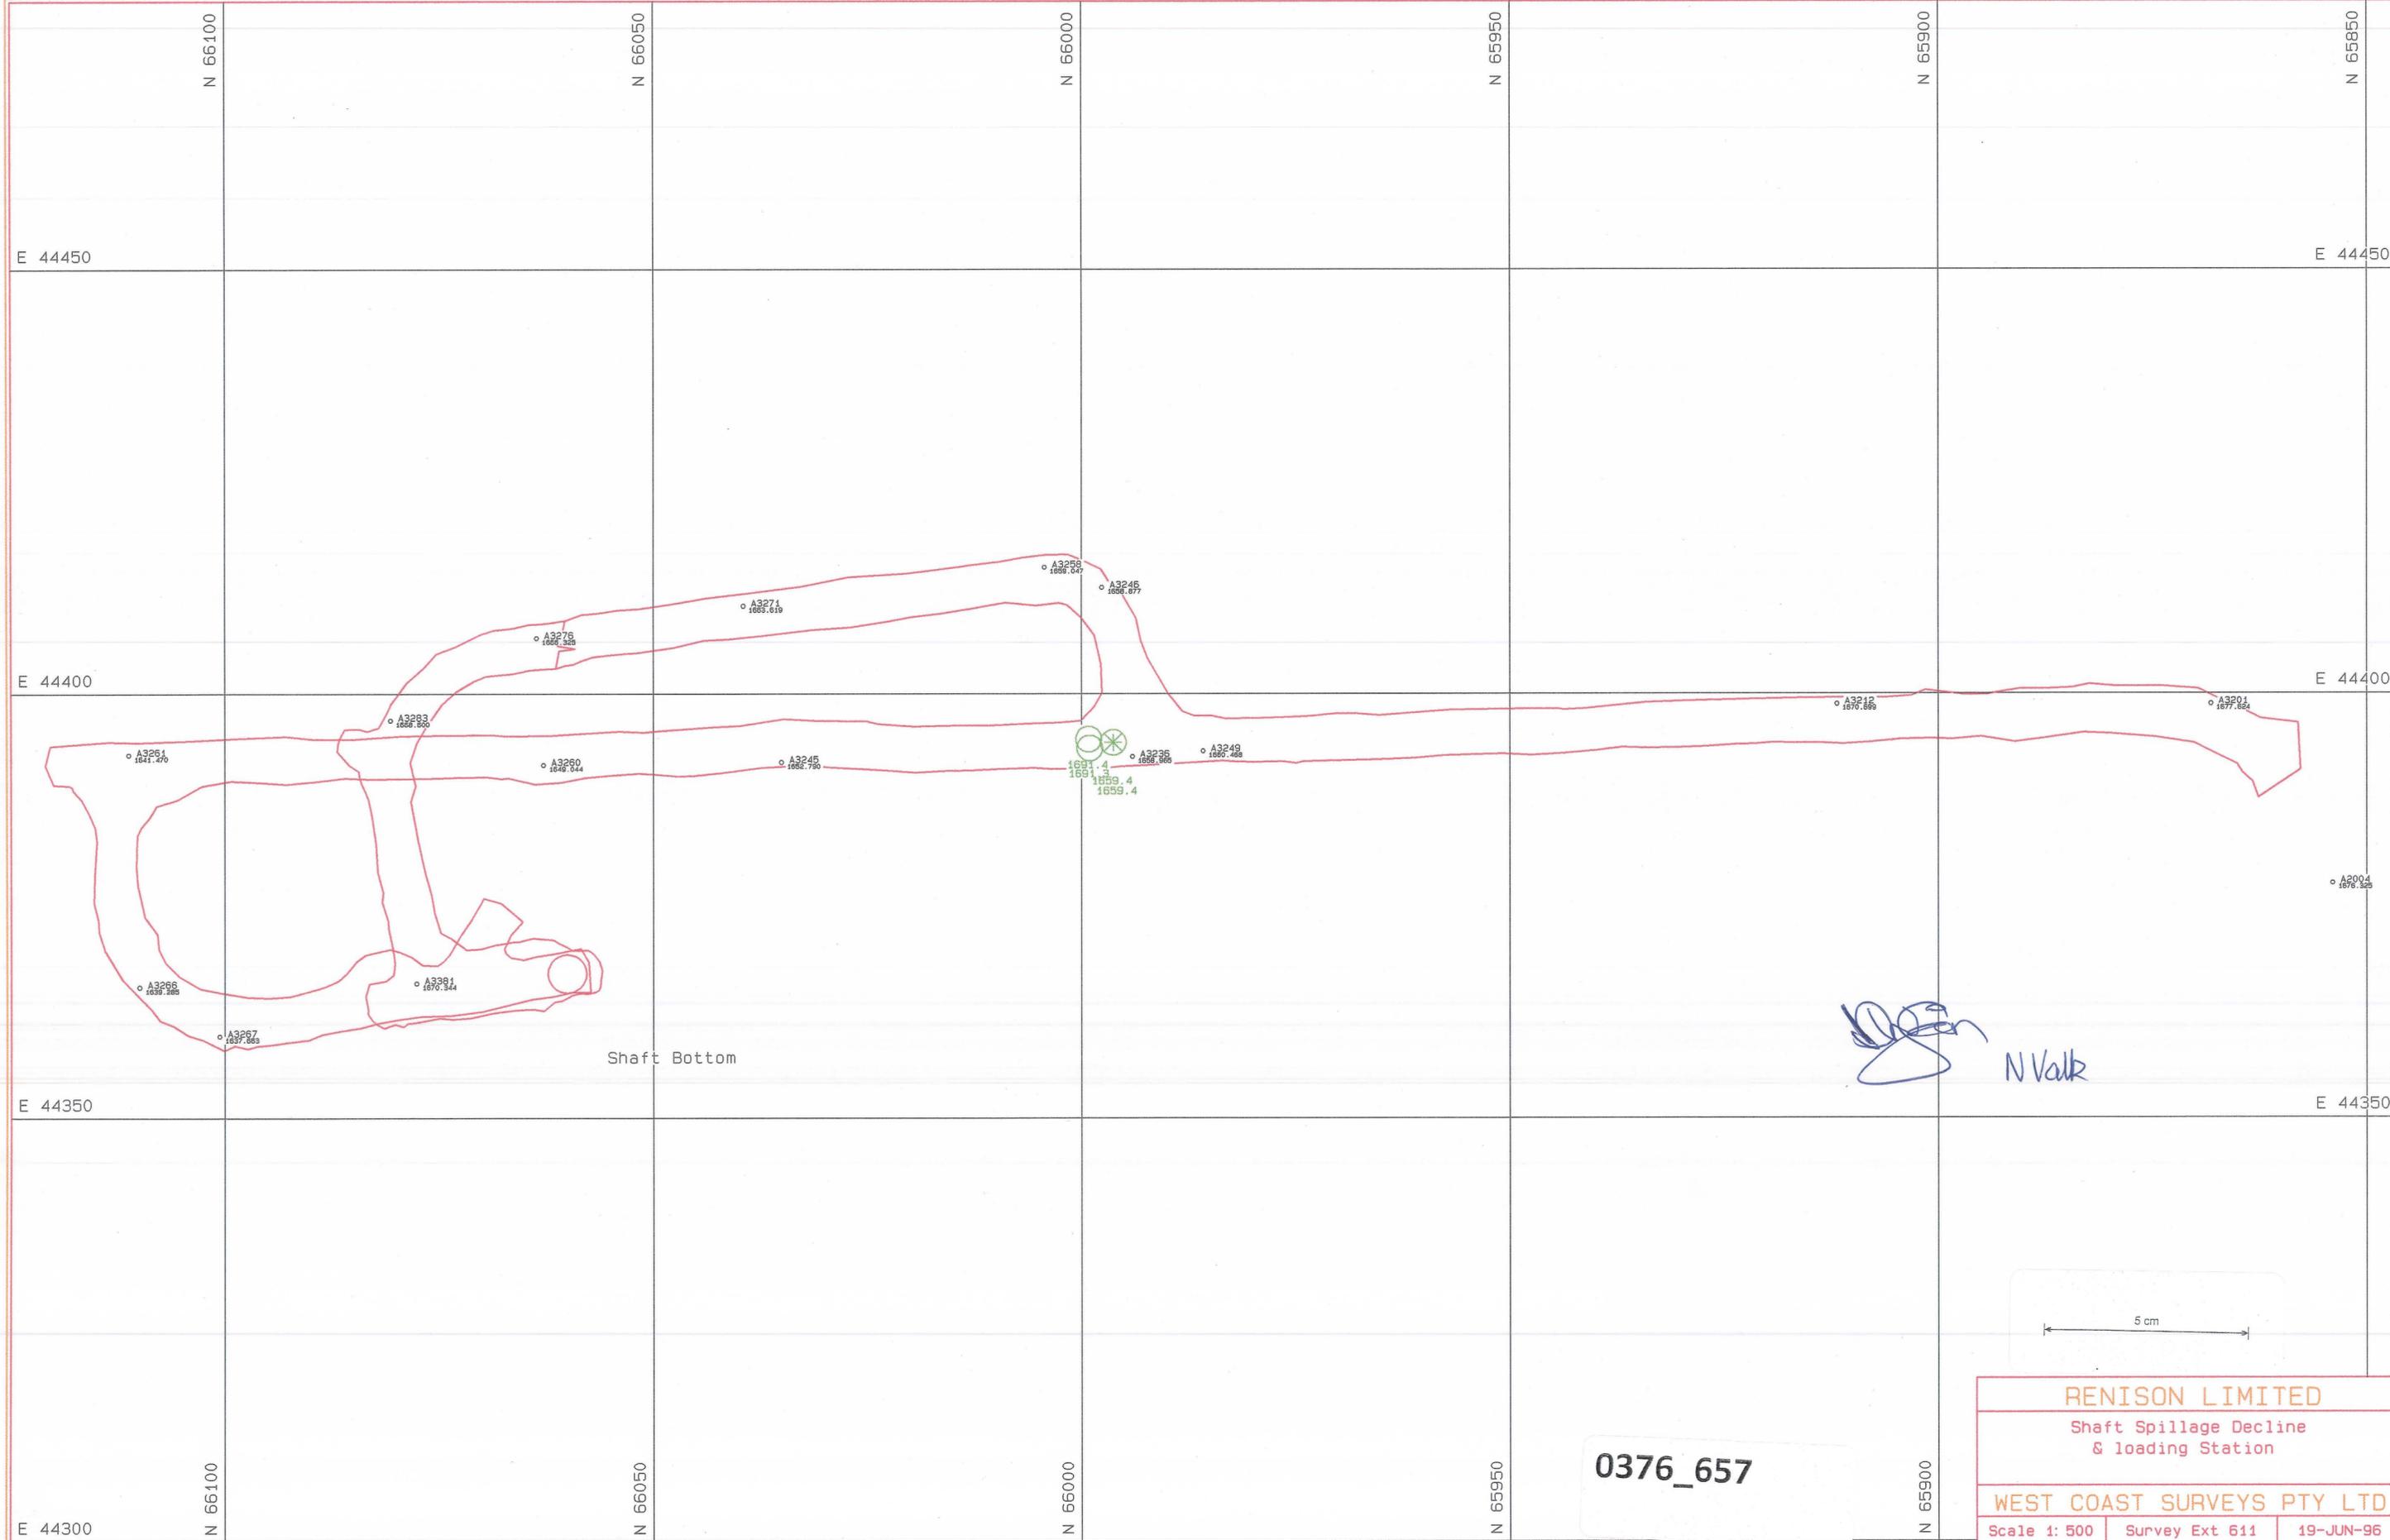

Shaft Bottom

N Valk

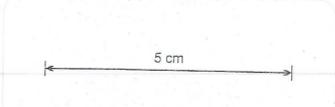

RENISON LIMITED		
Shaft Spillage Decline & loading Station		
WEST COAST SURVEYS PTY LTD		
Scale 1: 500	Survey Ext 611	19-JUN-96

0376_657

DEVMAG.PF