


0376_658

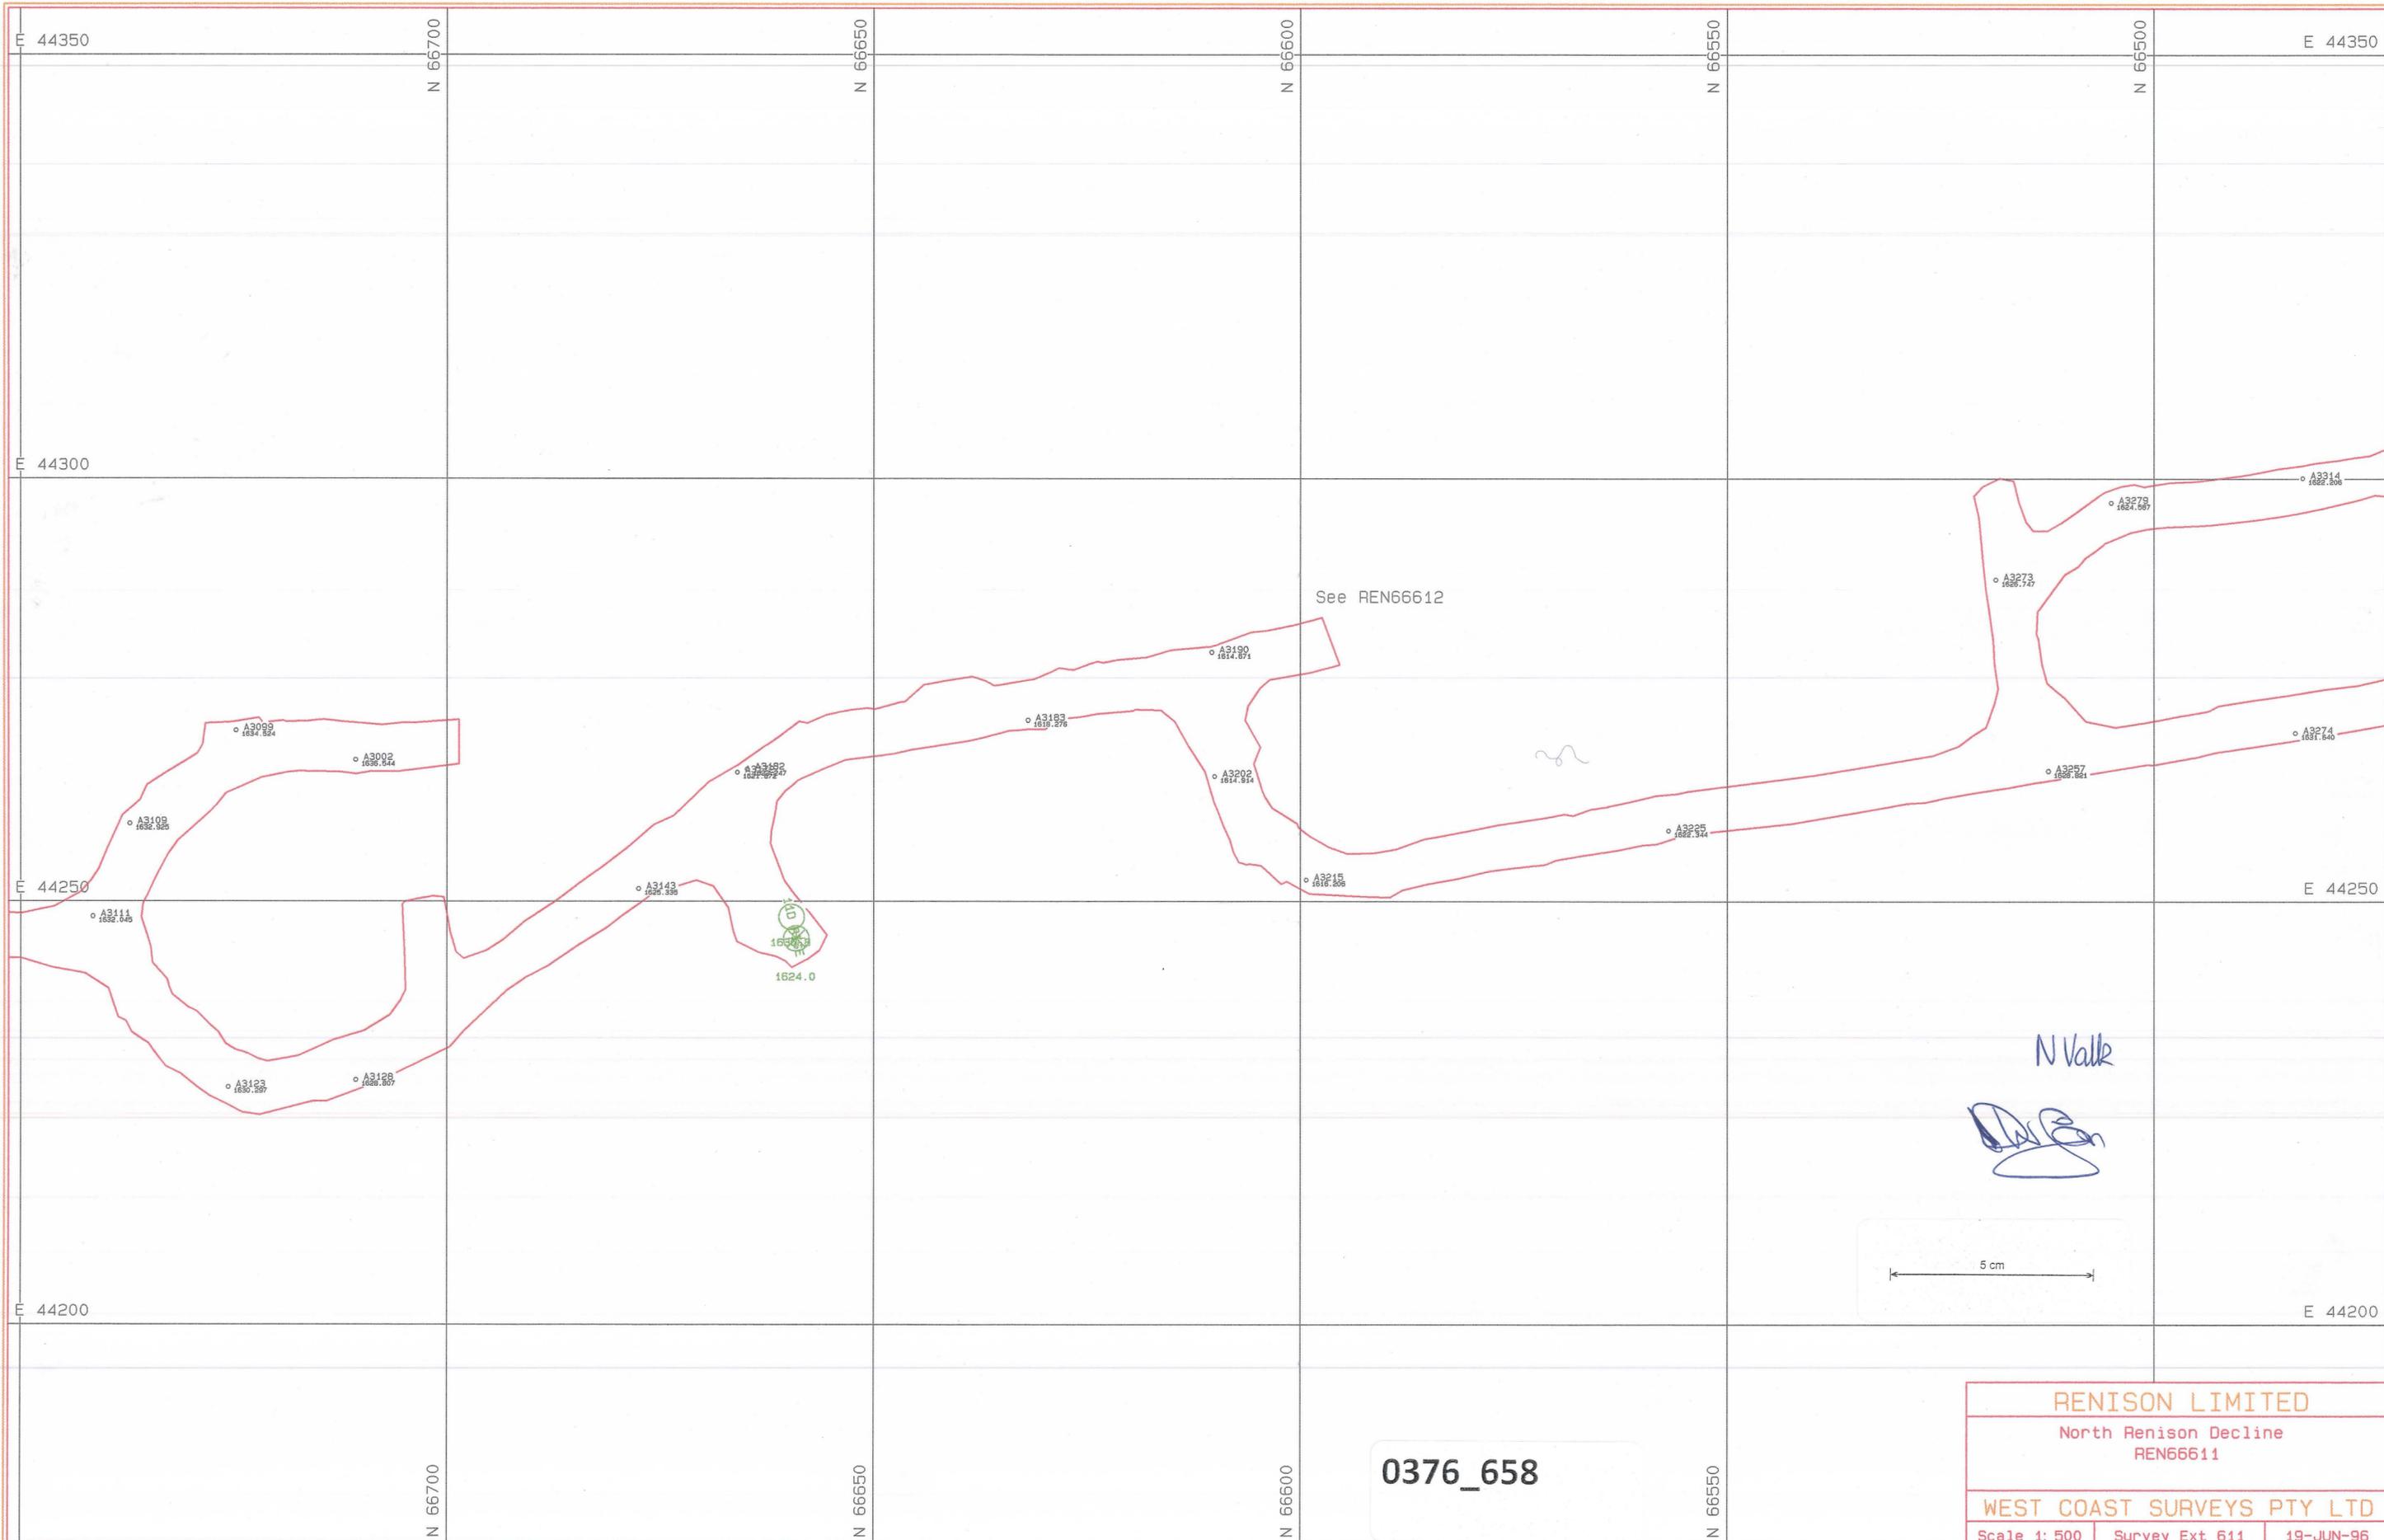

See REN66612

N Valk

[Handwritten Signature]



0376_658

RENISON LIMITED		
North Renison Decline REN66611		
WEST COAST SURVEYS PTY LTD		
Scale 1: 500	Survey Ext 611	19-JUN-96

DEWMAA.PF