


0376\_659

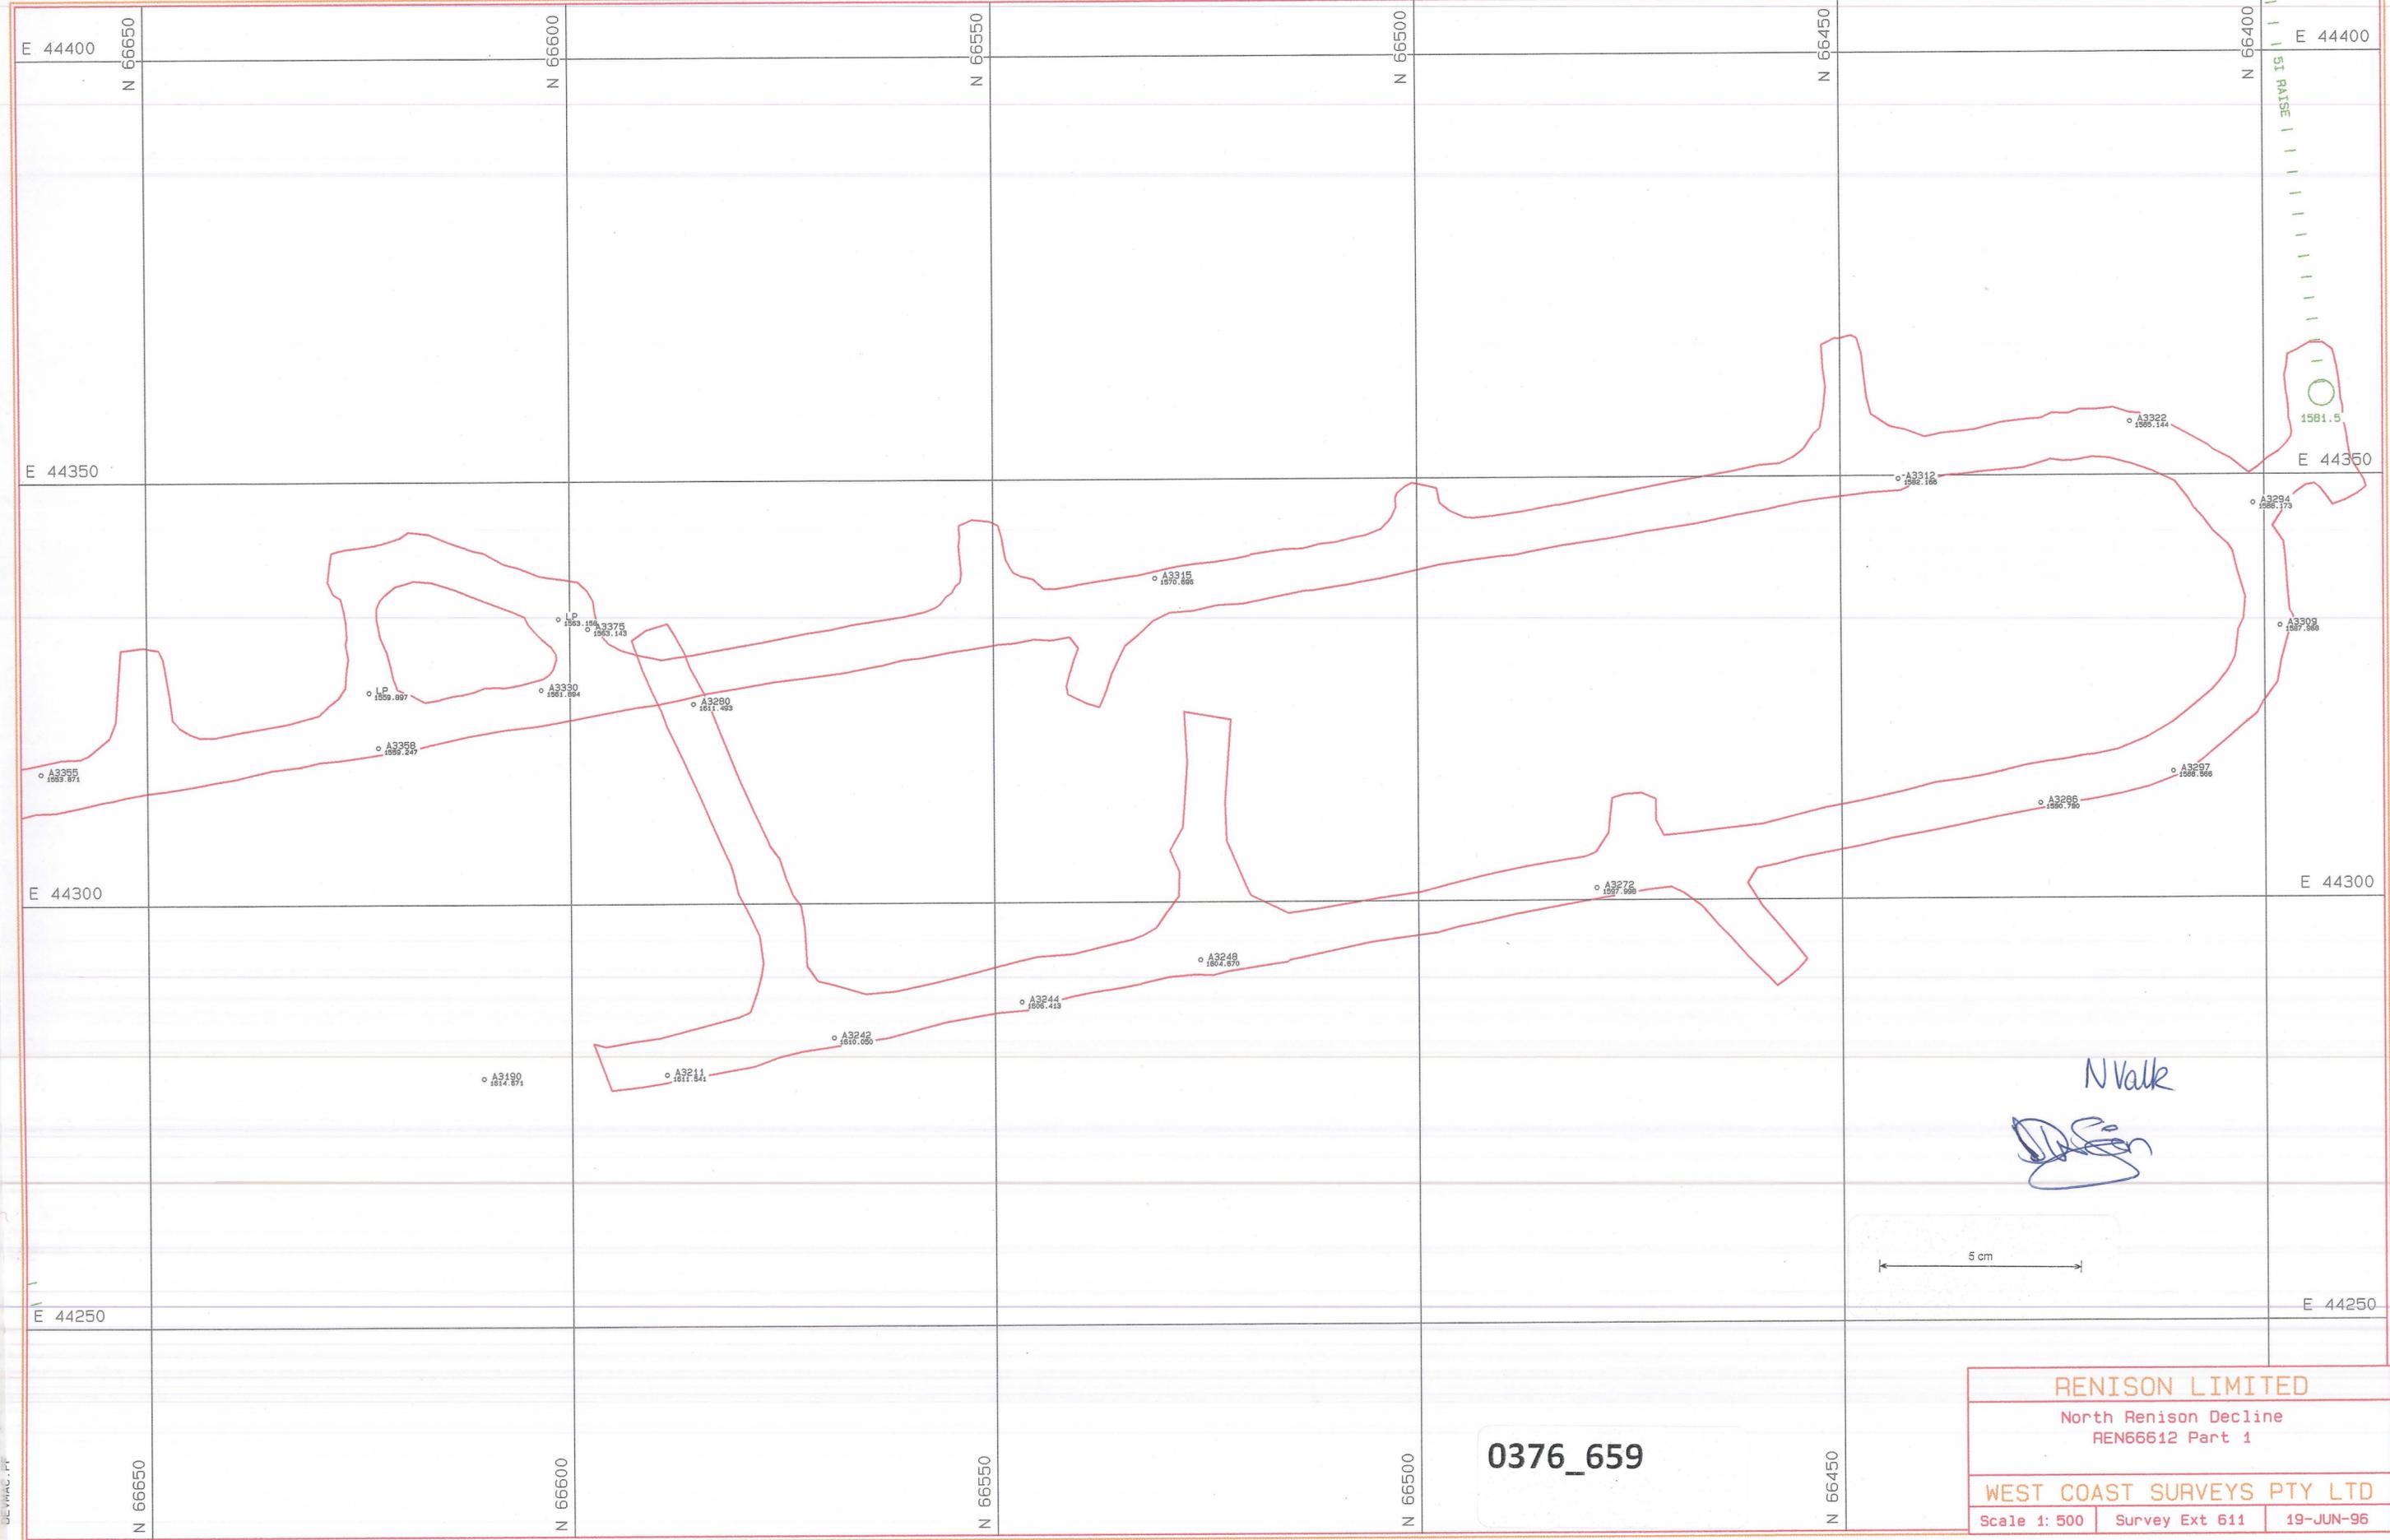

0376\_659

<b>RENISON LIMITED</b>		
North Renison Decline REN66612 Part 1		
<b>WEST COAST SURVEYS PTY LTD</b>		
Scale 1: 500	Survey Ext 611	19-JUN-96