


0376_660

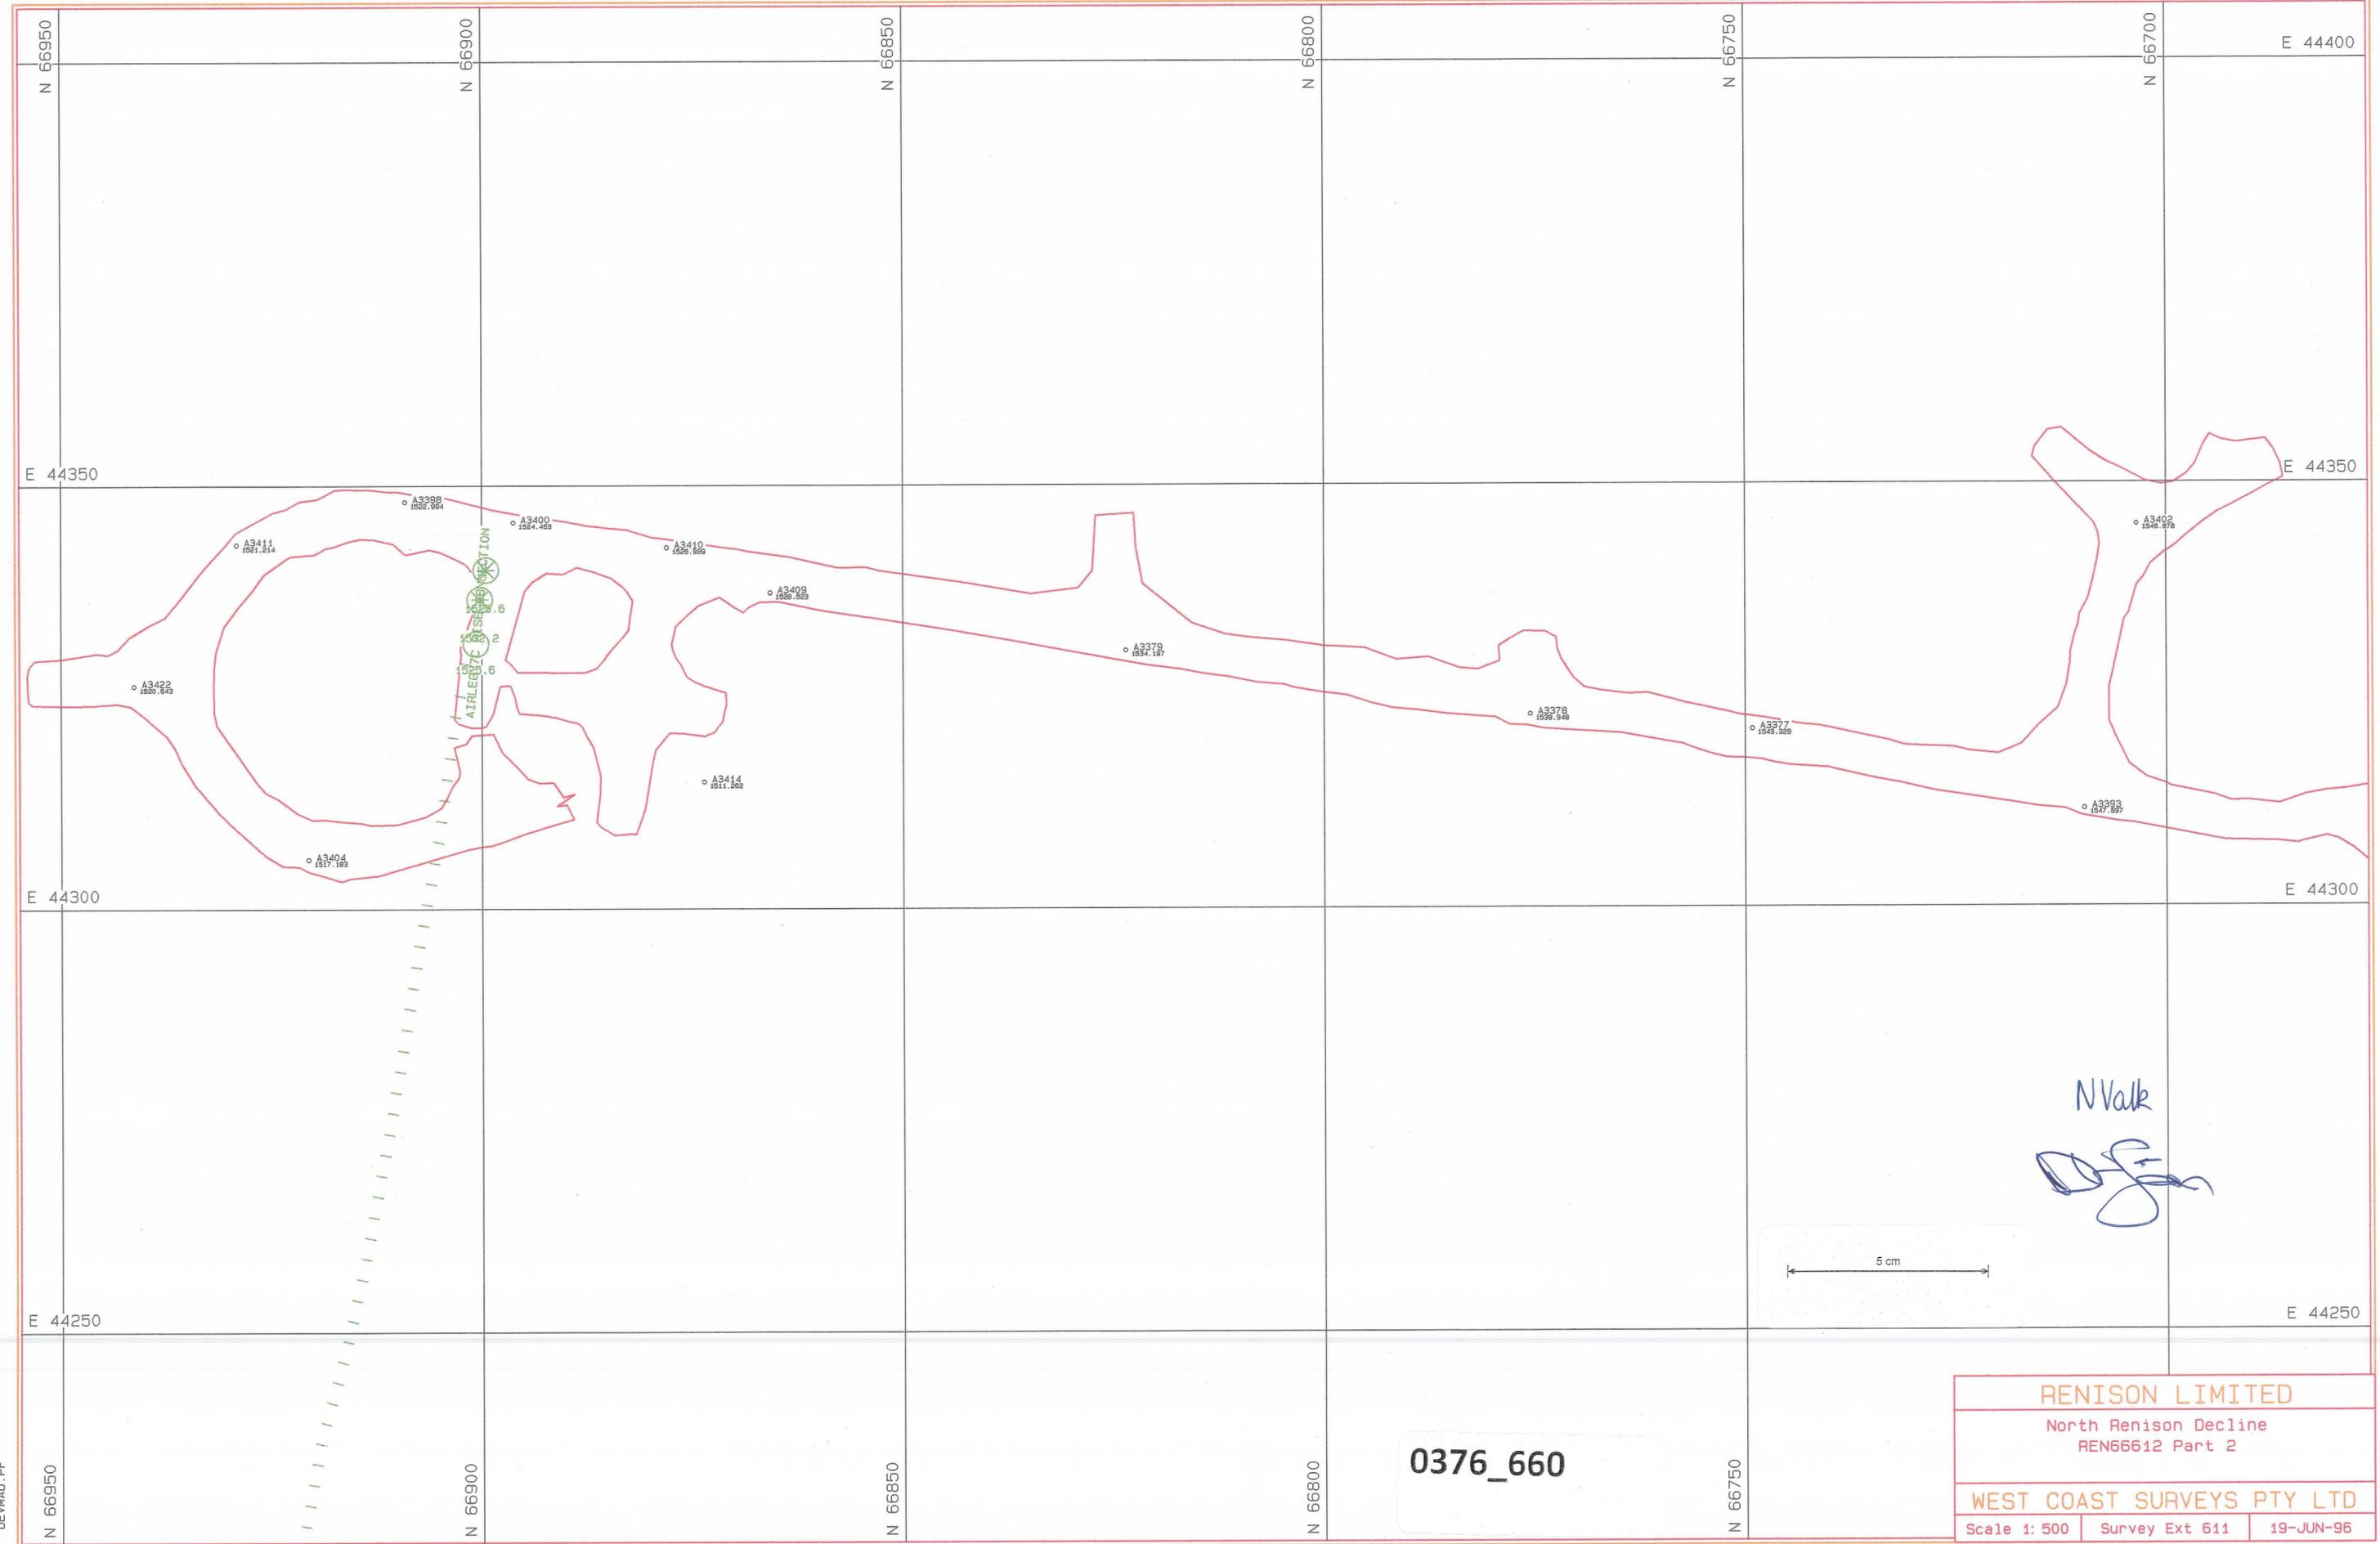

0376_660

RENISON LIMITED		
North Renison Decline REN66612 Part 2		
WEST COAST SURVEYS PTY LTD		
Scale 1: 500	Survey Ext 611	19-JUN-96

DEVMAD.PF