


0376_661

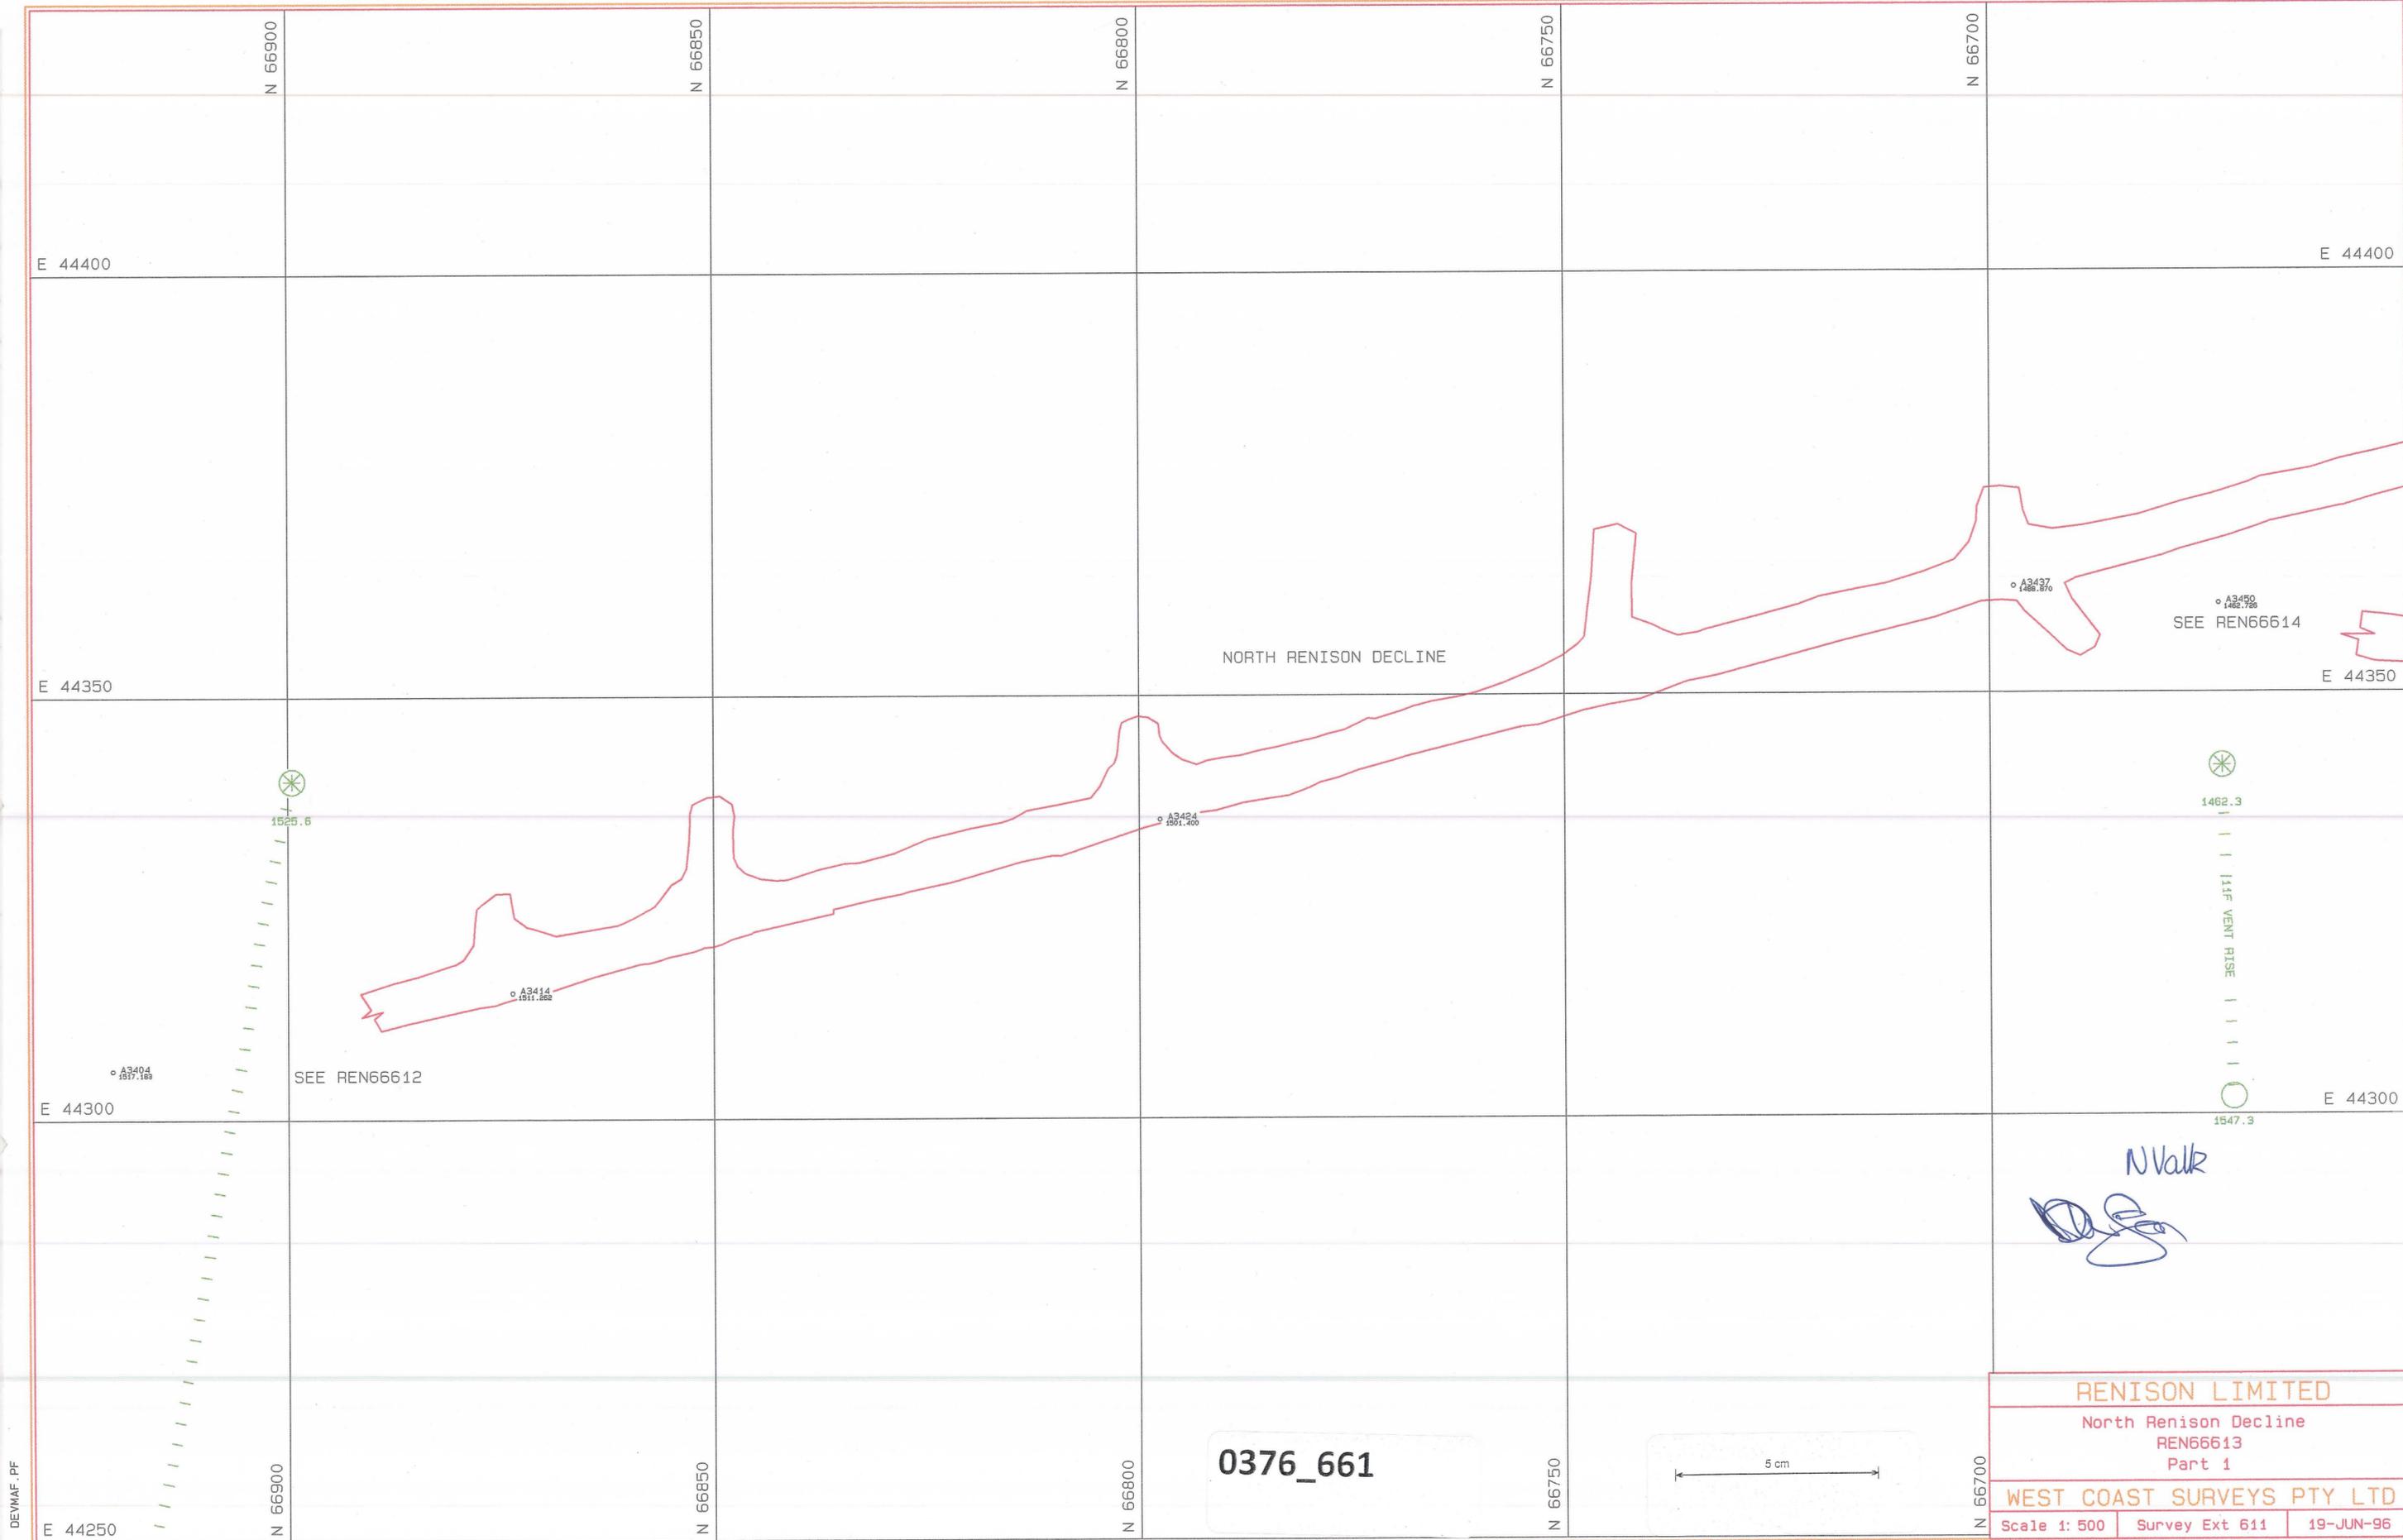

0376_661

RENISON LIMITED		
North Renison Decline REN66613 Part 1		
WEST COAST SURVEYS PTY LTD		
Scale 1: 500	Survey Ext 611	19-JUN-96

DEWAF.PF