


0376_662



N Valk

0376_662

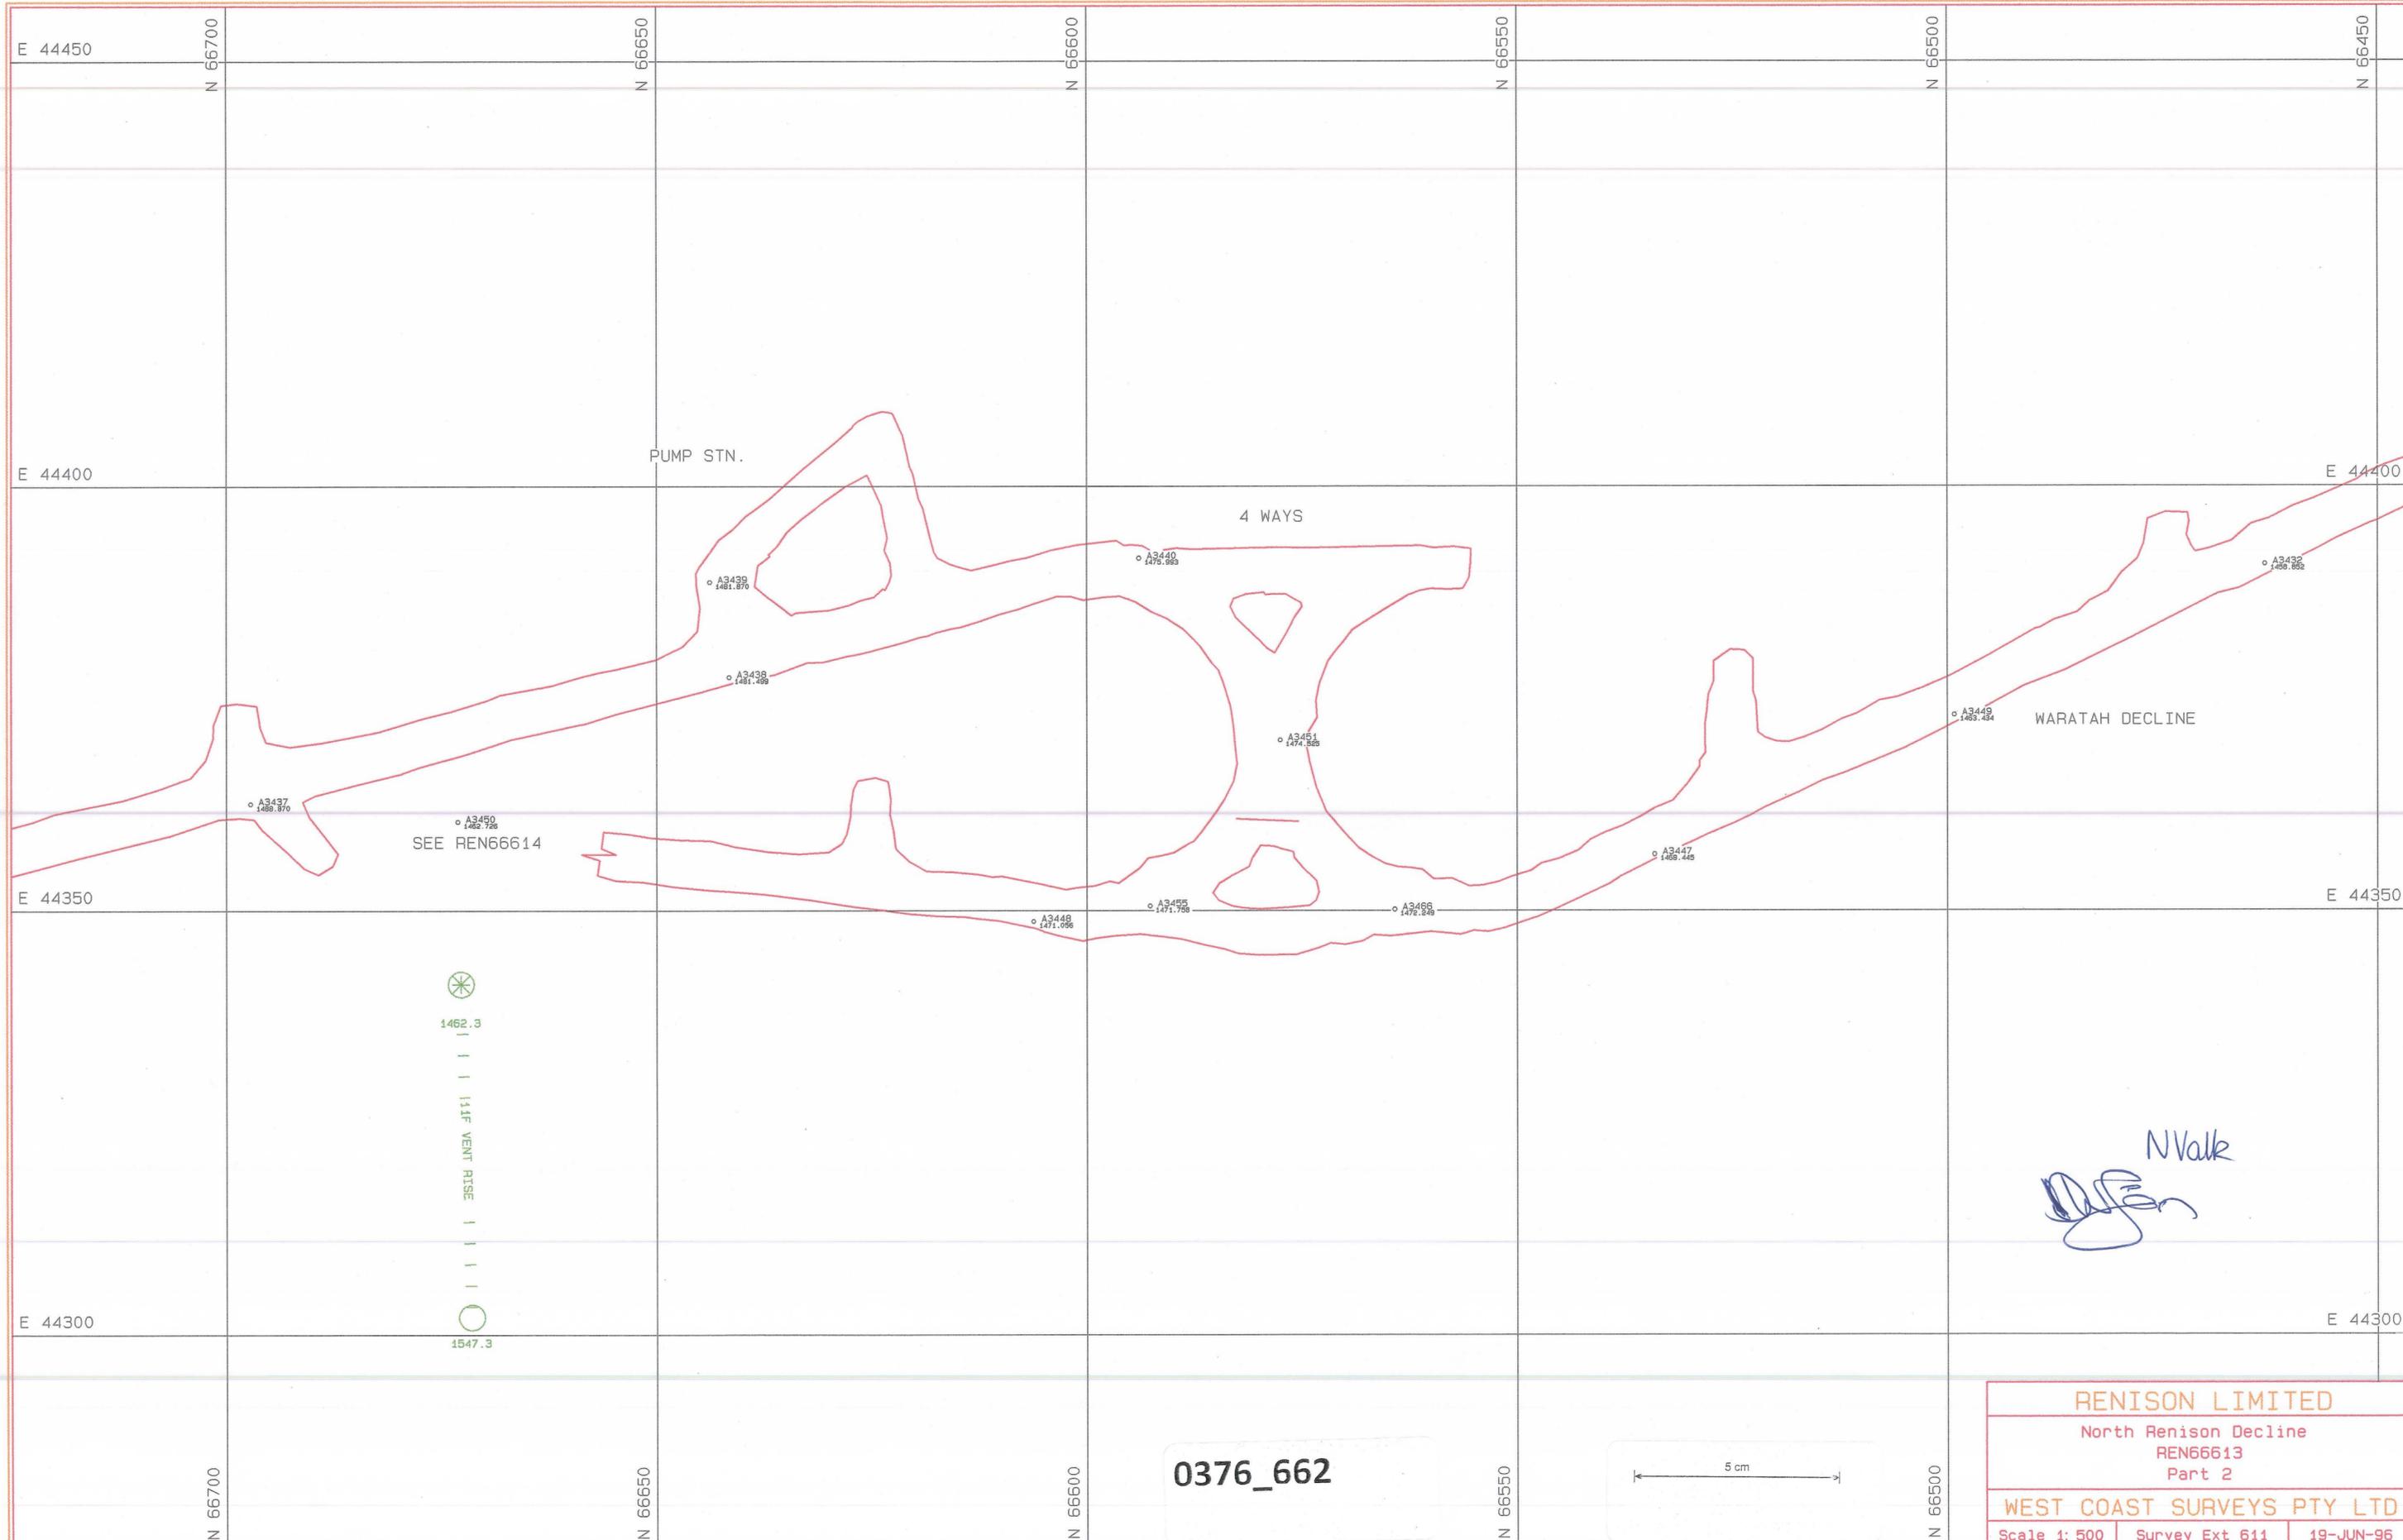

RENISON LIMITED		
North Renison Decline REN66613 Part 2		
WEST COAST SURVEYS PTY LTD		
Scale 1: 500	Survey Ext 611	19-JUN-96

DEVNAT.PF