


0376\_663

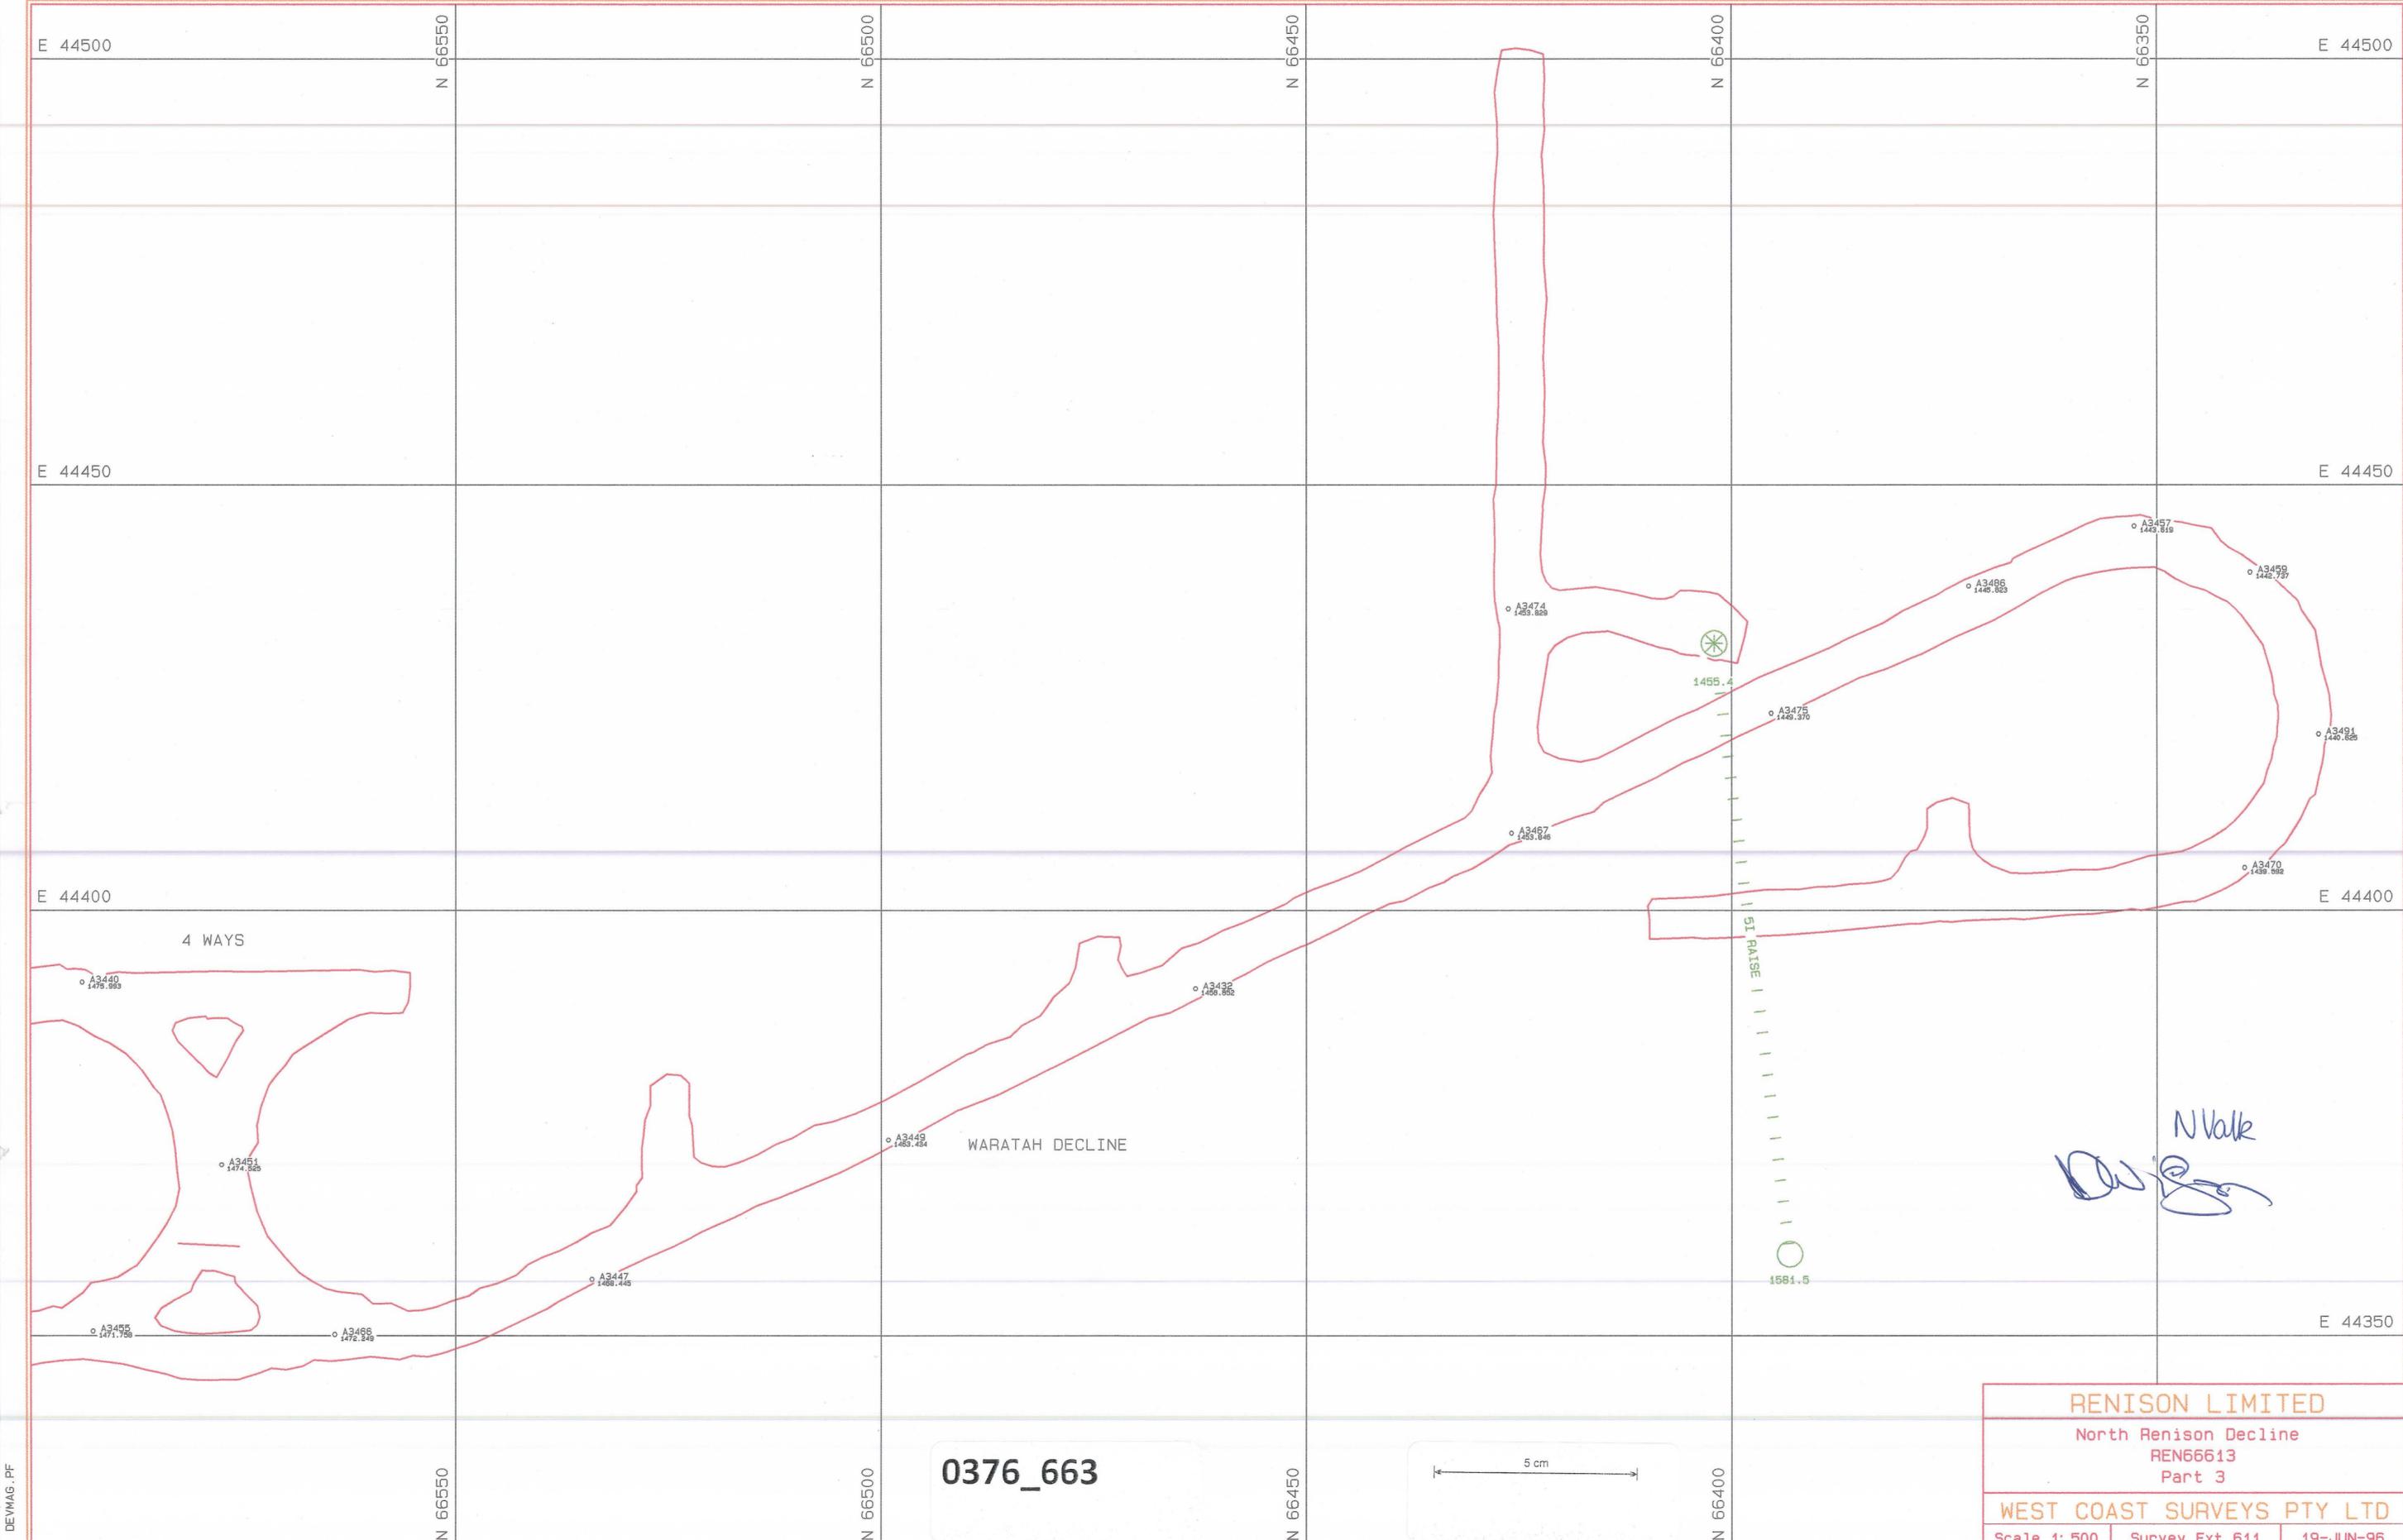

0376\_663

|   |                |           |
|---|----------------|-----------|
| <b>RENISON LIMITED</b>                      |                |           |
| North Renison Decline<br>REN66613<br>Part 3 |                |           |
| <b>WEST COAST SURVEYS PTY LTD</b>           |                |           |
| Scale 1: 500                                | Survey Ext 611 | 19-JUN-96 |

DEVIMAG.PF