


0376_664

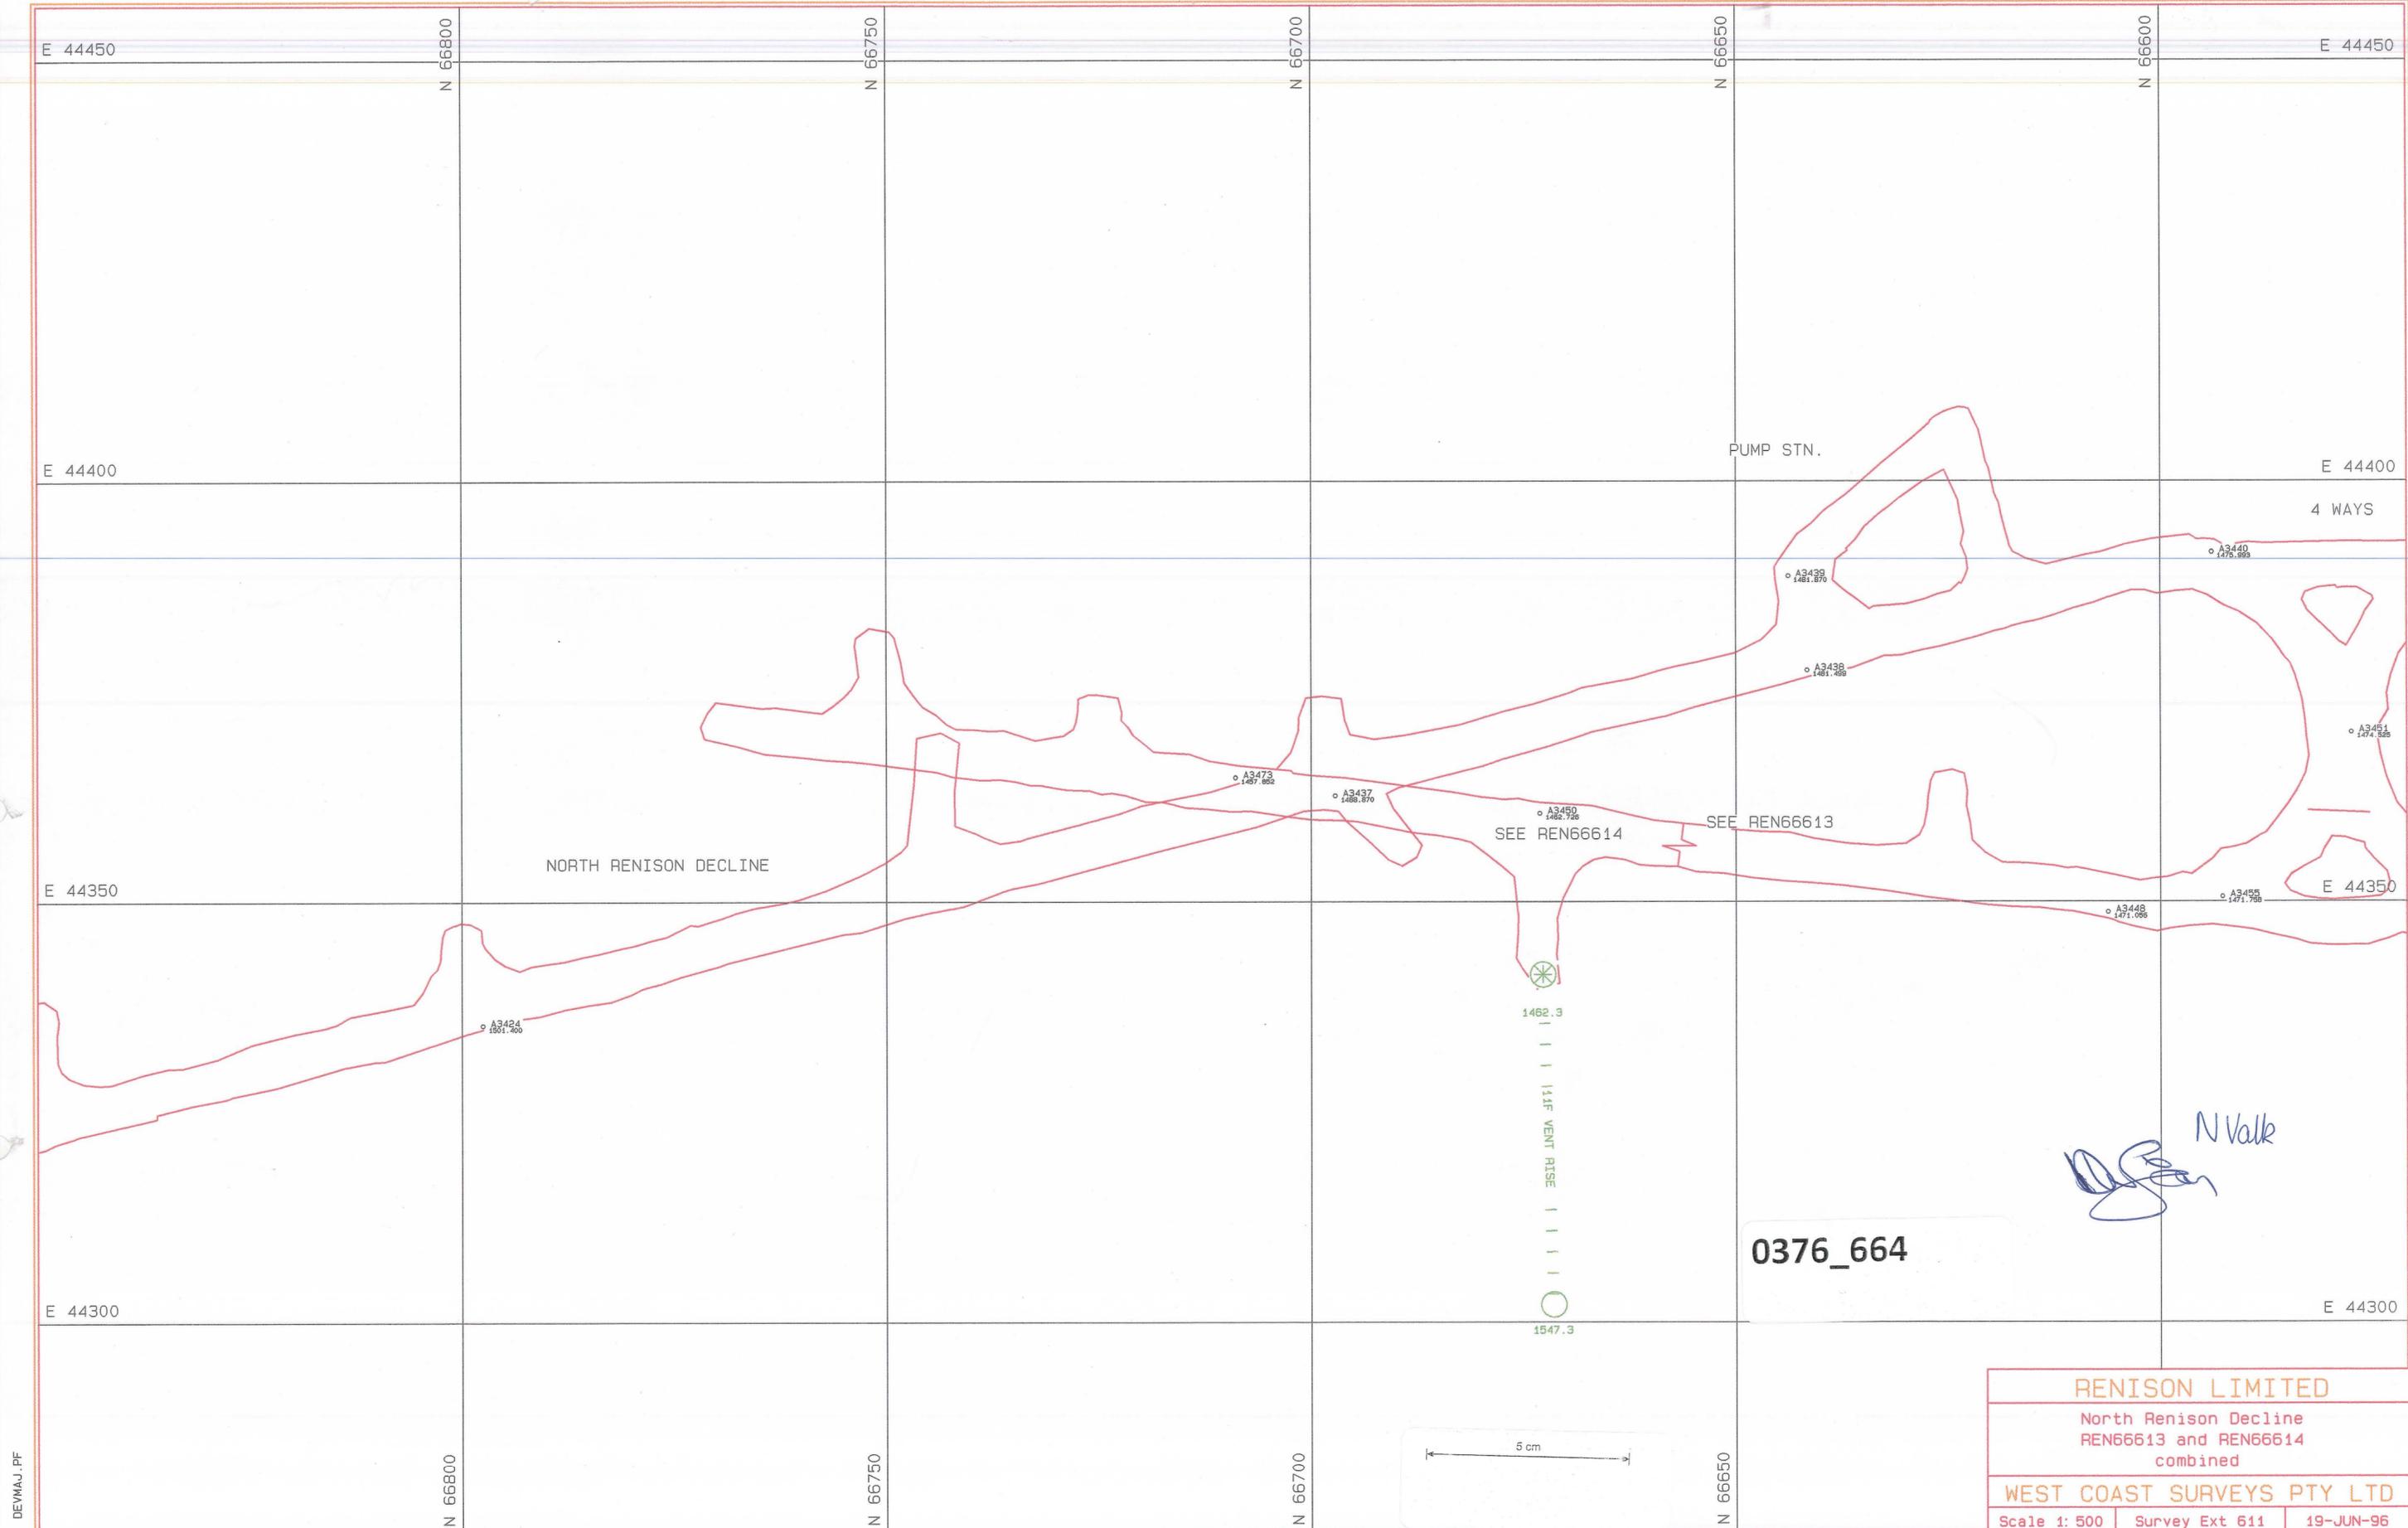

0376_664

N Valk
[Signature]

RENISON LIMITED		
North Renison Decline REN66613 and REN66614 combined		
WEST COAST SURVEYS PTY LTD		
Scale 1: 500	Survey Ext 611	19-JUN-96

DEVMAJ.PF