


0376_665

0376_665

AS CONSTRUCTED

CERTIFIED *Glenn*

DATE *6/8/97*

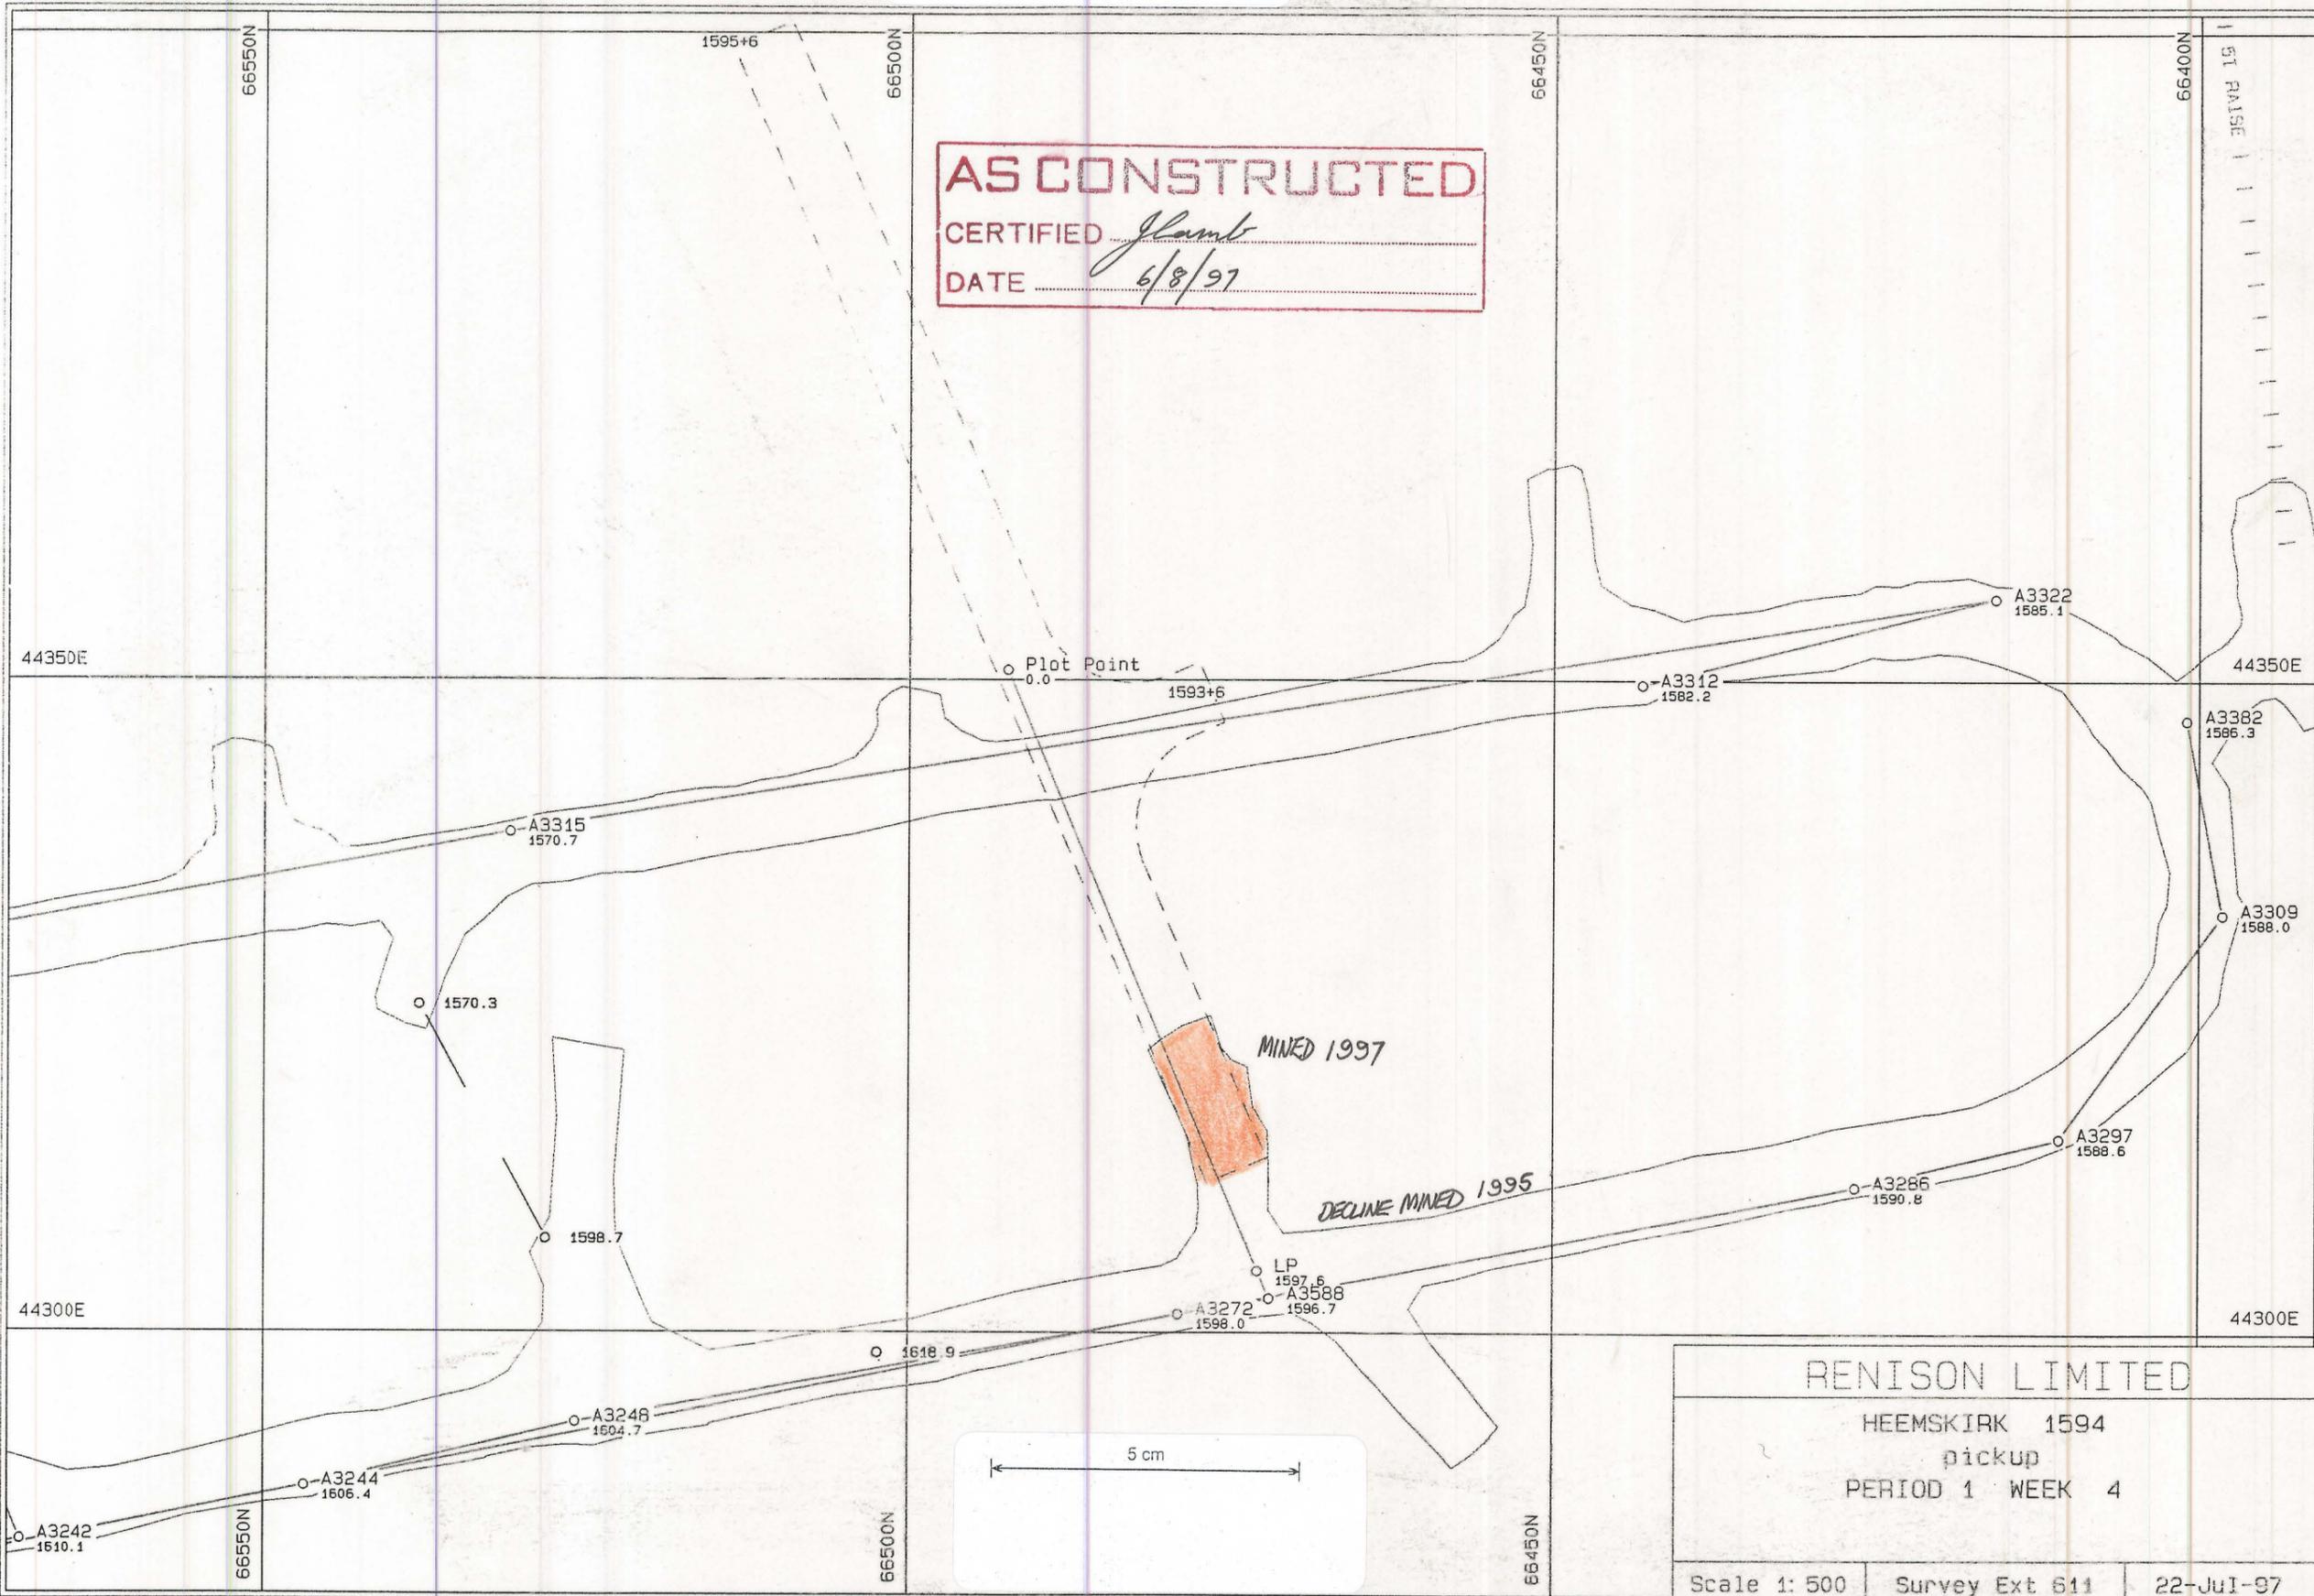

heemskia.pf