


APPROVAL ONLY

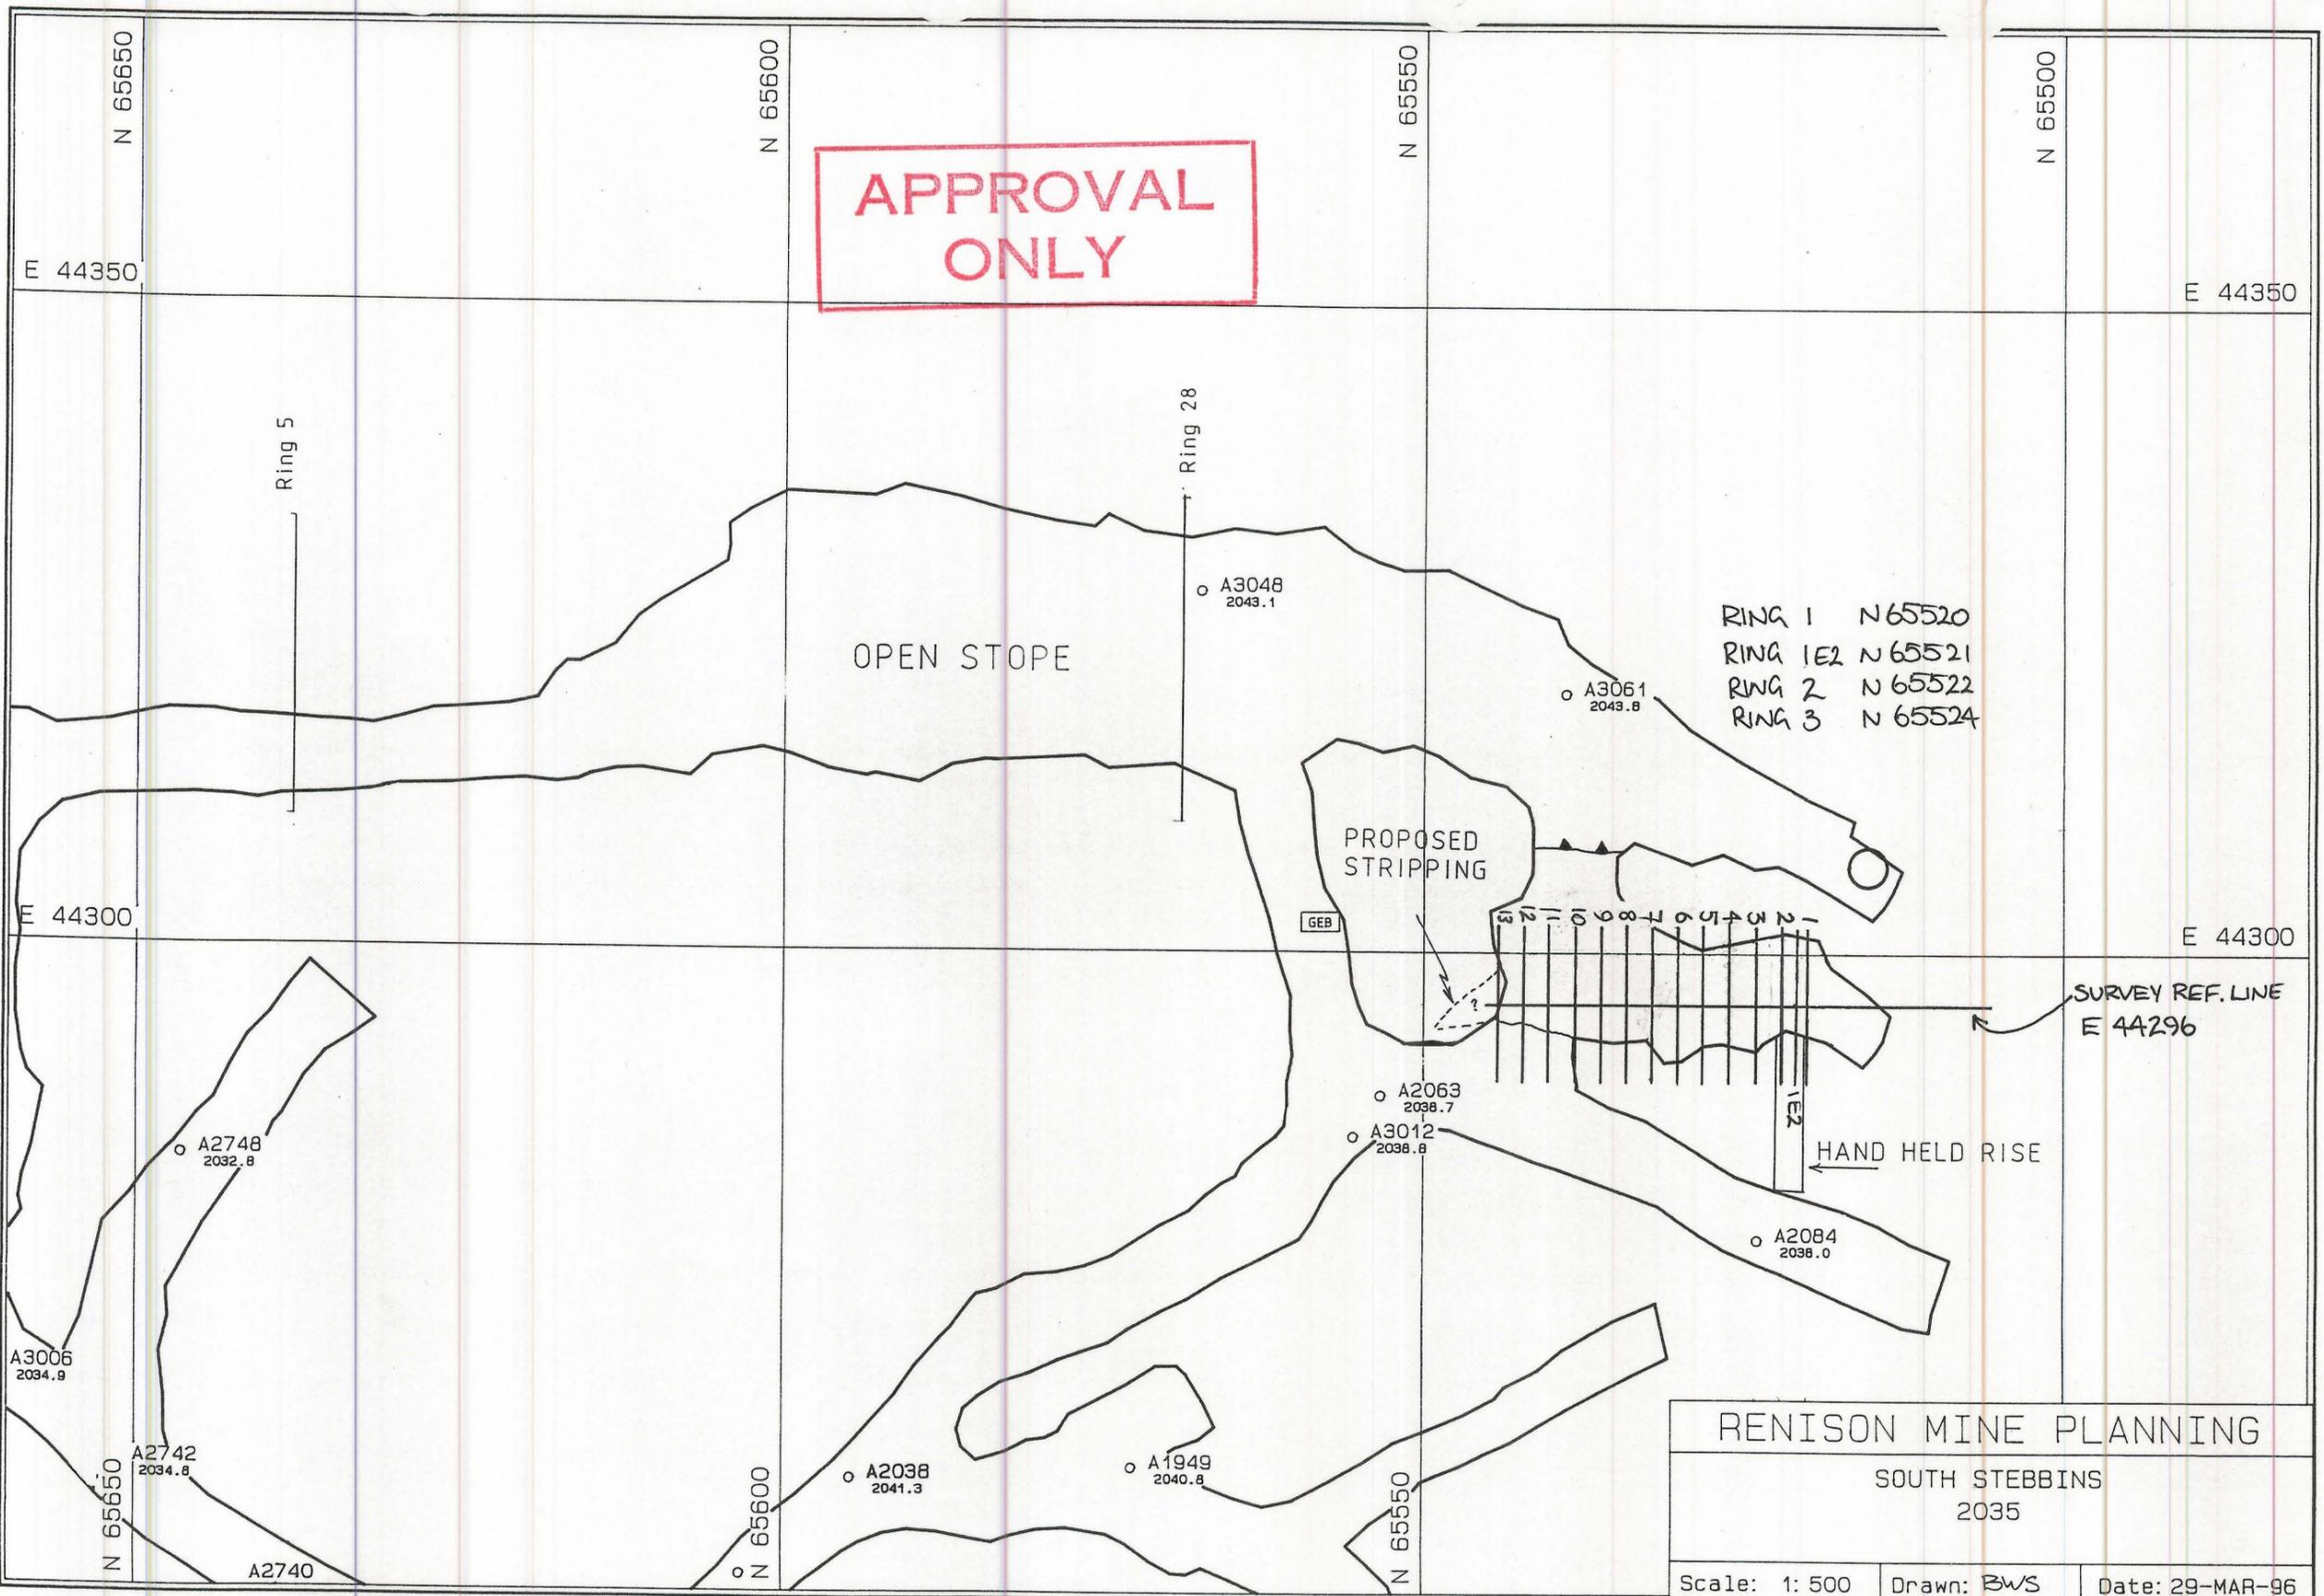

RING 1 N 65520
 RING 1E2 N 65521
 RING 2 N 65522
 RING 3 N 65524

RENISON MINE PLANNING		
SOUTH STEBBINS 2035		
Scale: 1: 500	Drawn: BWS	Date: 29-MAR-96

5 cm