


0376_669



PLANE .PF

0376_669

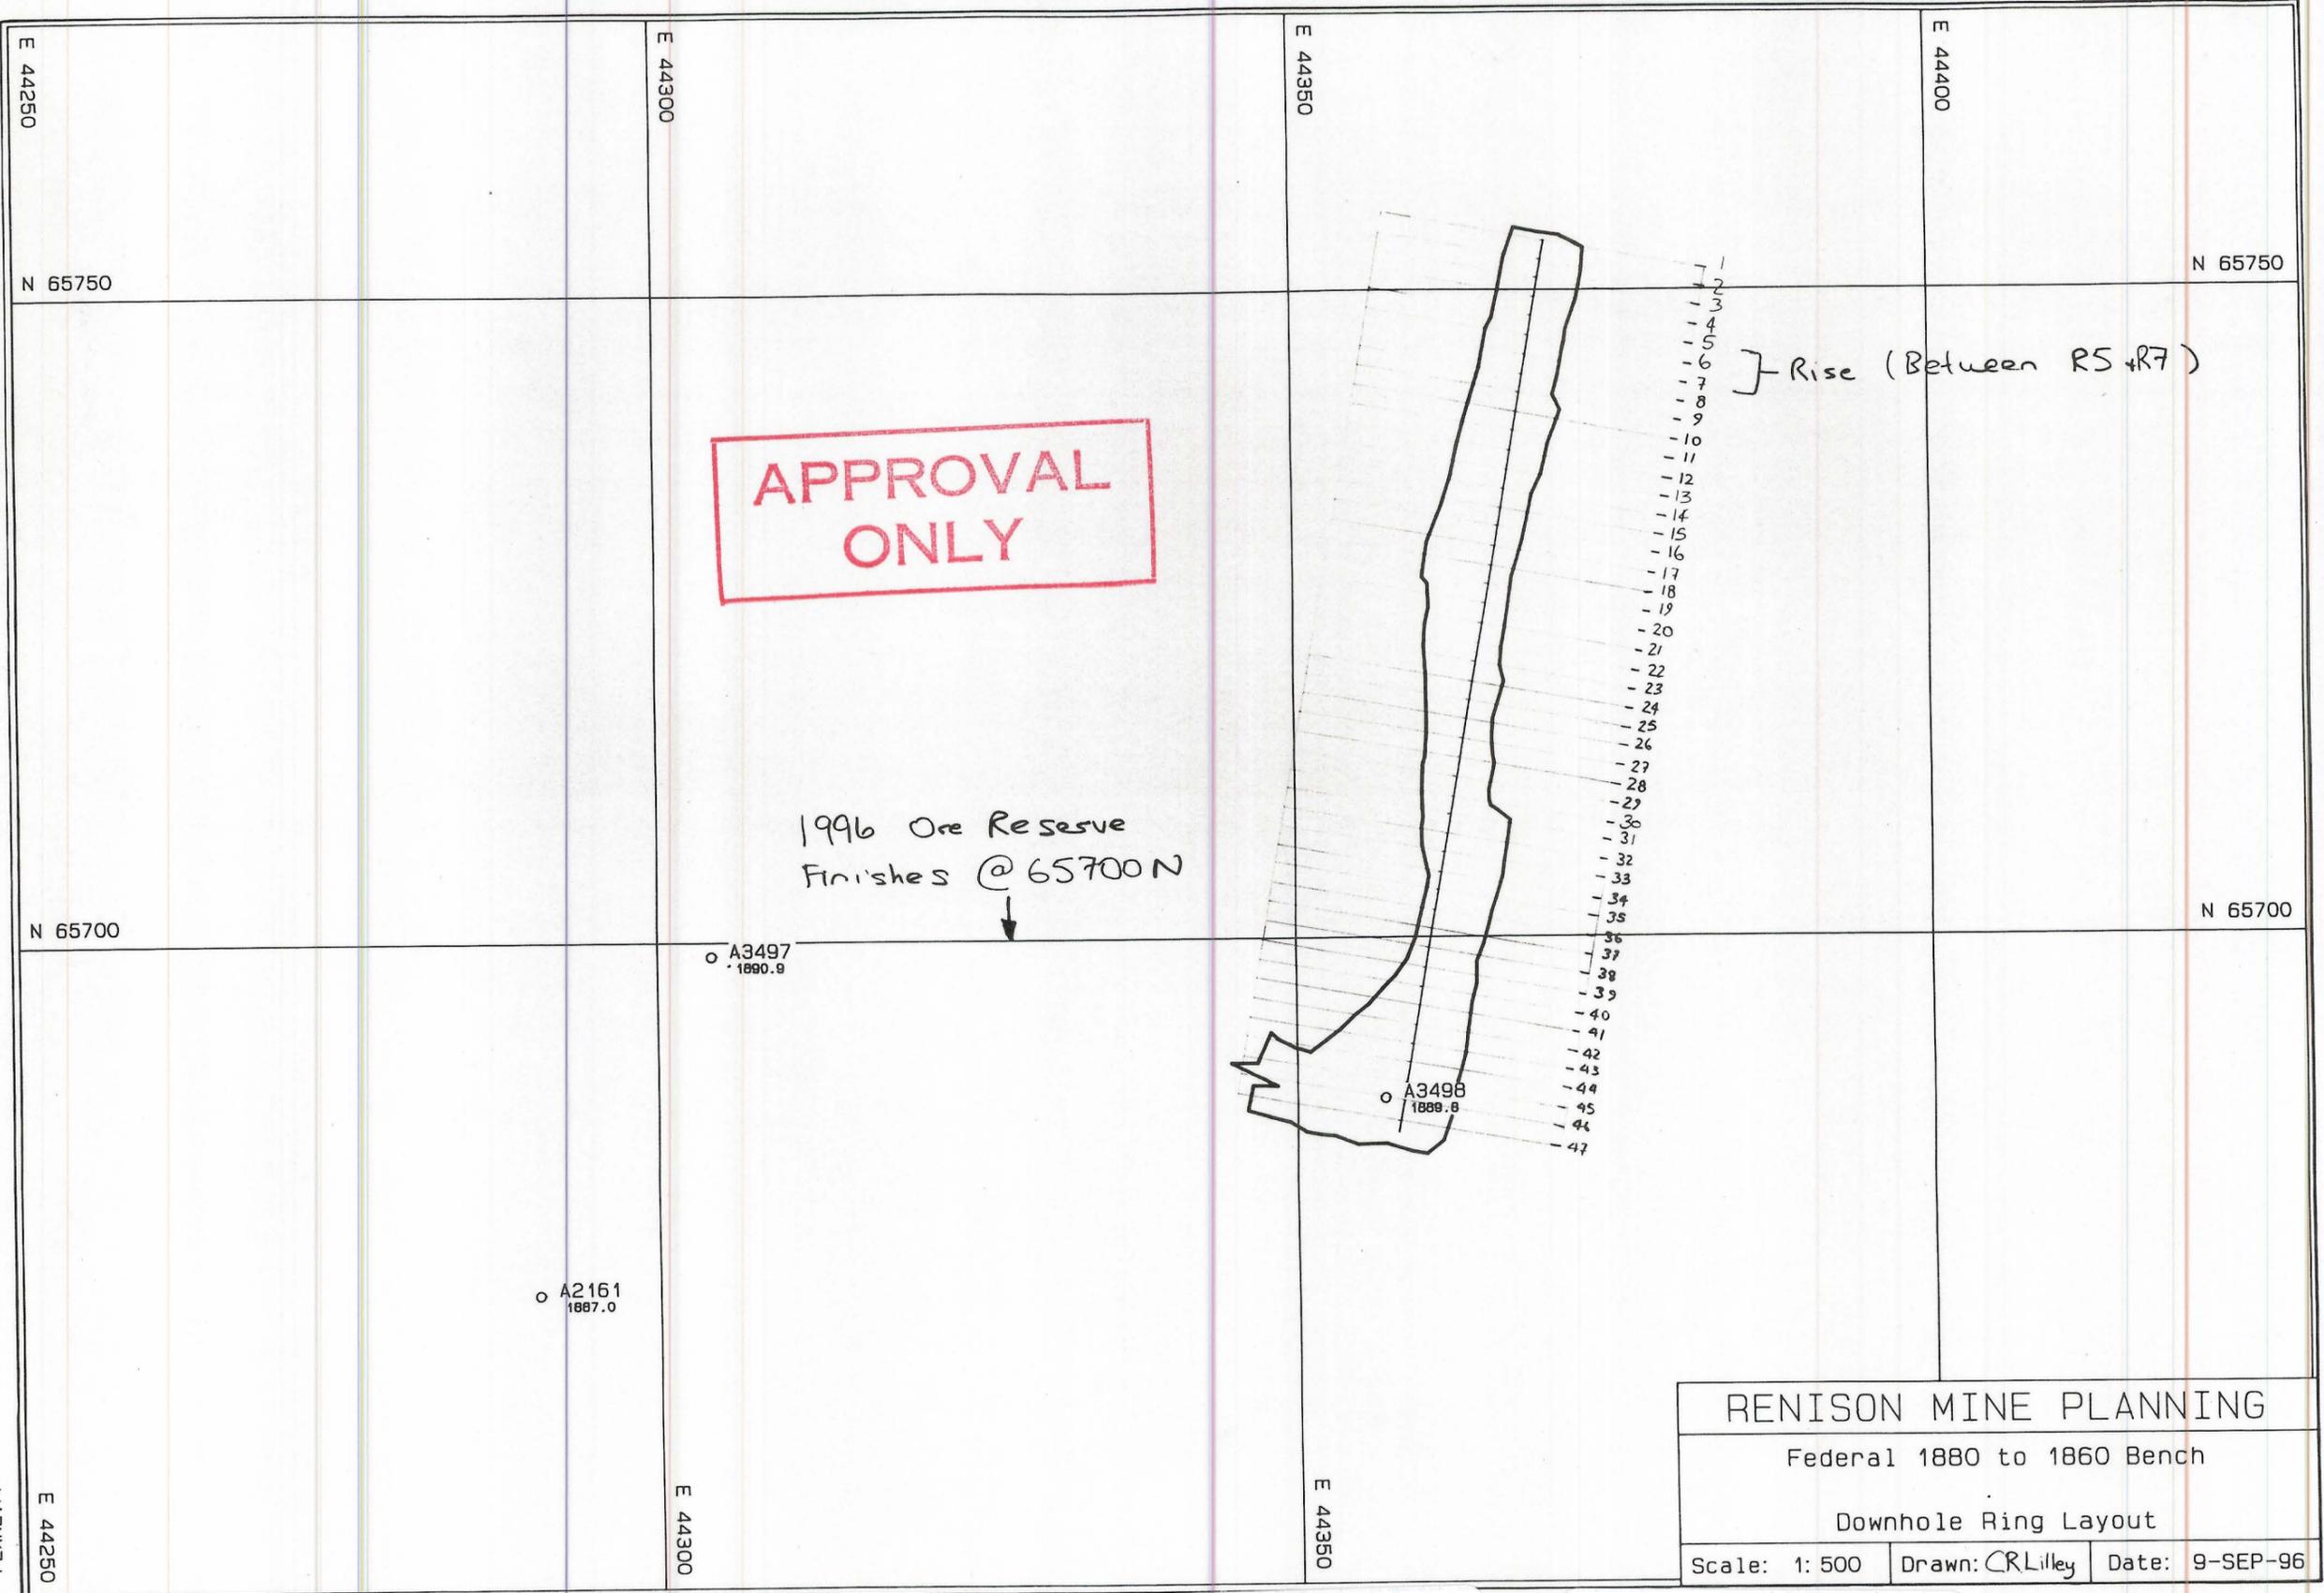