


0376\_675

APPROVAL ONLY

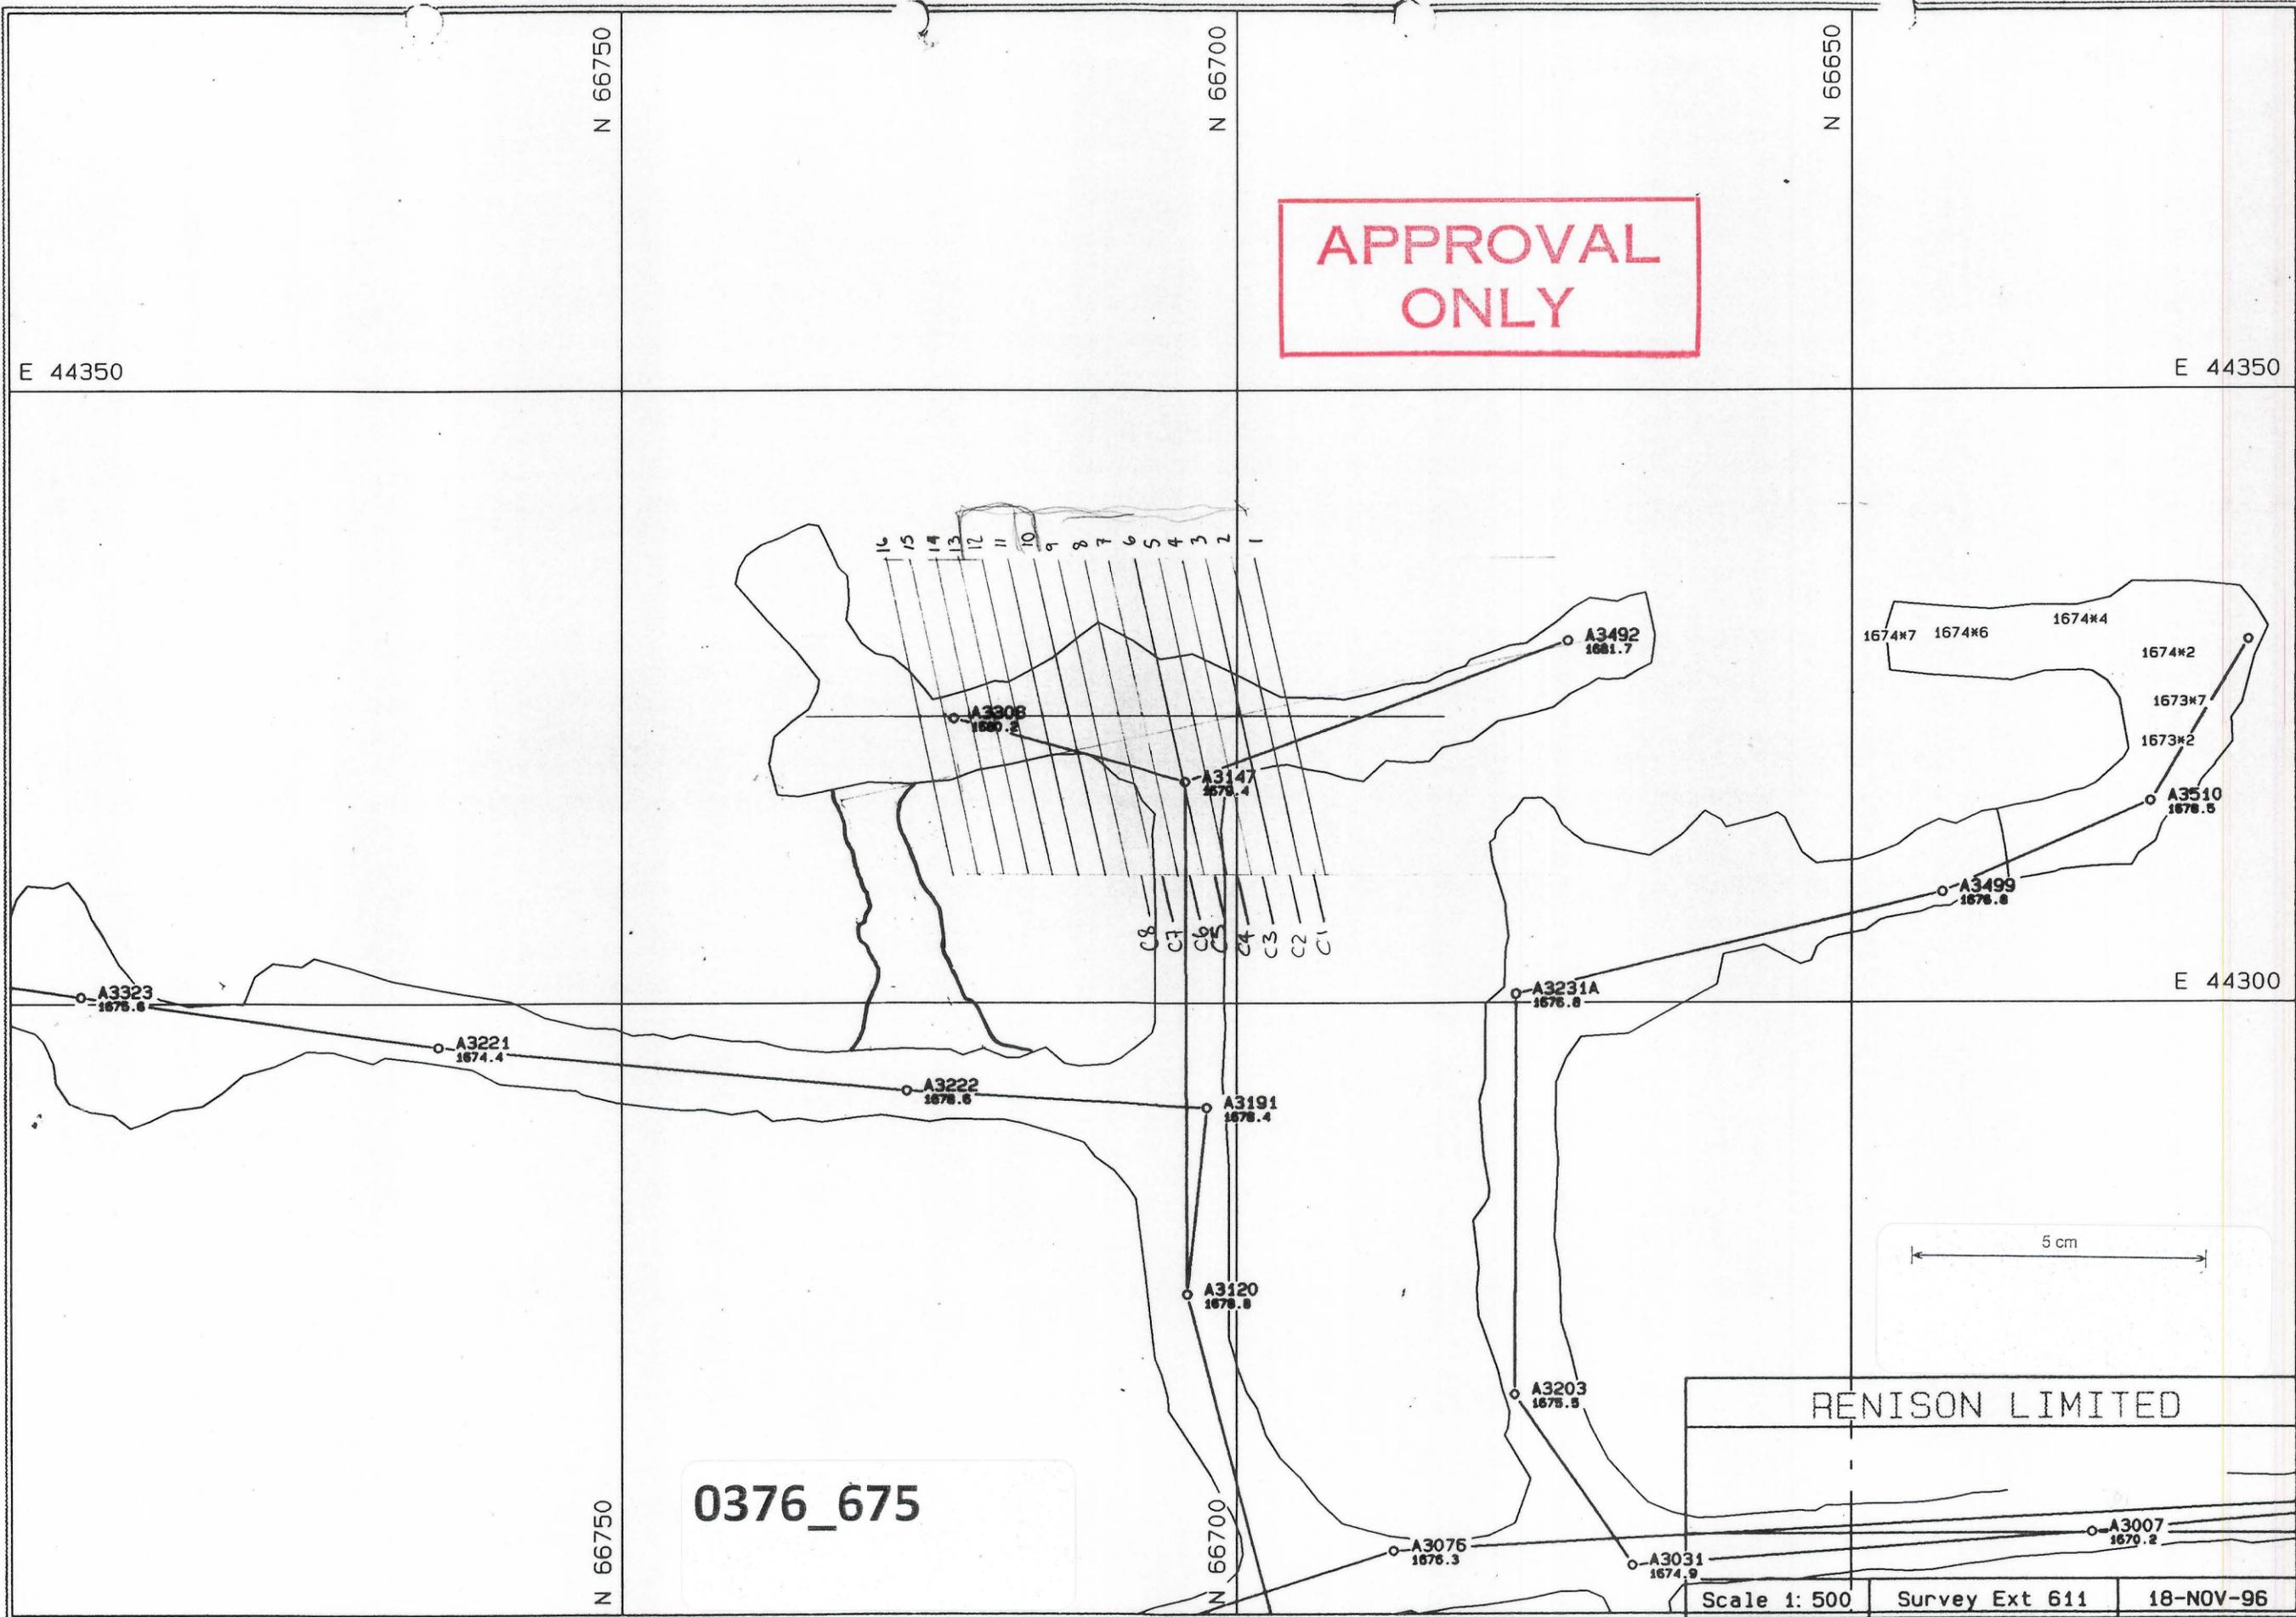

BLACKG.PF