


0376_676

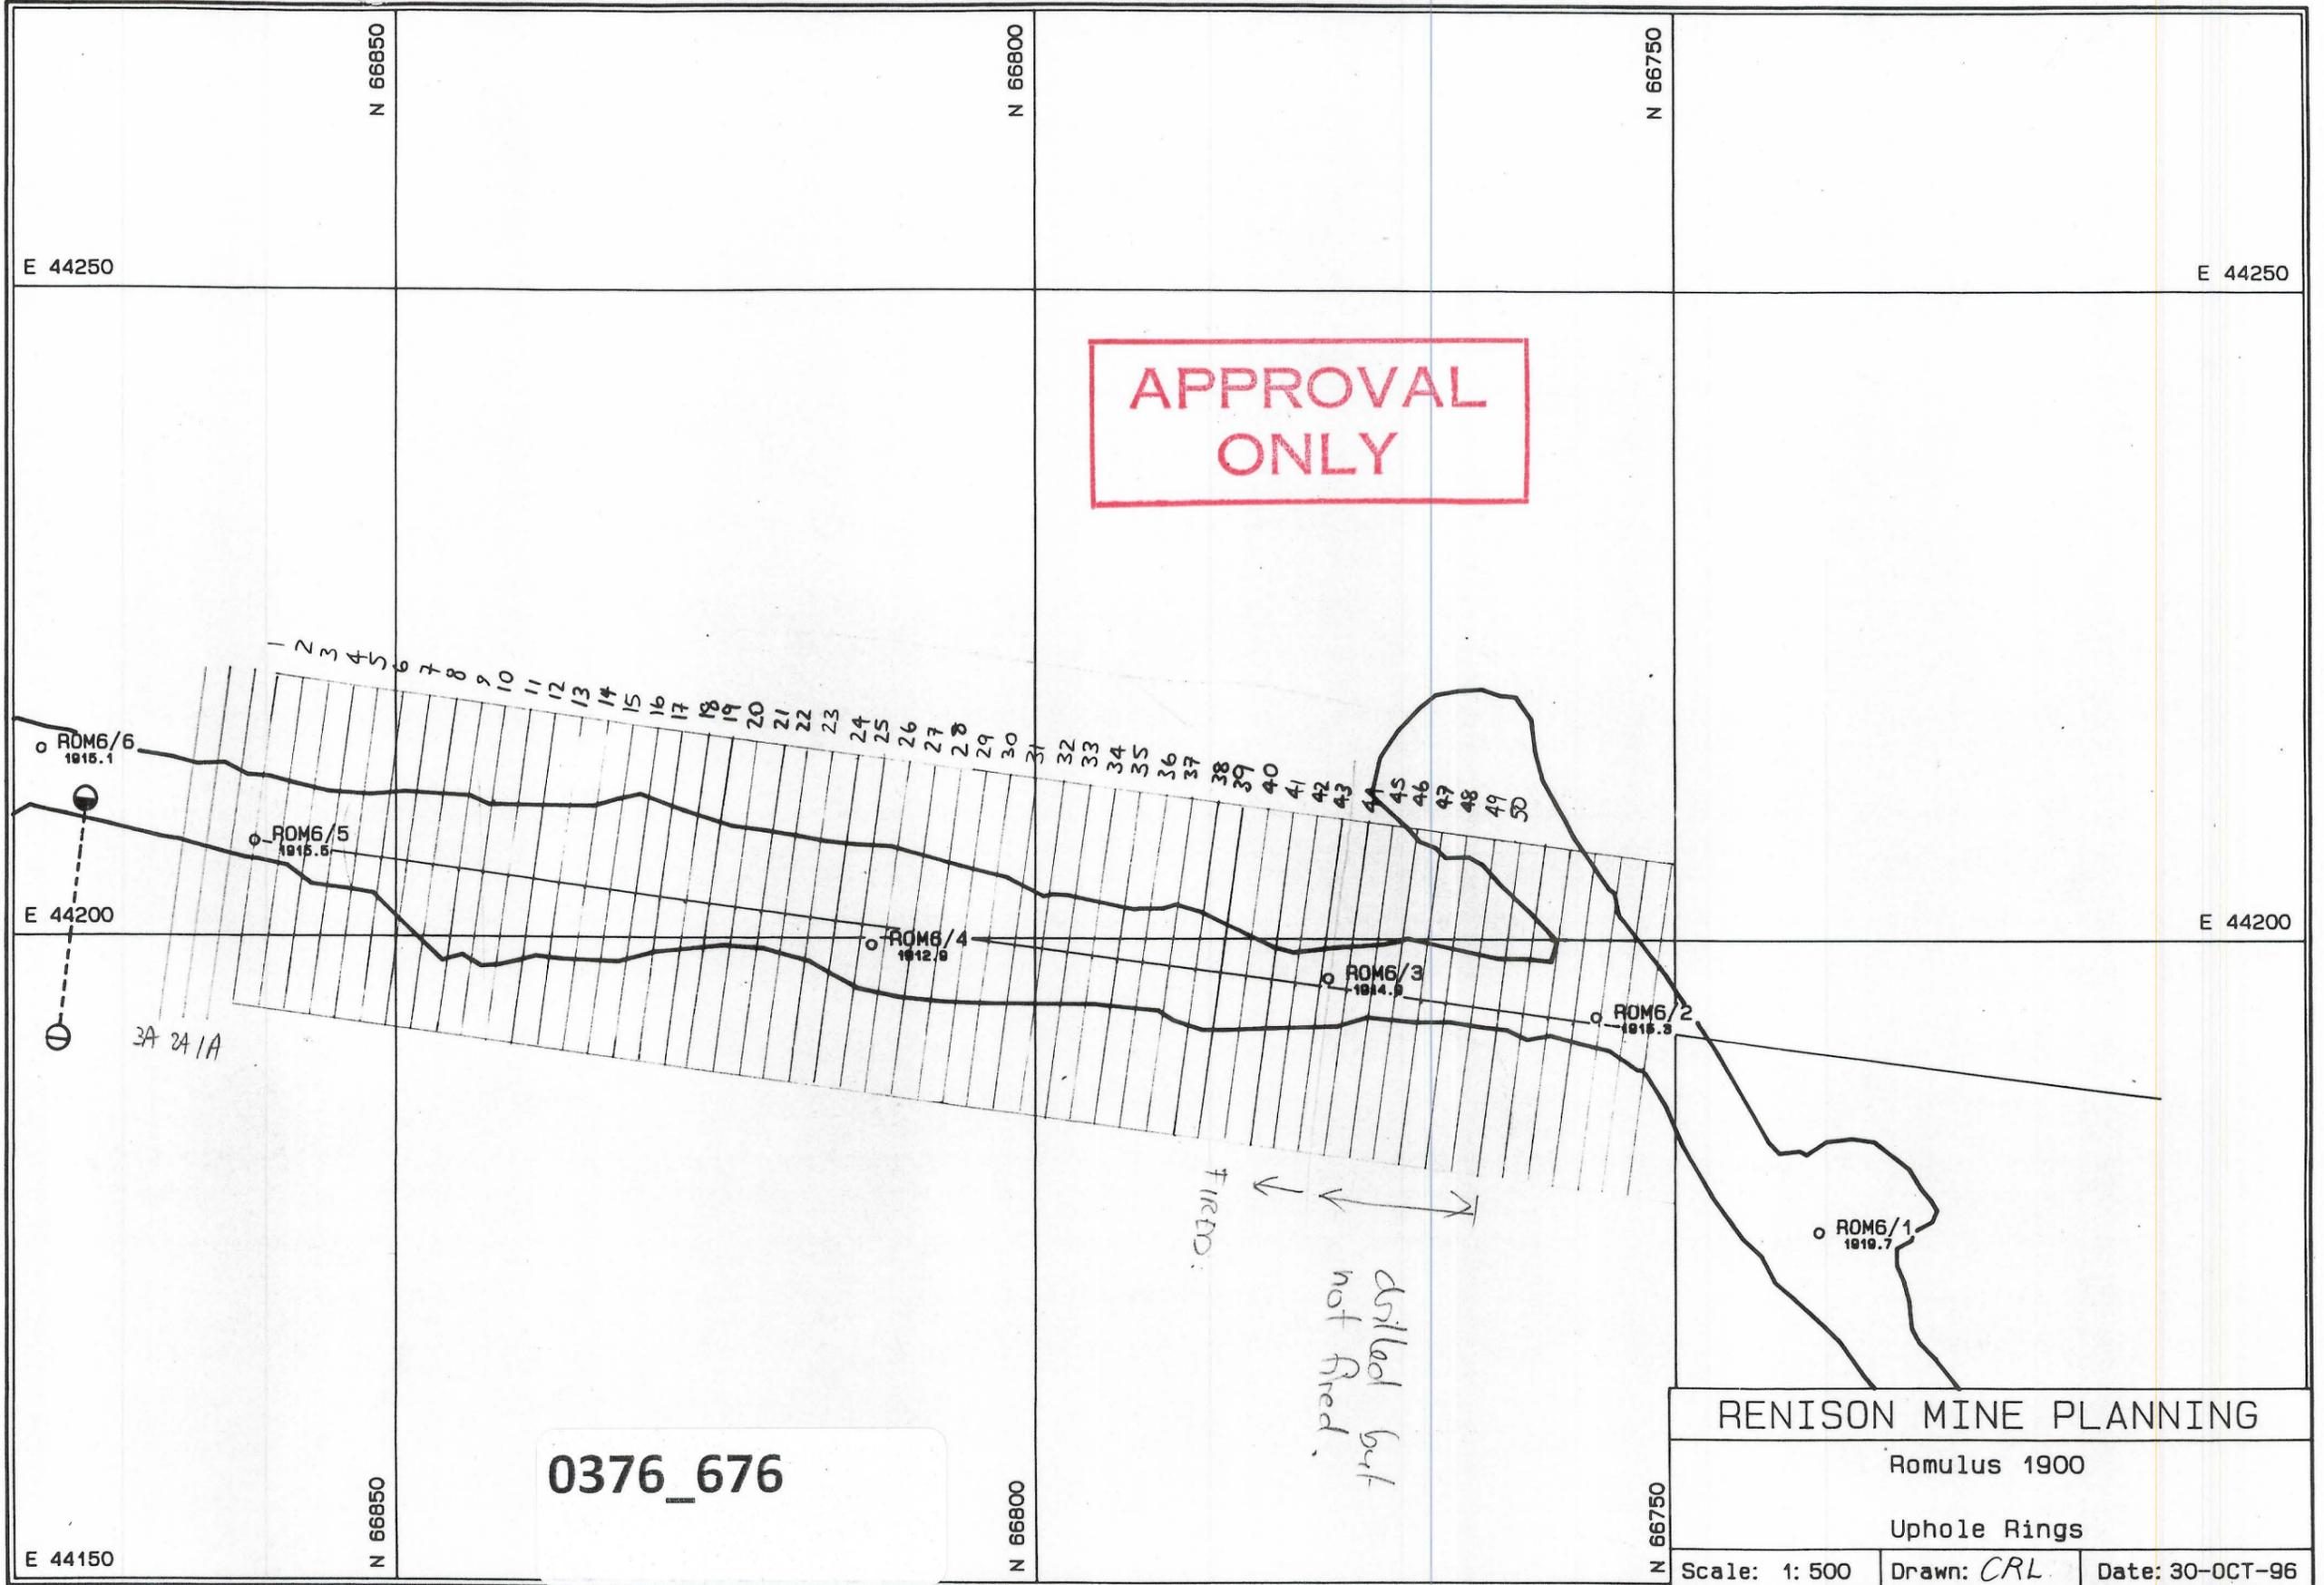

APPROVAL ONLY

0376_676

RENISON MINE PLANNING
 Romulus 1900
 Uphole Rings
 Scale: 1: 500 Drawn: CARL Date: 30-OCT-96

5 cm

PLANF.PF