


0376_677

APPROVAL ONLY

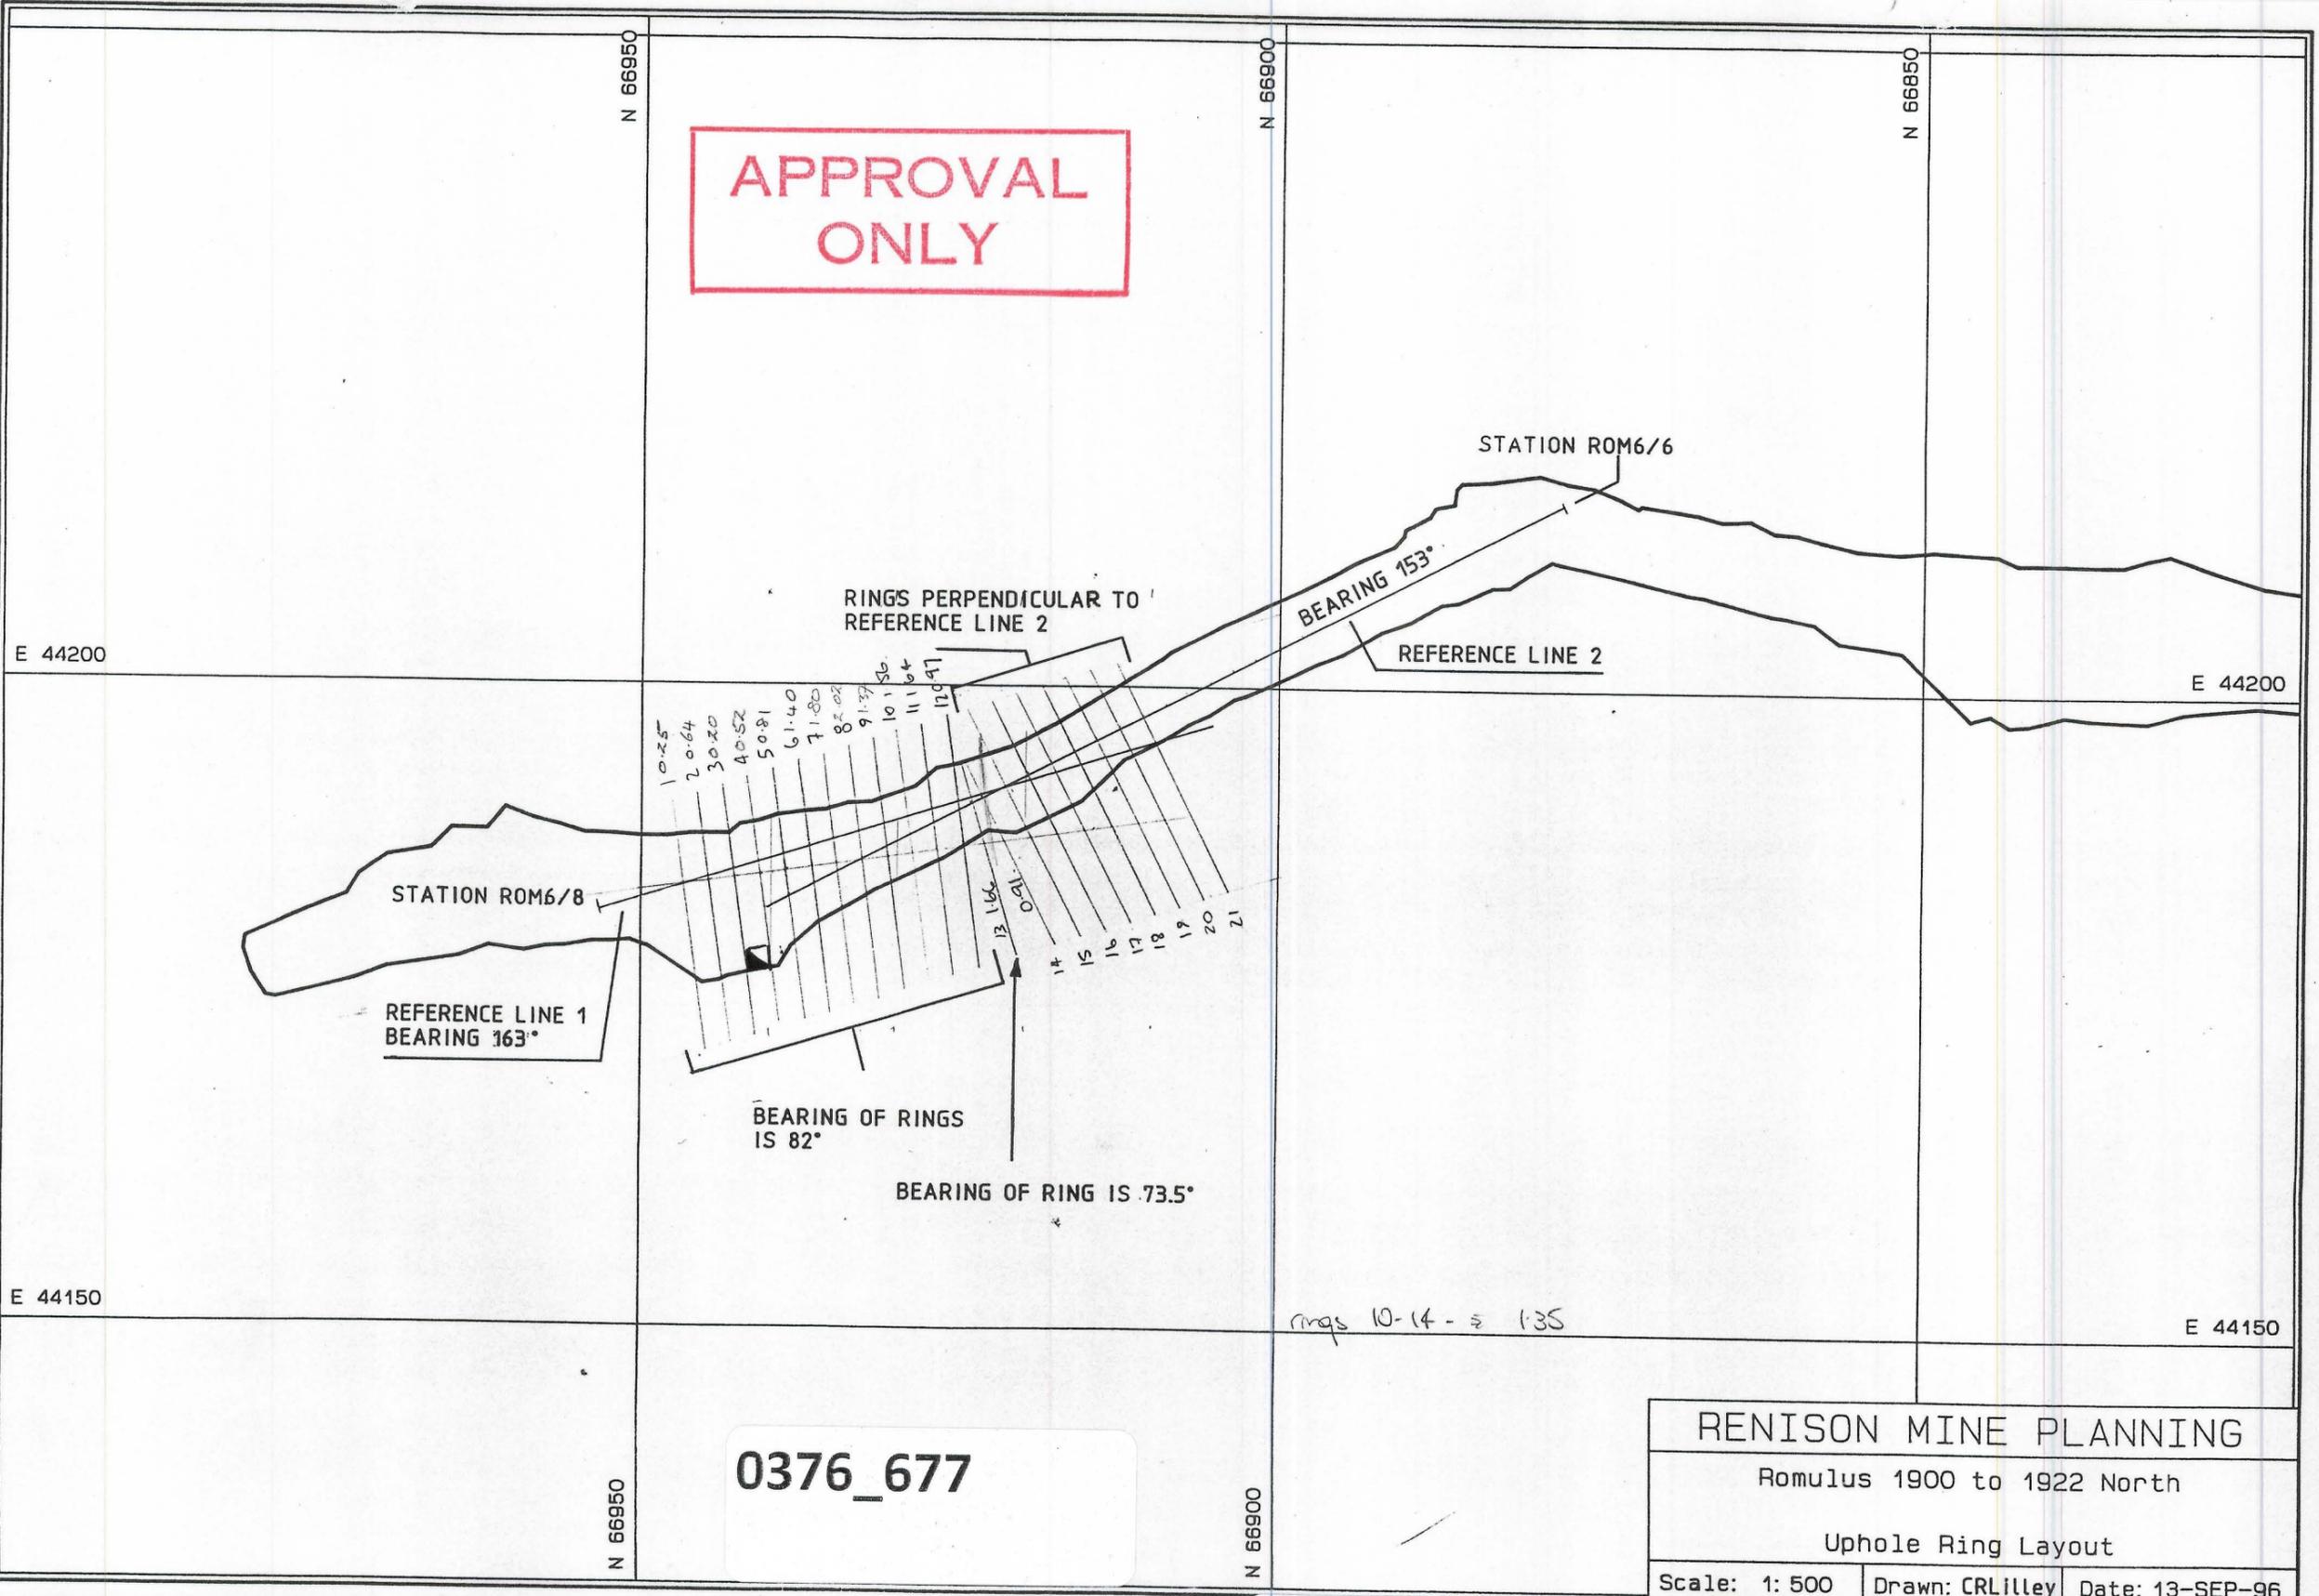

0376_677

RENISON MINE PLANNING

Romulus 1900 to 1922 North

Uphole Ring Layout

Scale: 1: 500 | Drawn: CRLilley | Date: 13-SEP-96

PLANB.PF

