


0376\_680

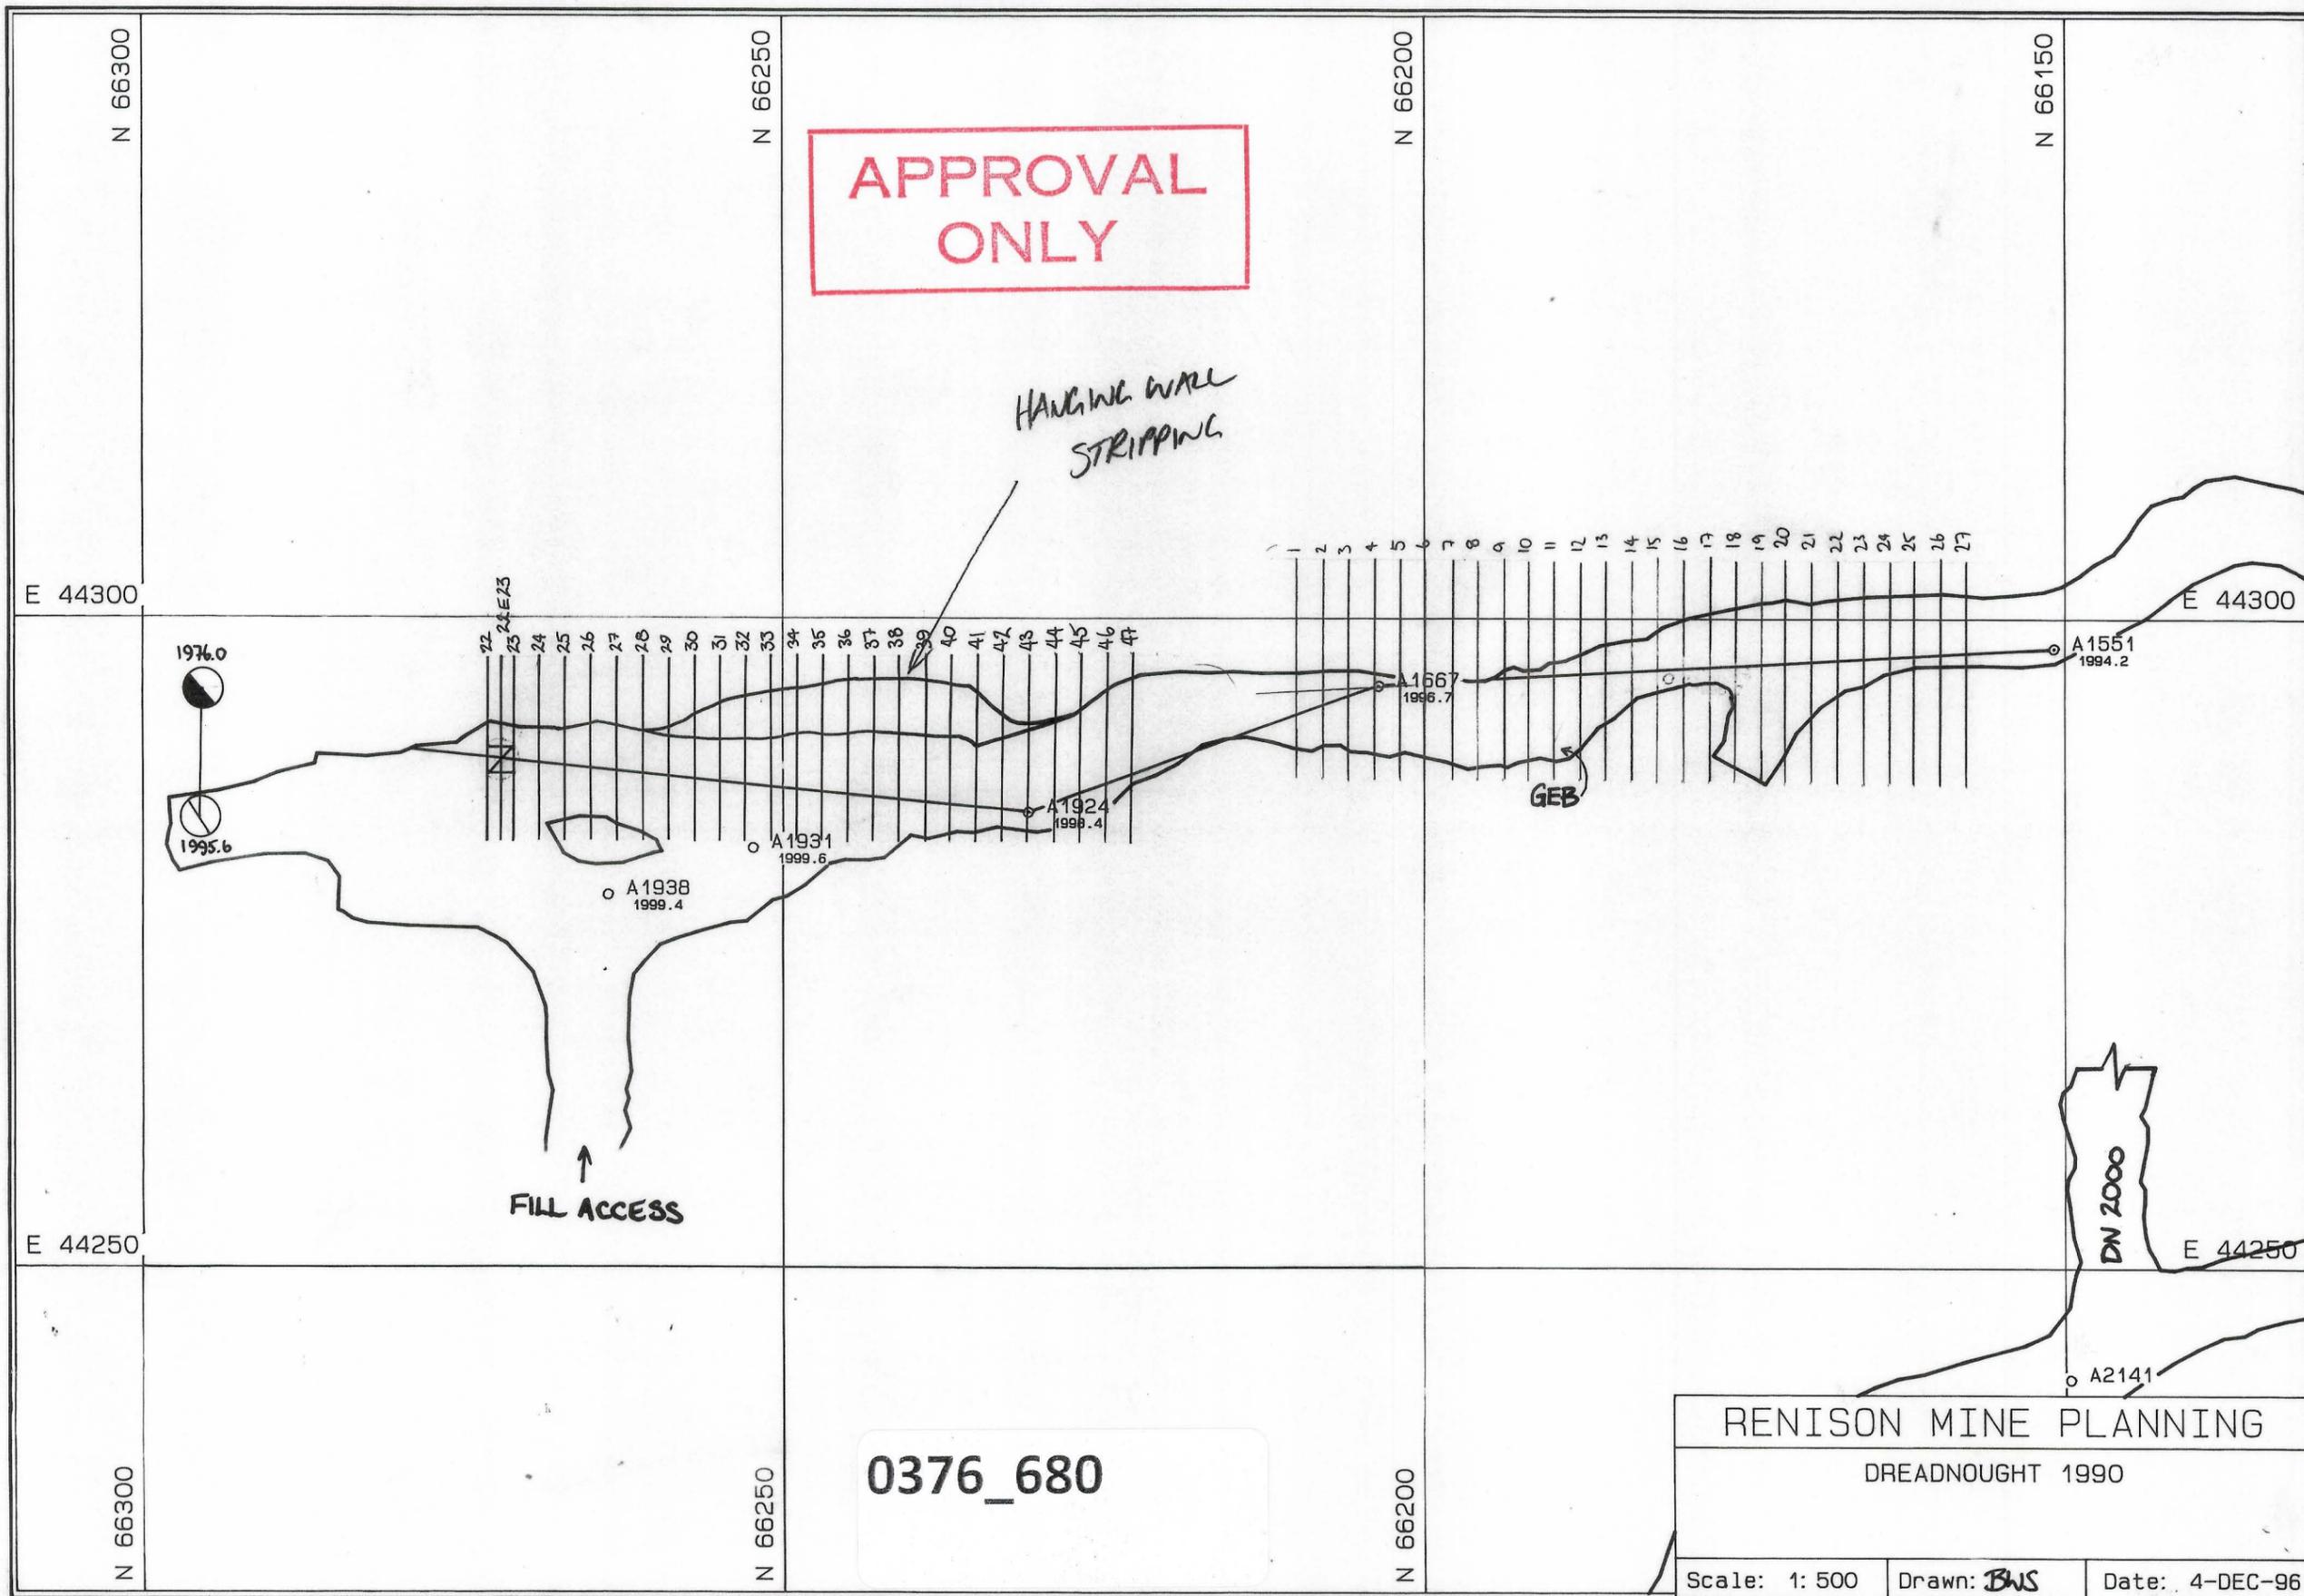

0376\_680

RENISON MINE PLANNING

DREADNOUGHT 1990

Scale: 1: 500

Drawn: BWS

Date: 4-DEC-96

5 cm

BENCH 1

PLANE.PF