


0376\_686

5 cm

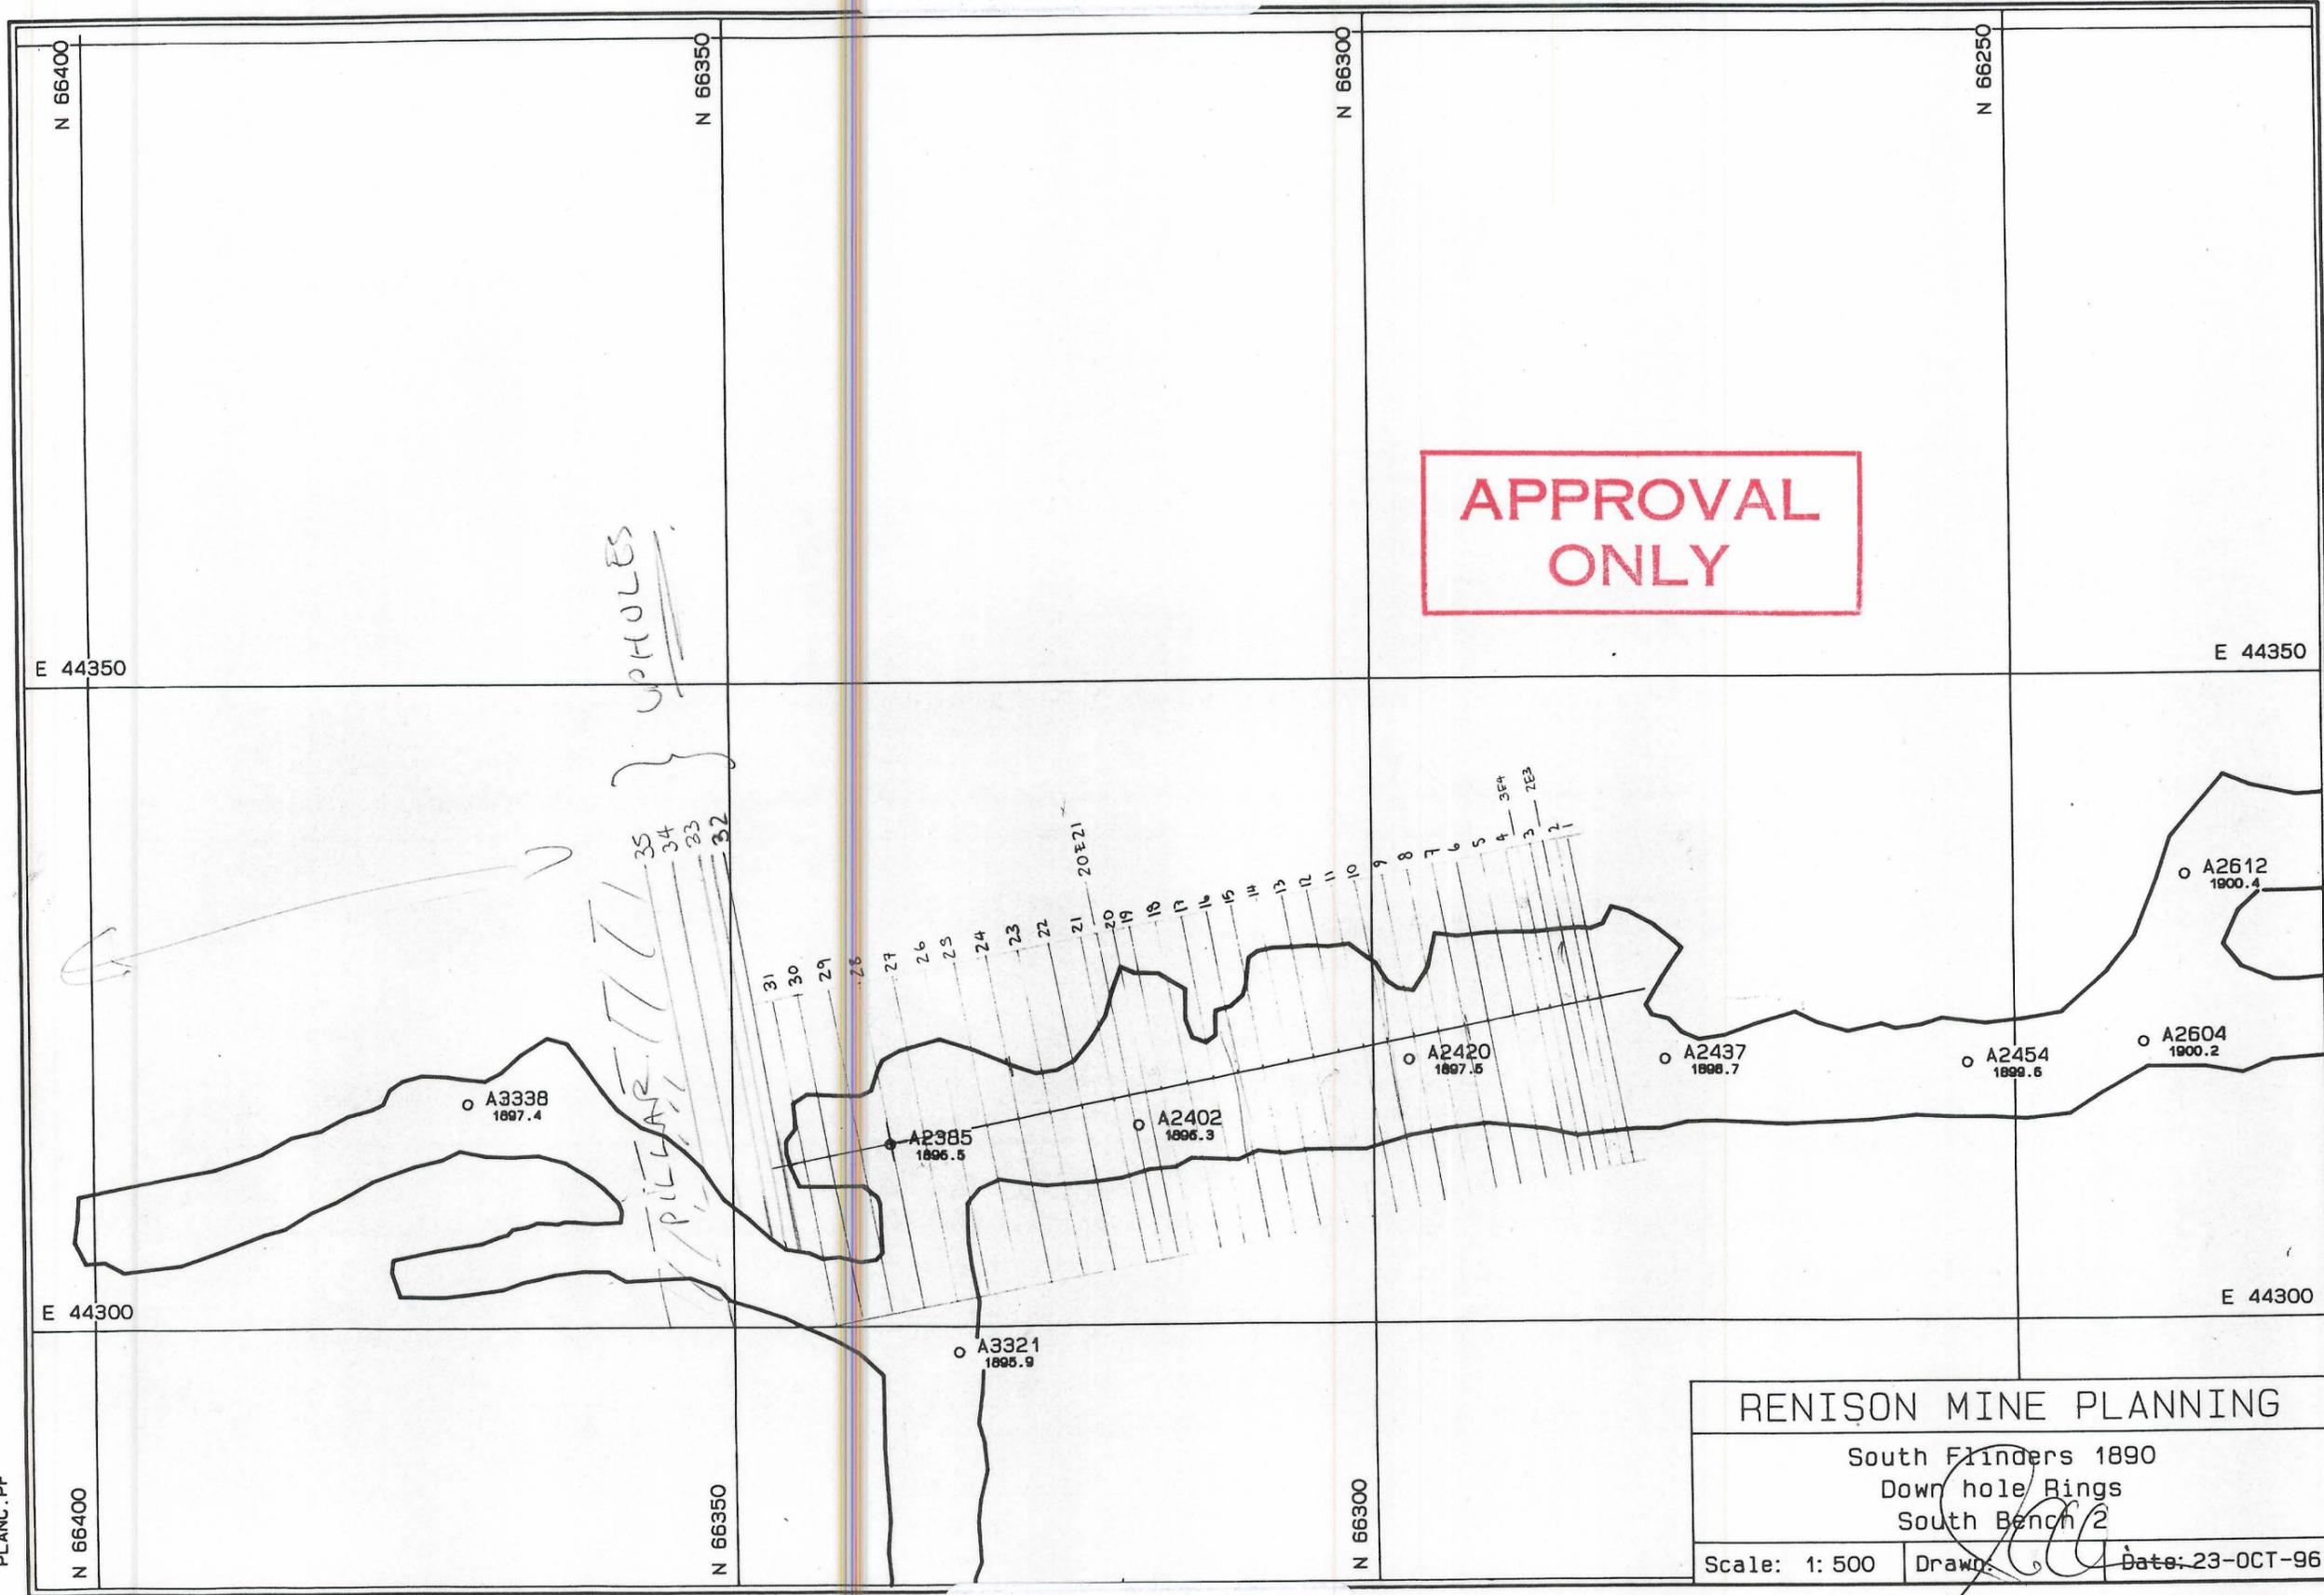

APPROVAL ONLY

RENISON MINE PLANNING  
 South Flinders 1890  
 Down hole Rings  
 South Bench 2  
 Scale: 1: 500 | Drawn: [Signature] | Date: 23-OCT-96

PLANC. PF