


APPROVAL ONLY

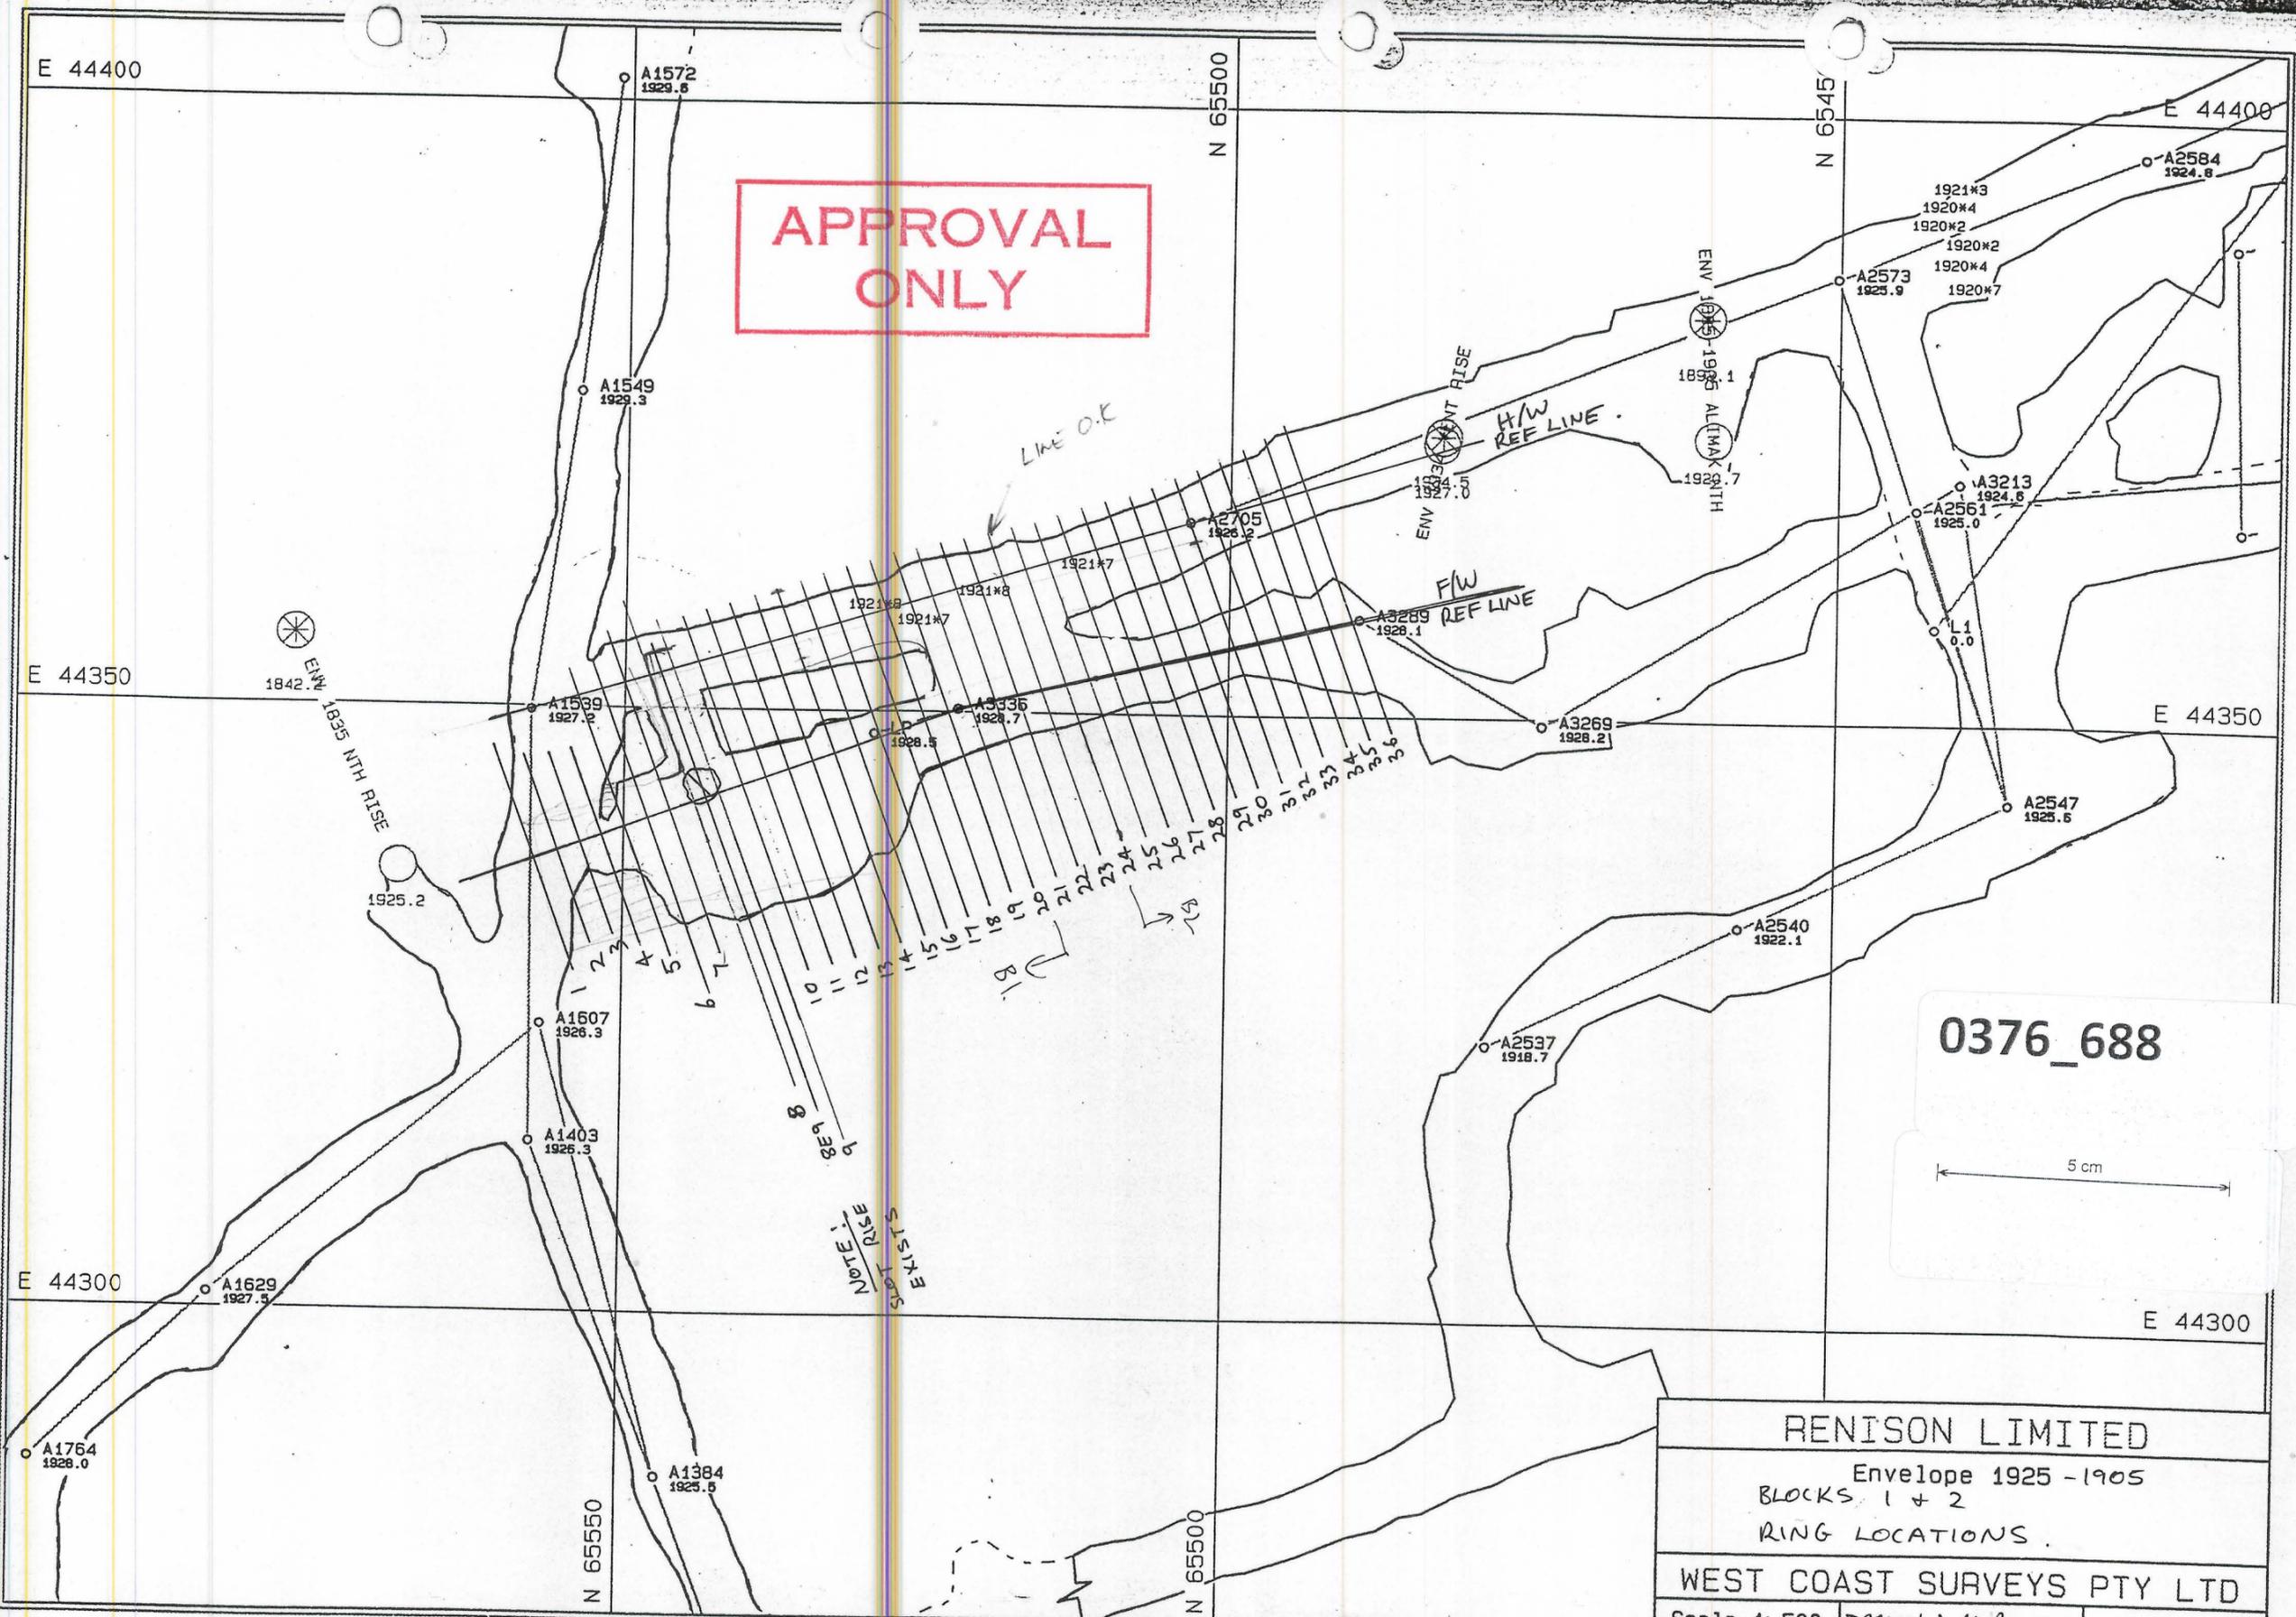

0376_688

5 cm

| | | |
|----------------------------|-------------------|-----------|
| RENISON LIMITED | | |
| Envelope 1925 - 1905 | | |
| BLOCKS 1 + 2 | | |
| RING LOCATIONS. | | |
| WEST COAST SURVEYS PTY LTD | | |
| Scale 1: 500 | DRAWN : M. ROWETT | 11-JUN-96 |

ENVELF.PF