


14-21

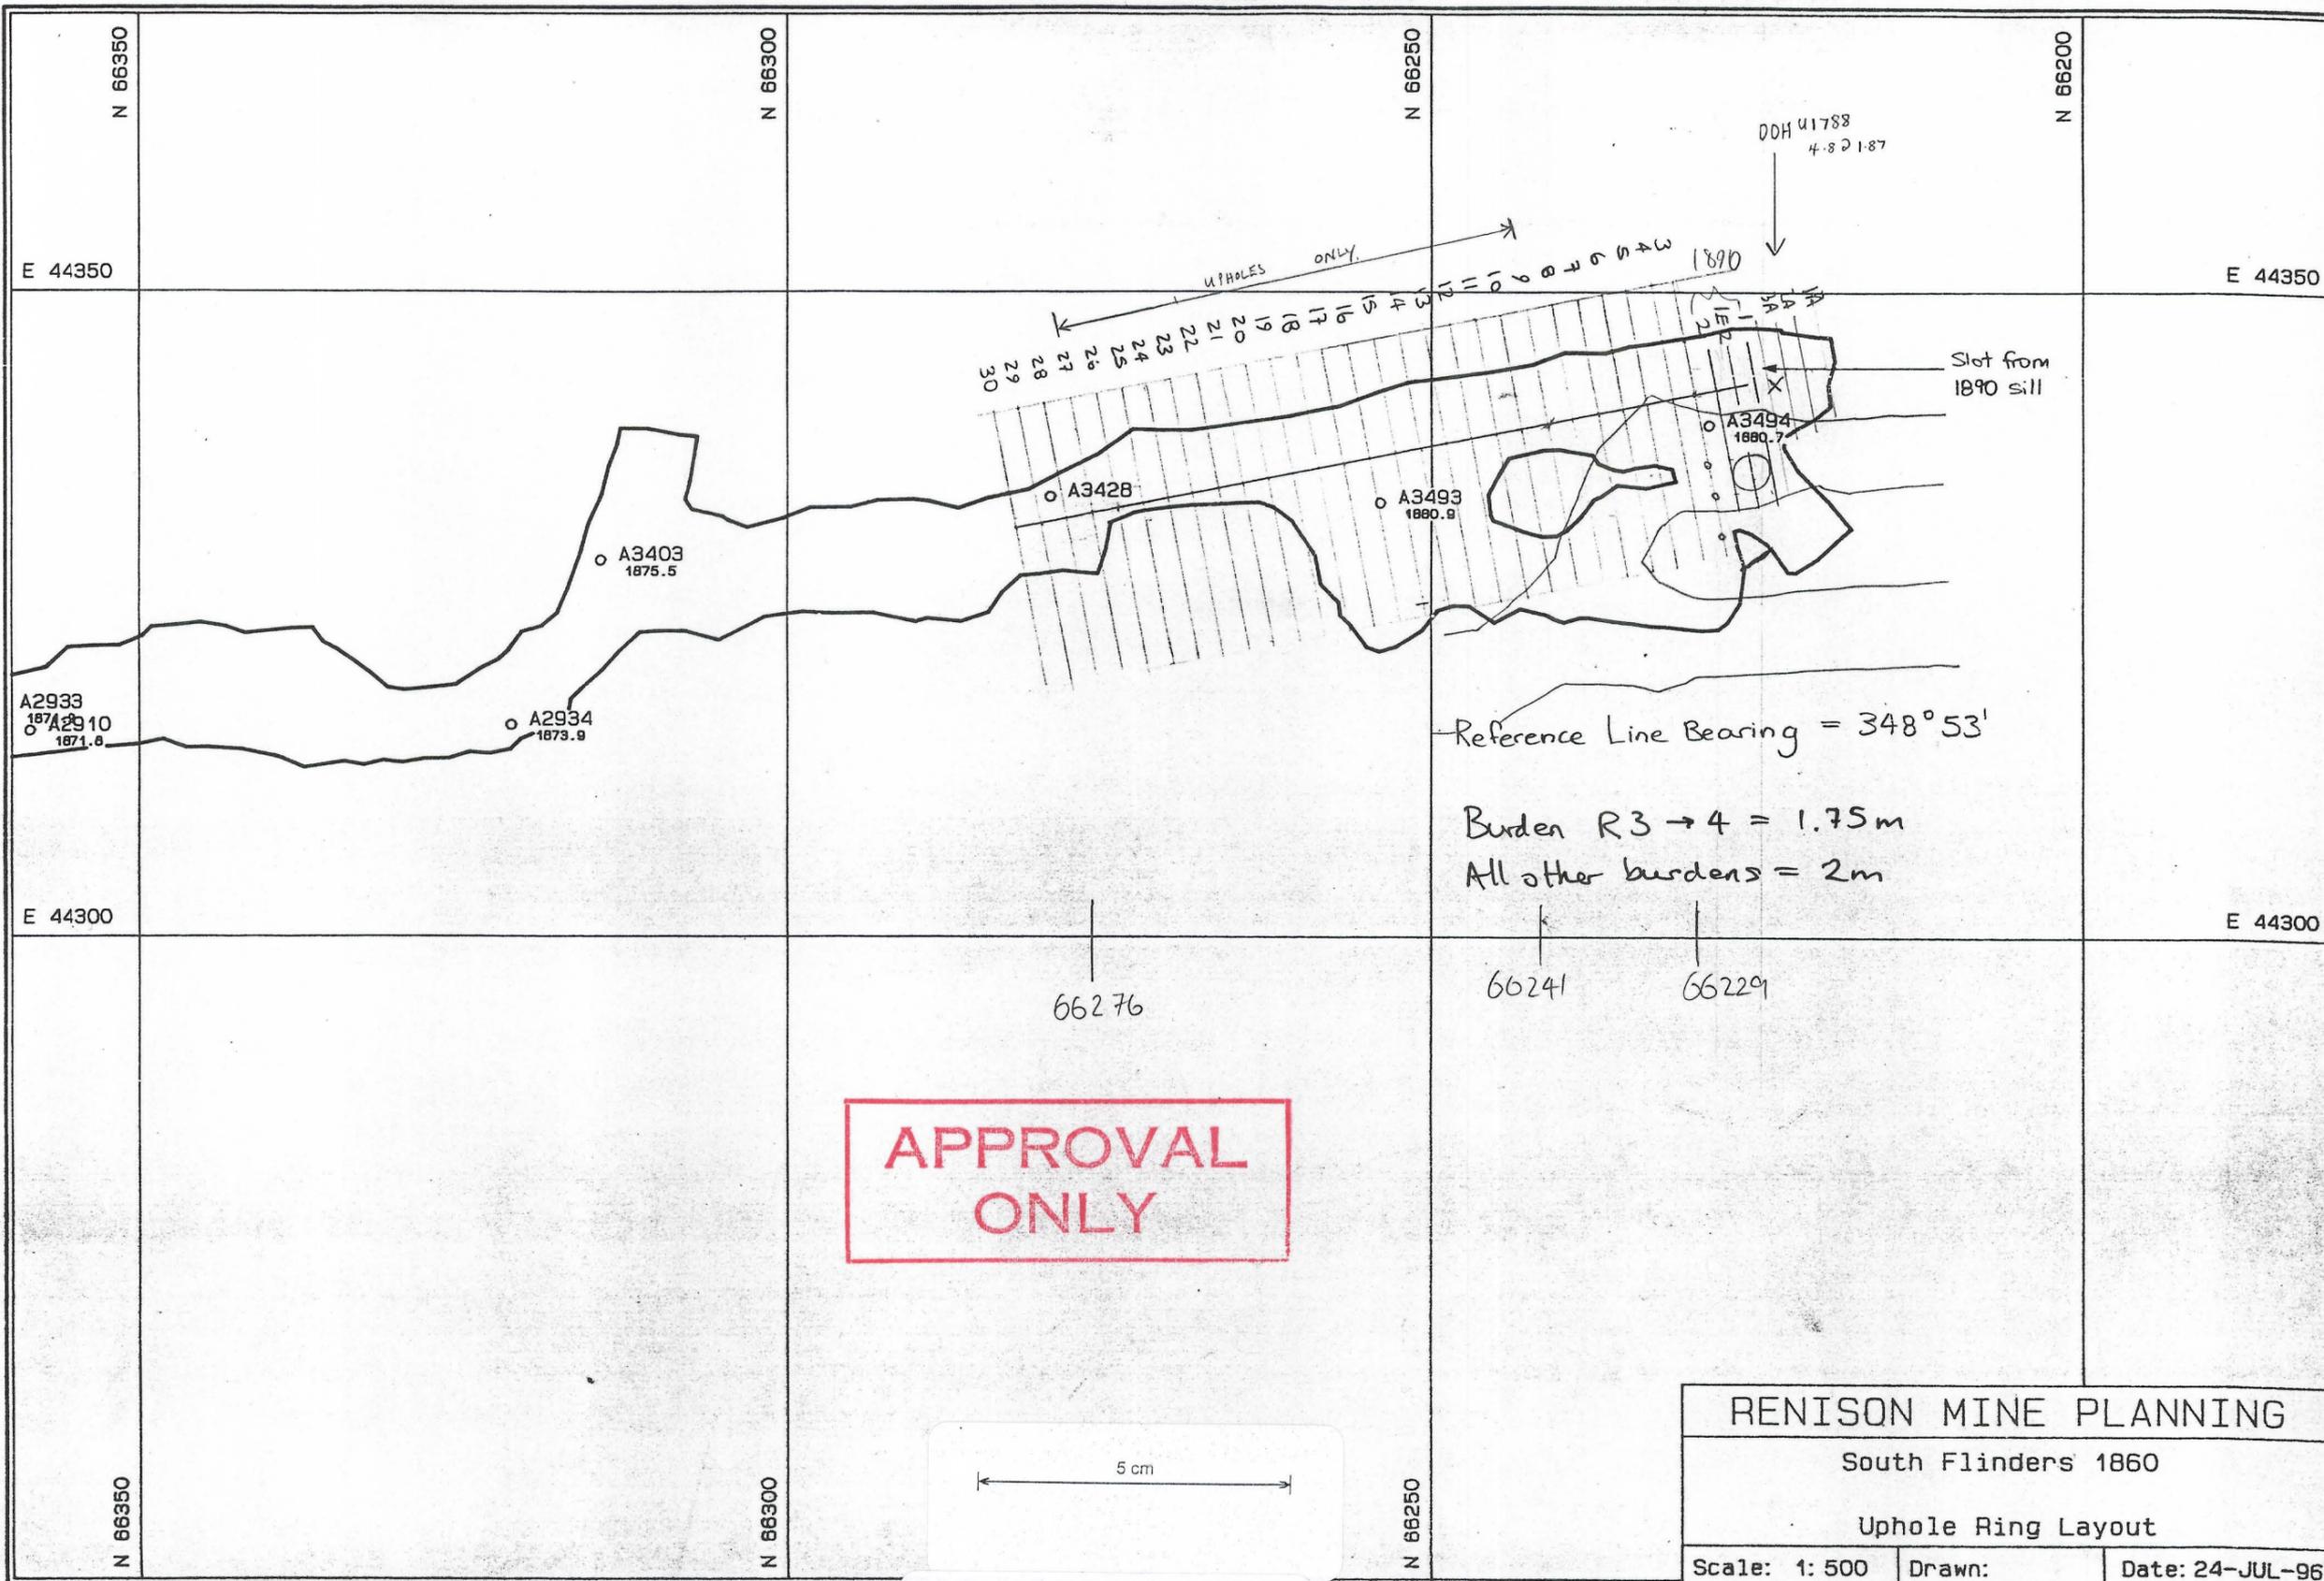

APPROVAL ONLY

RENISON MINE PLANNING		
South Flinders 1860		
Uphole Ring Layout		
Scale: 1:500	Drawn:	Date: 24-JUL-96