


NOTE: Ring layout is correct, but sill outline has been modified.

Chilley
24/7/96.

APPROVAL ONLY

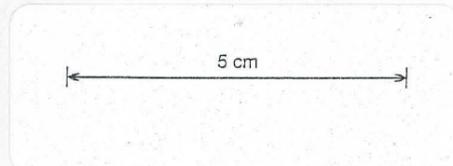

RENISON MINE PLANNING		
South Flinders 1860 Ring Layout		
Scale: 1:500	Drawn:	Date: 4-APR-96

PLANB.PF