


0376_693

0376_693

5 cm

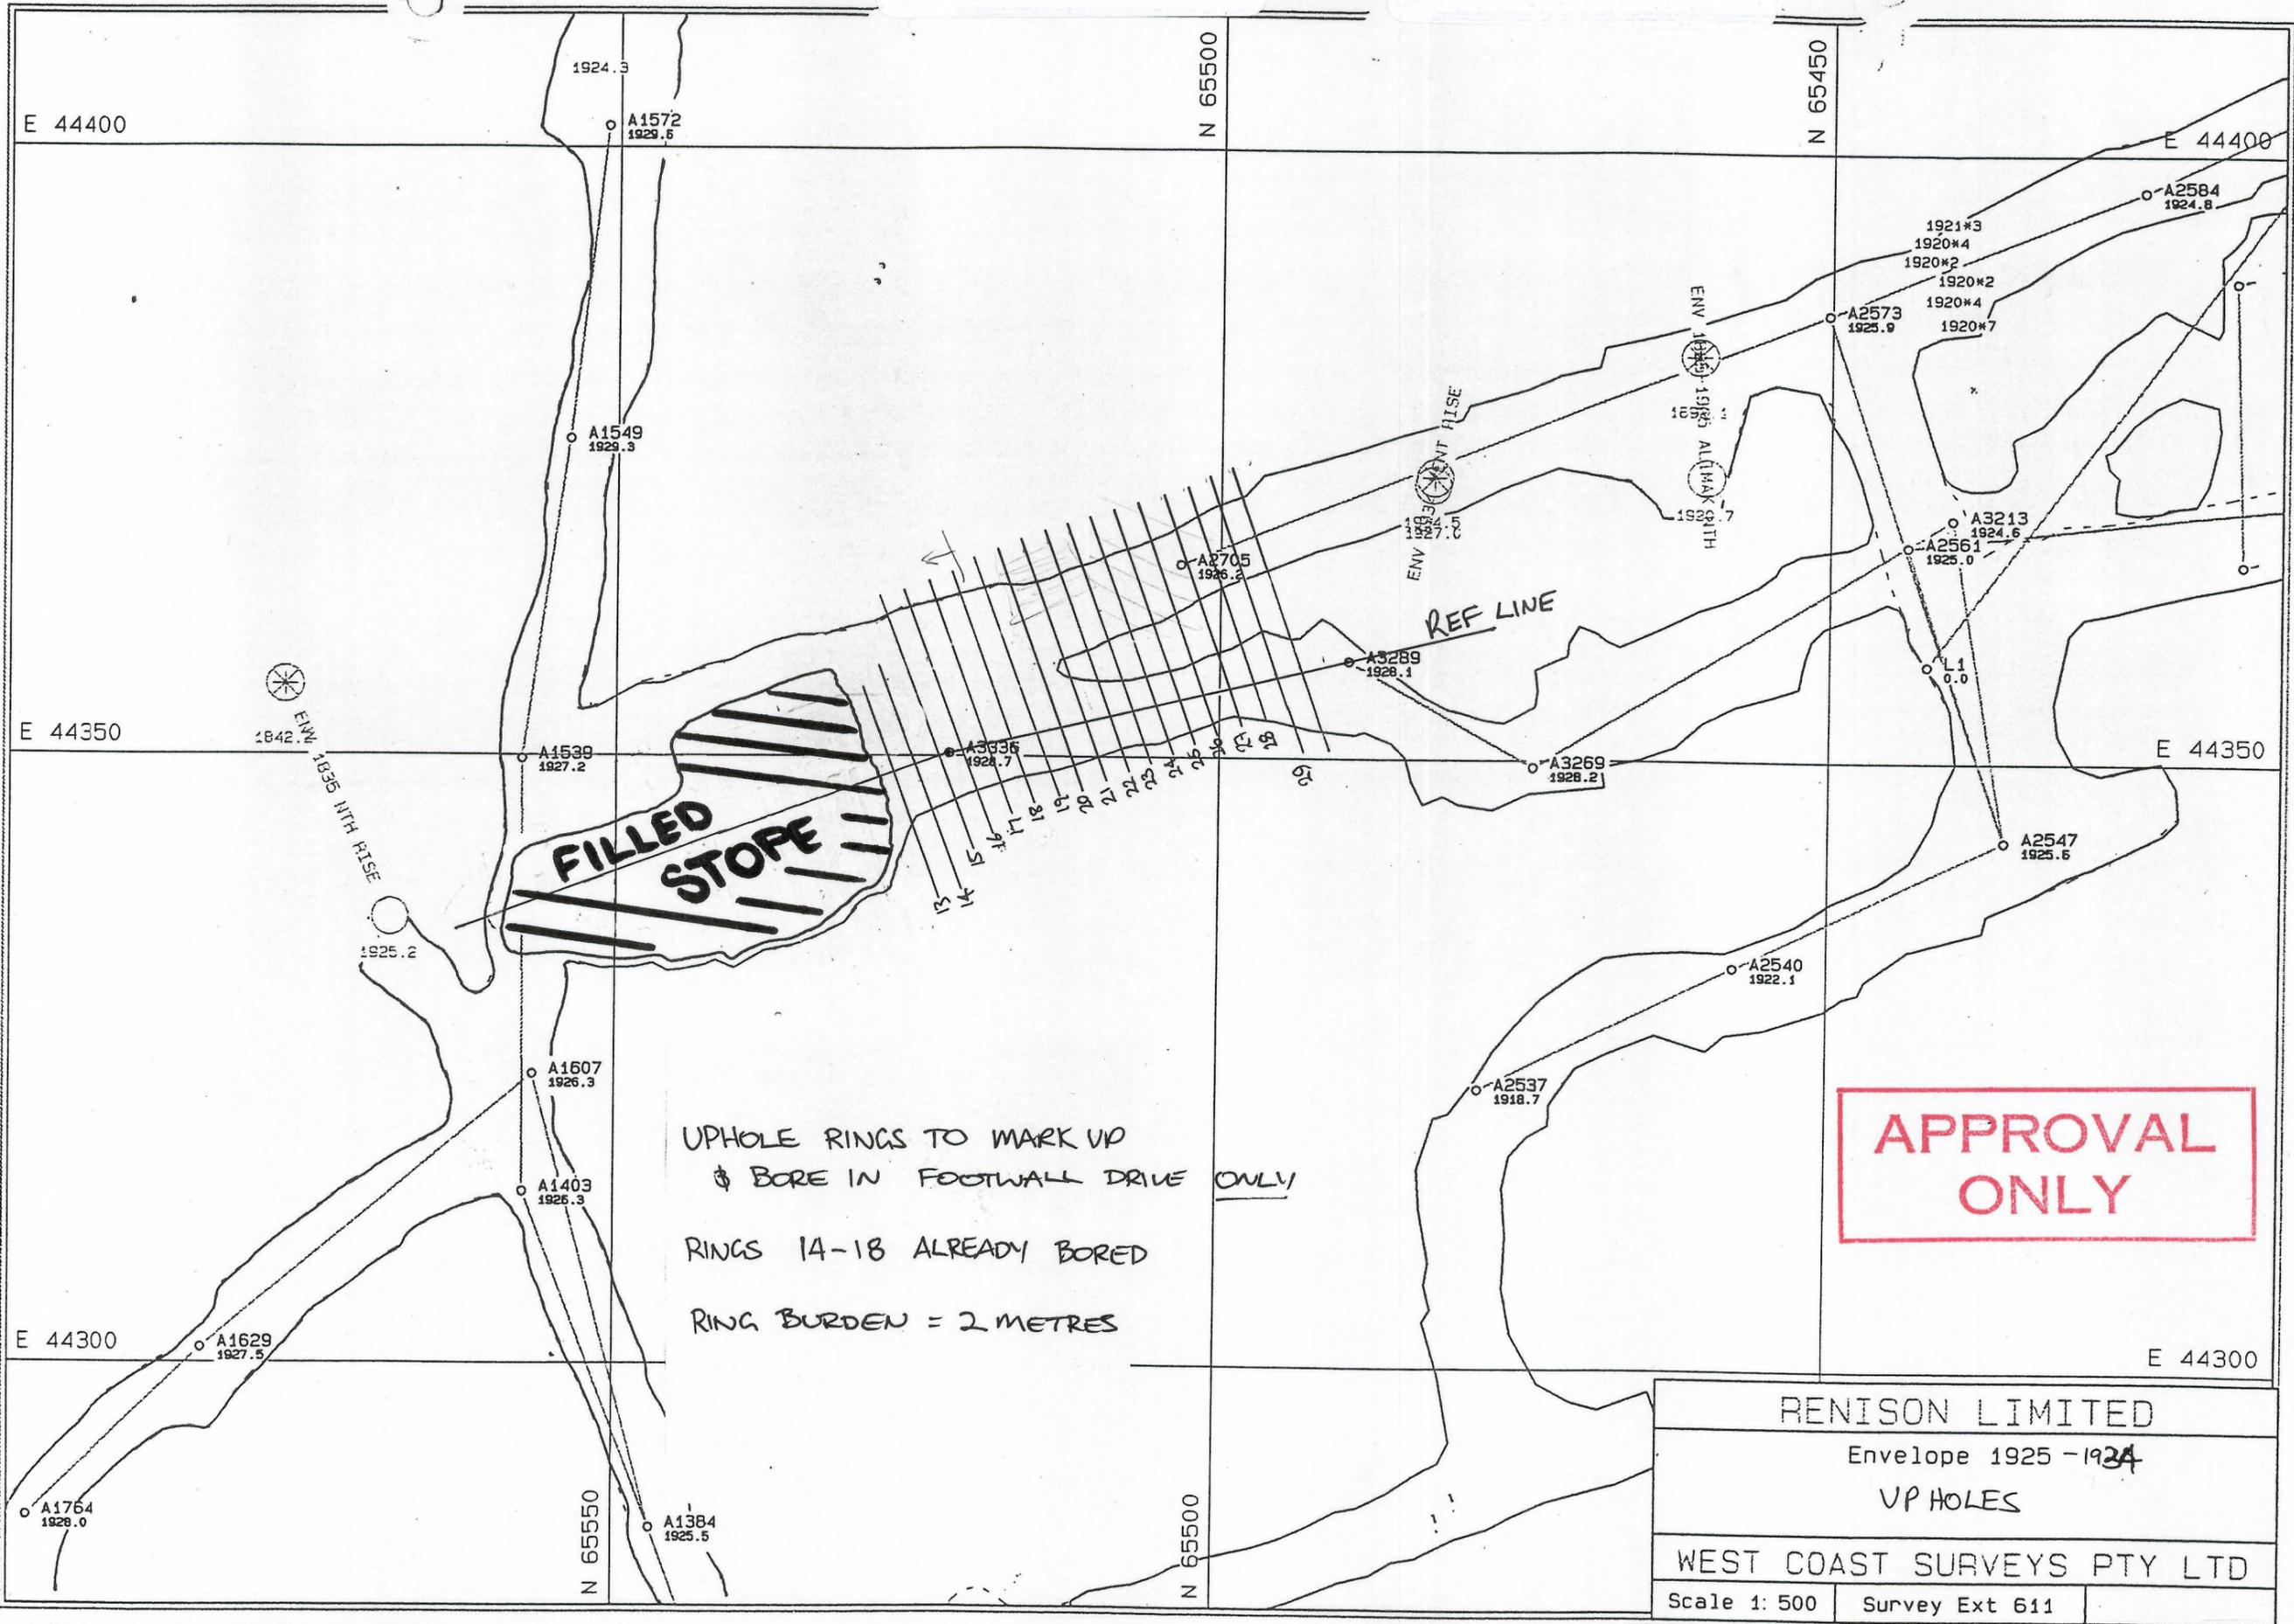

ENVELB.PF