


0376_694

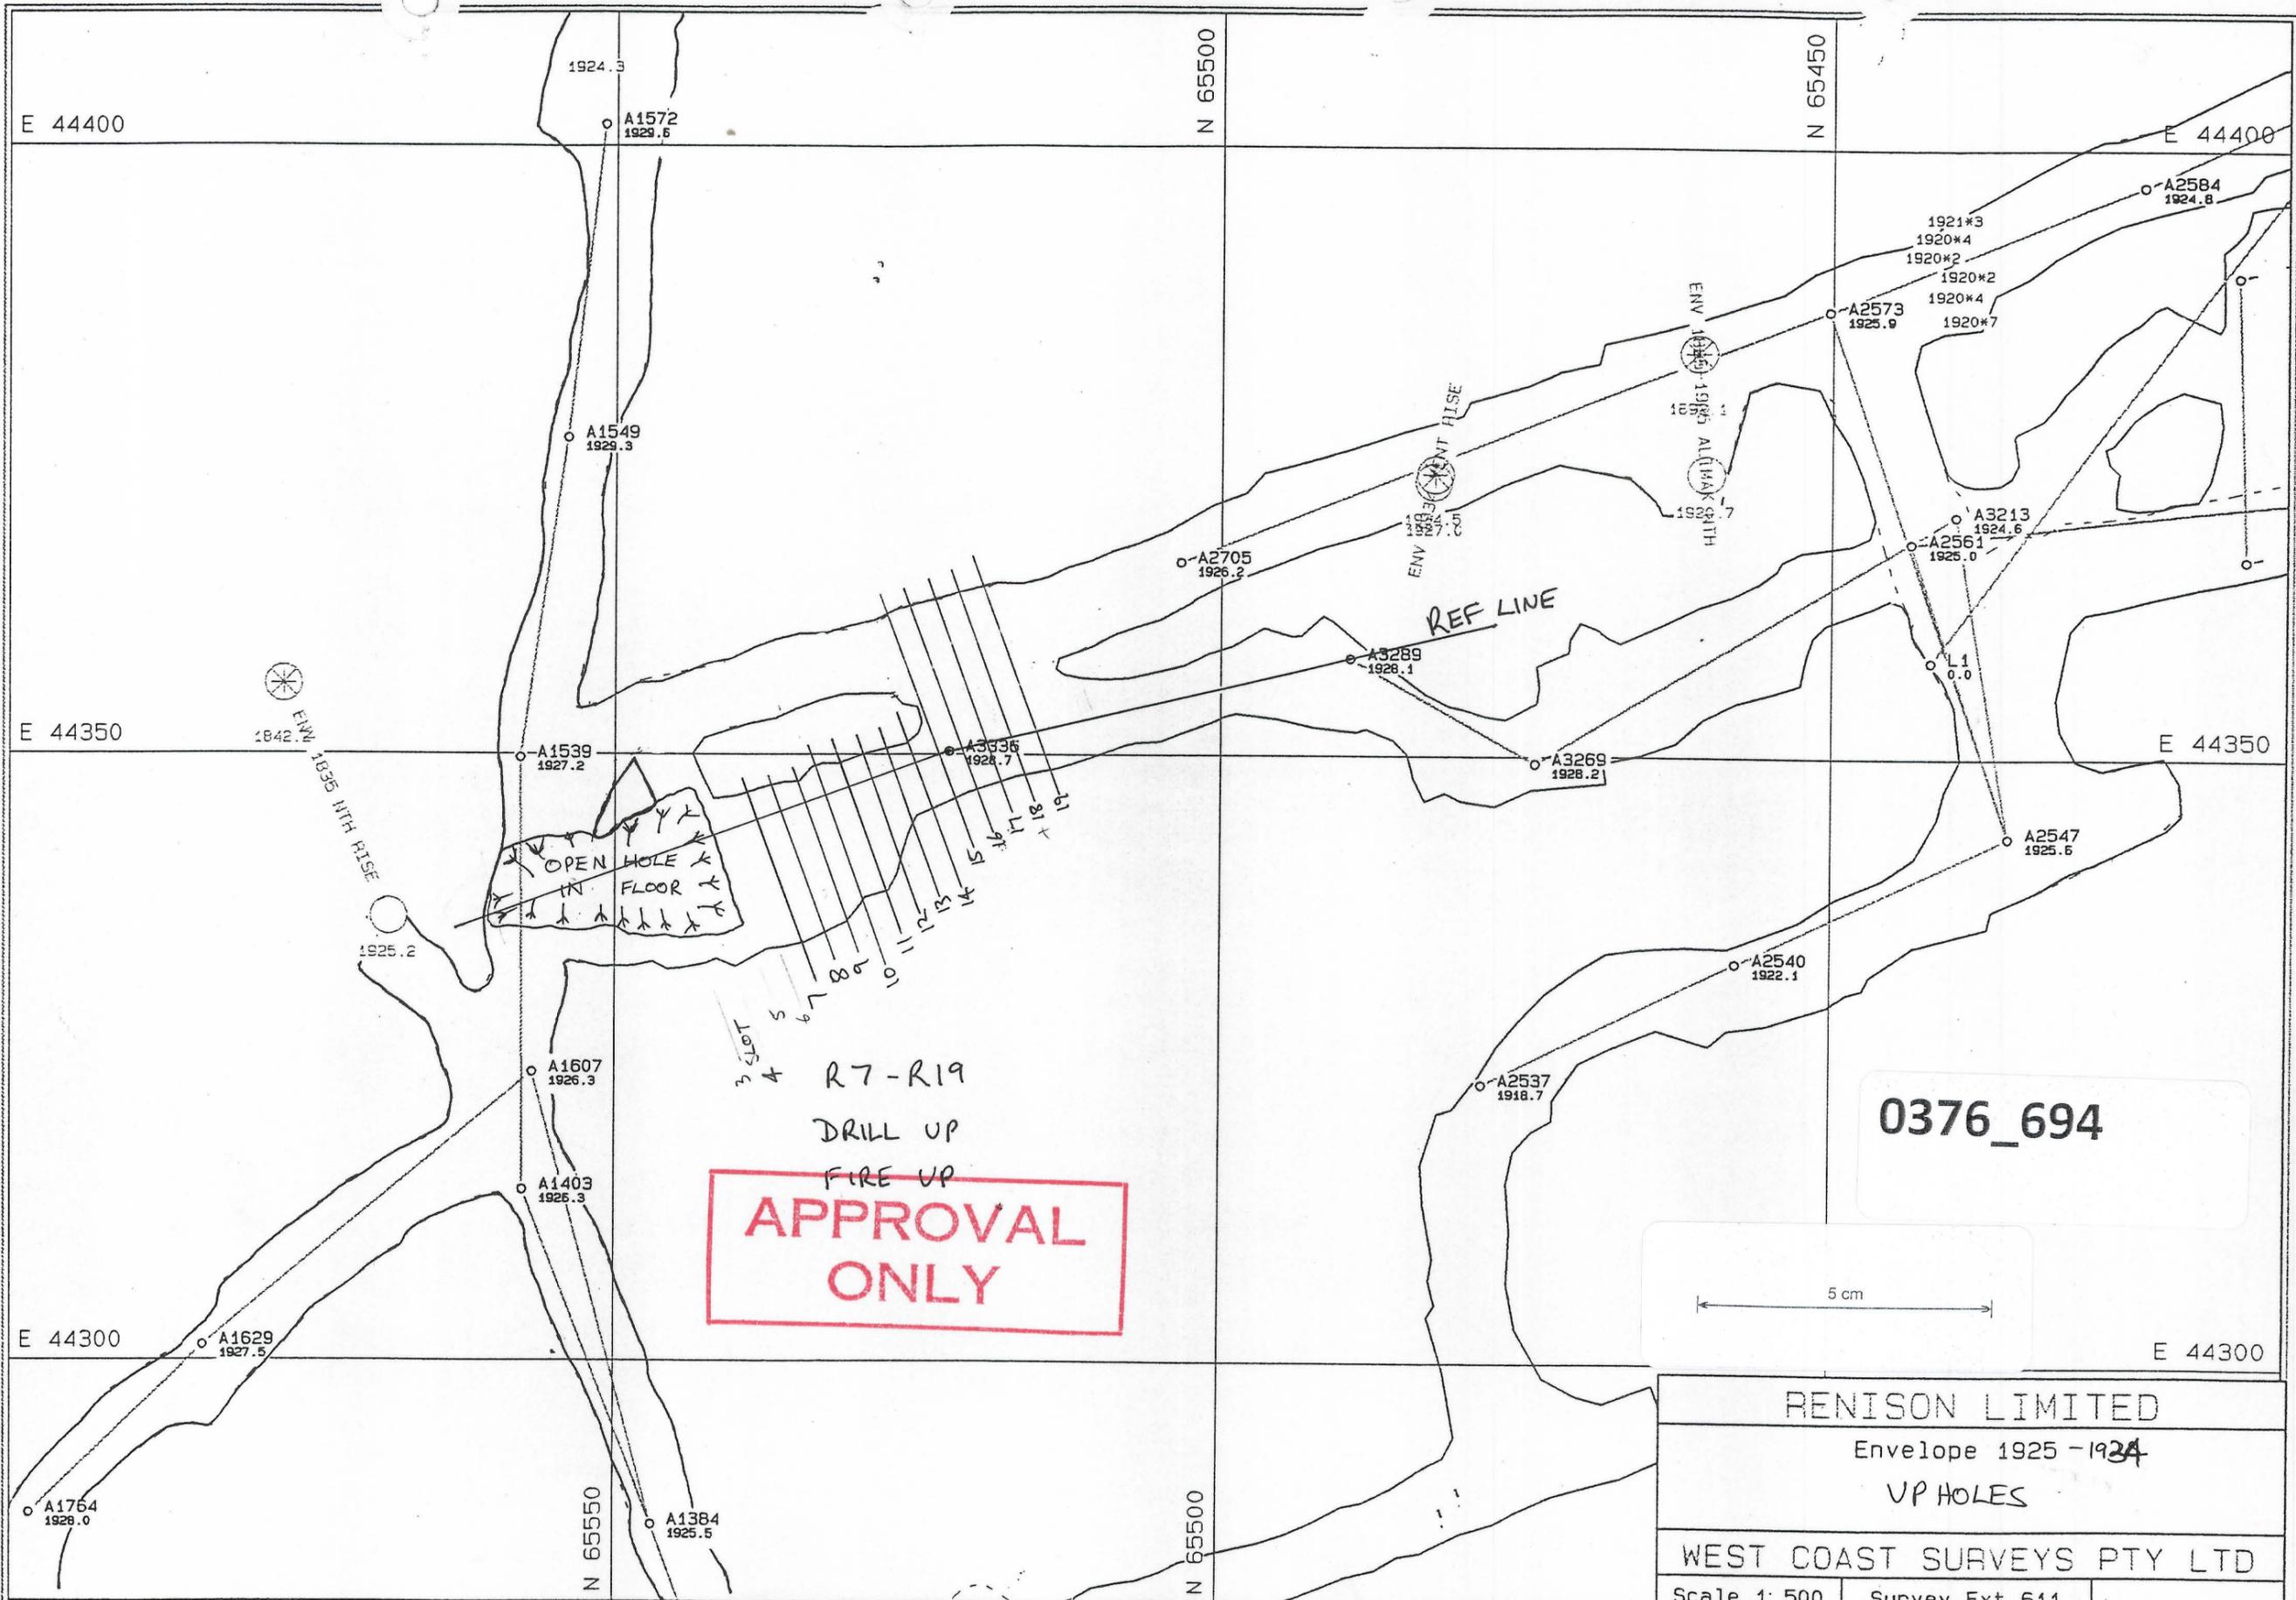

0376_694

ENVELB.PF