


0376_696

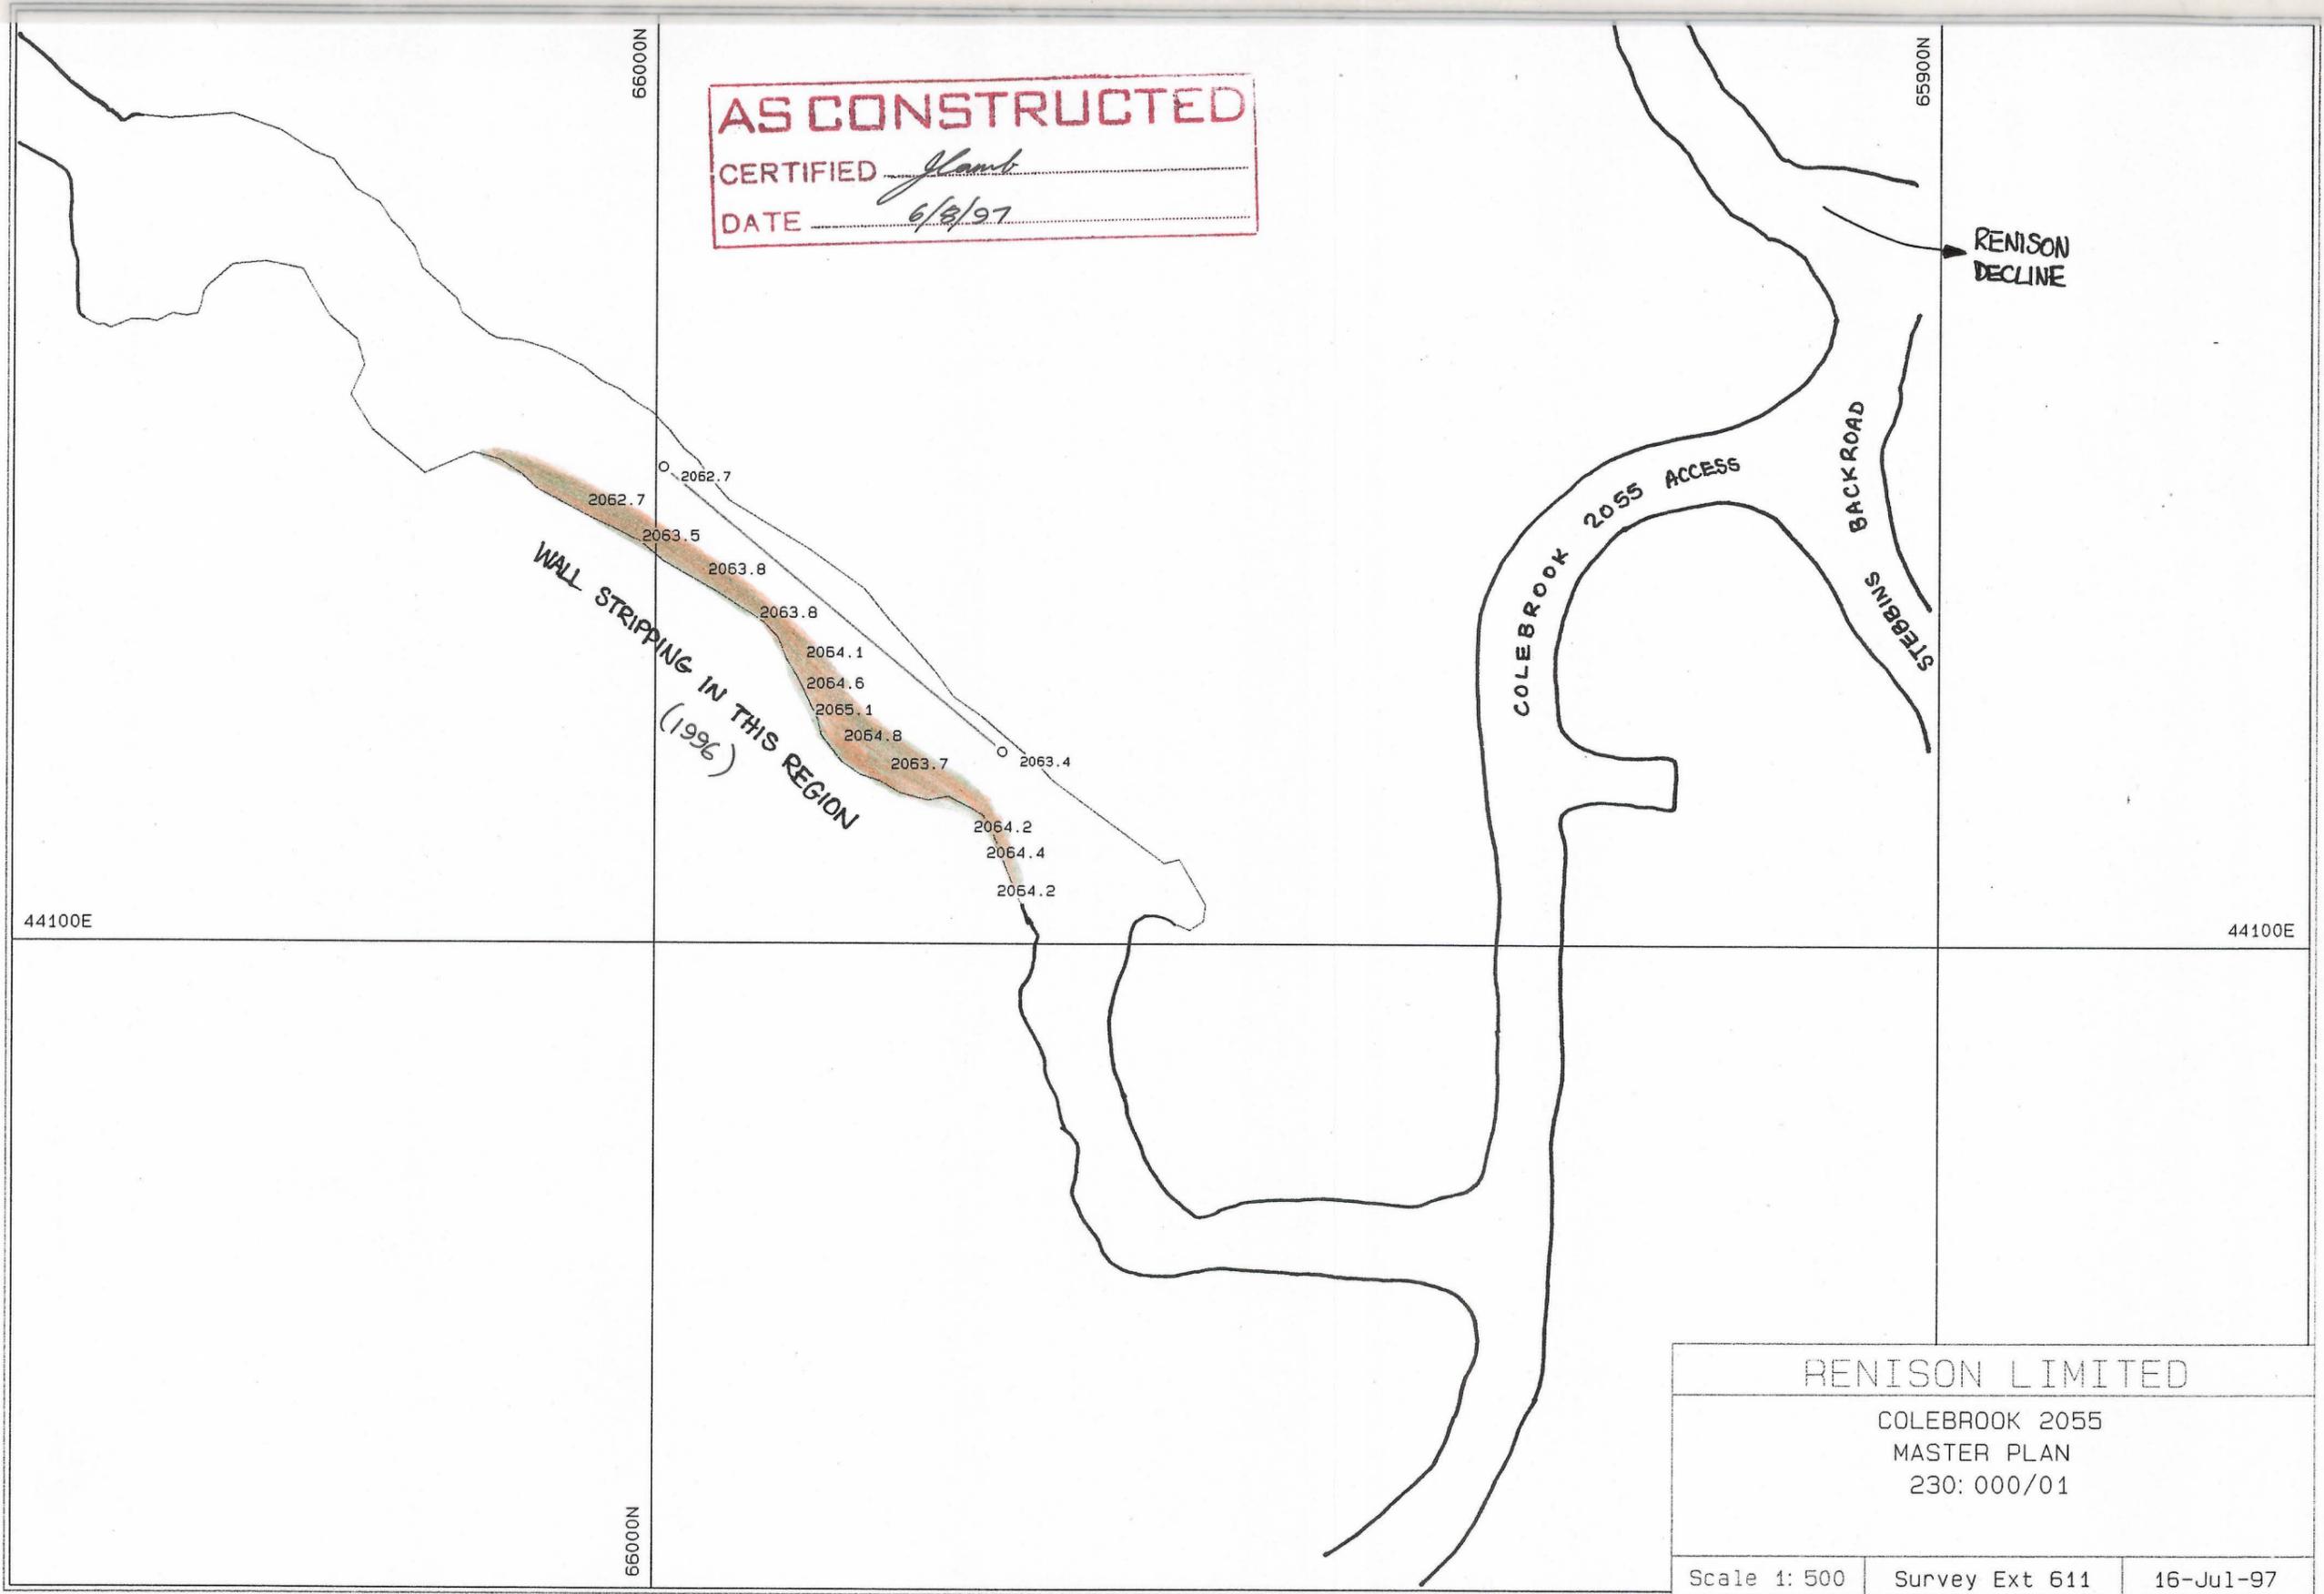

AS CONSTRUCTED
 CERTIFIED *Glamb*
 DATE *6/8/97*

WALL STRIPPING IN THIS REGION
 (1996)

RENISON LIMITED		
COLEBROOK 2055 MASTER PLAN 230: 000/01		
Scale 1: 500	Survey Ext 611	16-Jul-97

co.lebrob . pf

SURPAC SOFTWARE INTERNATIONAL. AUSTRALIA

0376_696

