

0376_697

RENISON LIMITED

RING 10 FLOOR BENCH MASTER PLAN

SCALE 1: 500

DATE 16-Jul-97


LEVEL R10

132: 001/02

APPROVED

REGISTERED MINE SURVEYOR

REGISTERED MINE MANAGER

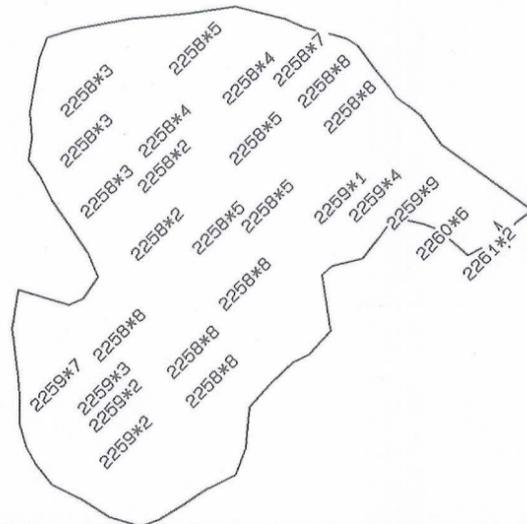

A2739
2267.0


A2738
2264.3

43400E

66100N

66100N

0376_697

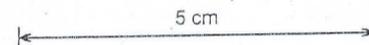

43400E

43500E