

0376\_698

# RENISON LIMITED

## ELDON 2 LIFT 6 MASTER PLAN

SCALE 1: 500

DATE 16-Jul-97


LEVEL EL2

211: 006/01

RENISON LIMITED

Original plan not drawn  
at completion of mining.

Mined 1996

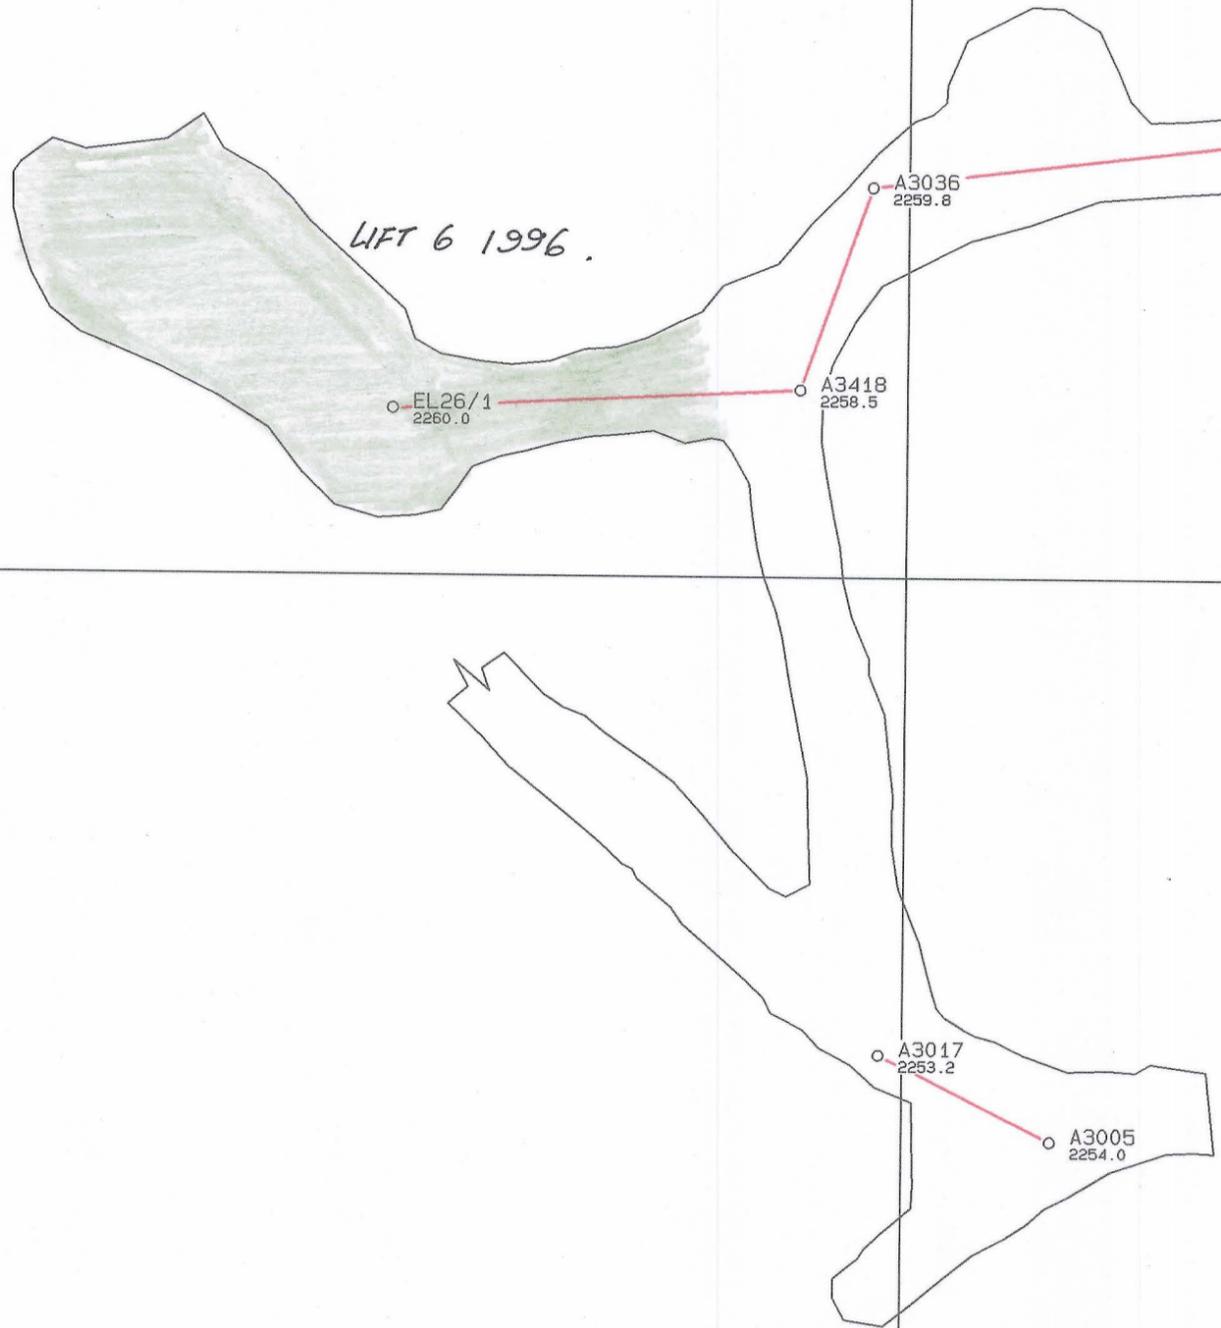

**AS CONSTRUCTED**  
 CERTIFIED *flamb*  
 DATE *6/8/97*

5 cm

0376\_698

43800E

43800E

65600N

65600N

e:\don21a.pf