



0376_699

0376_699

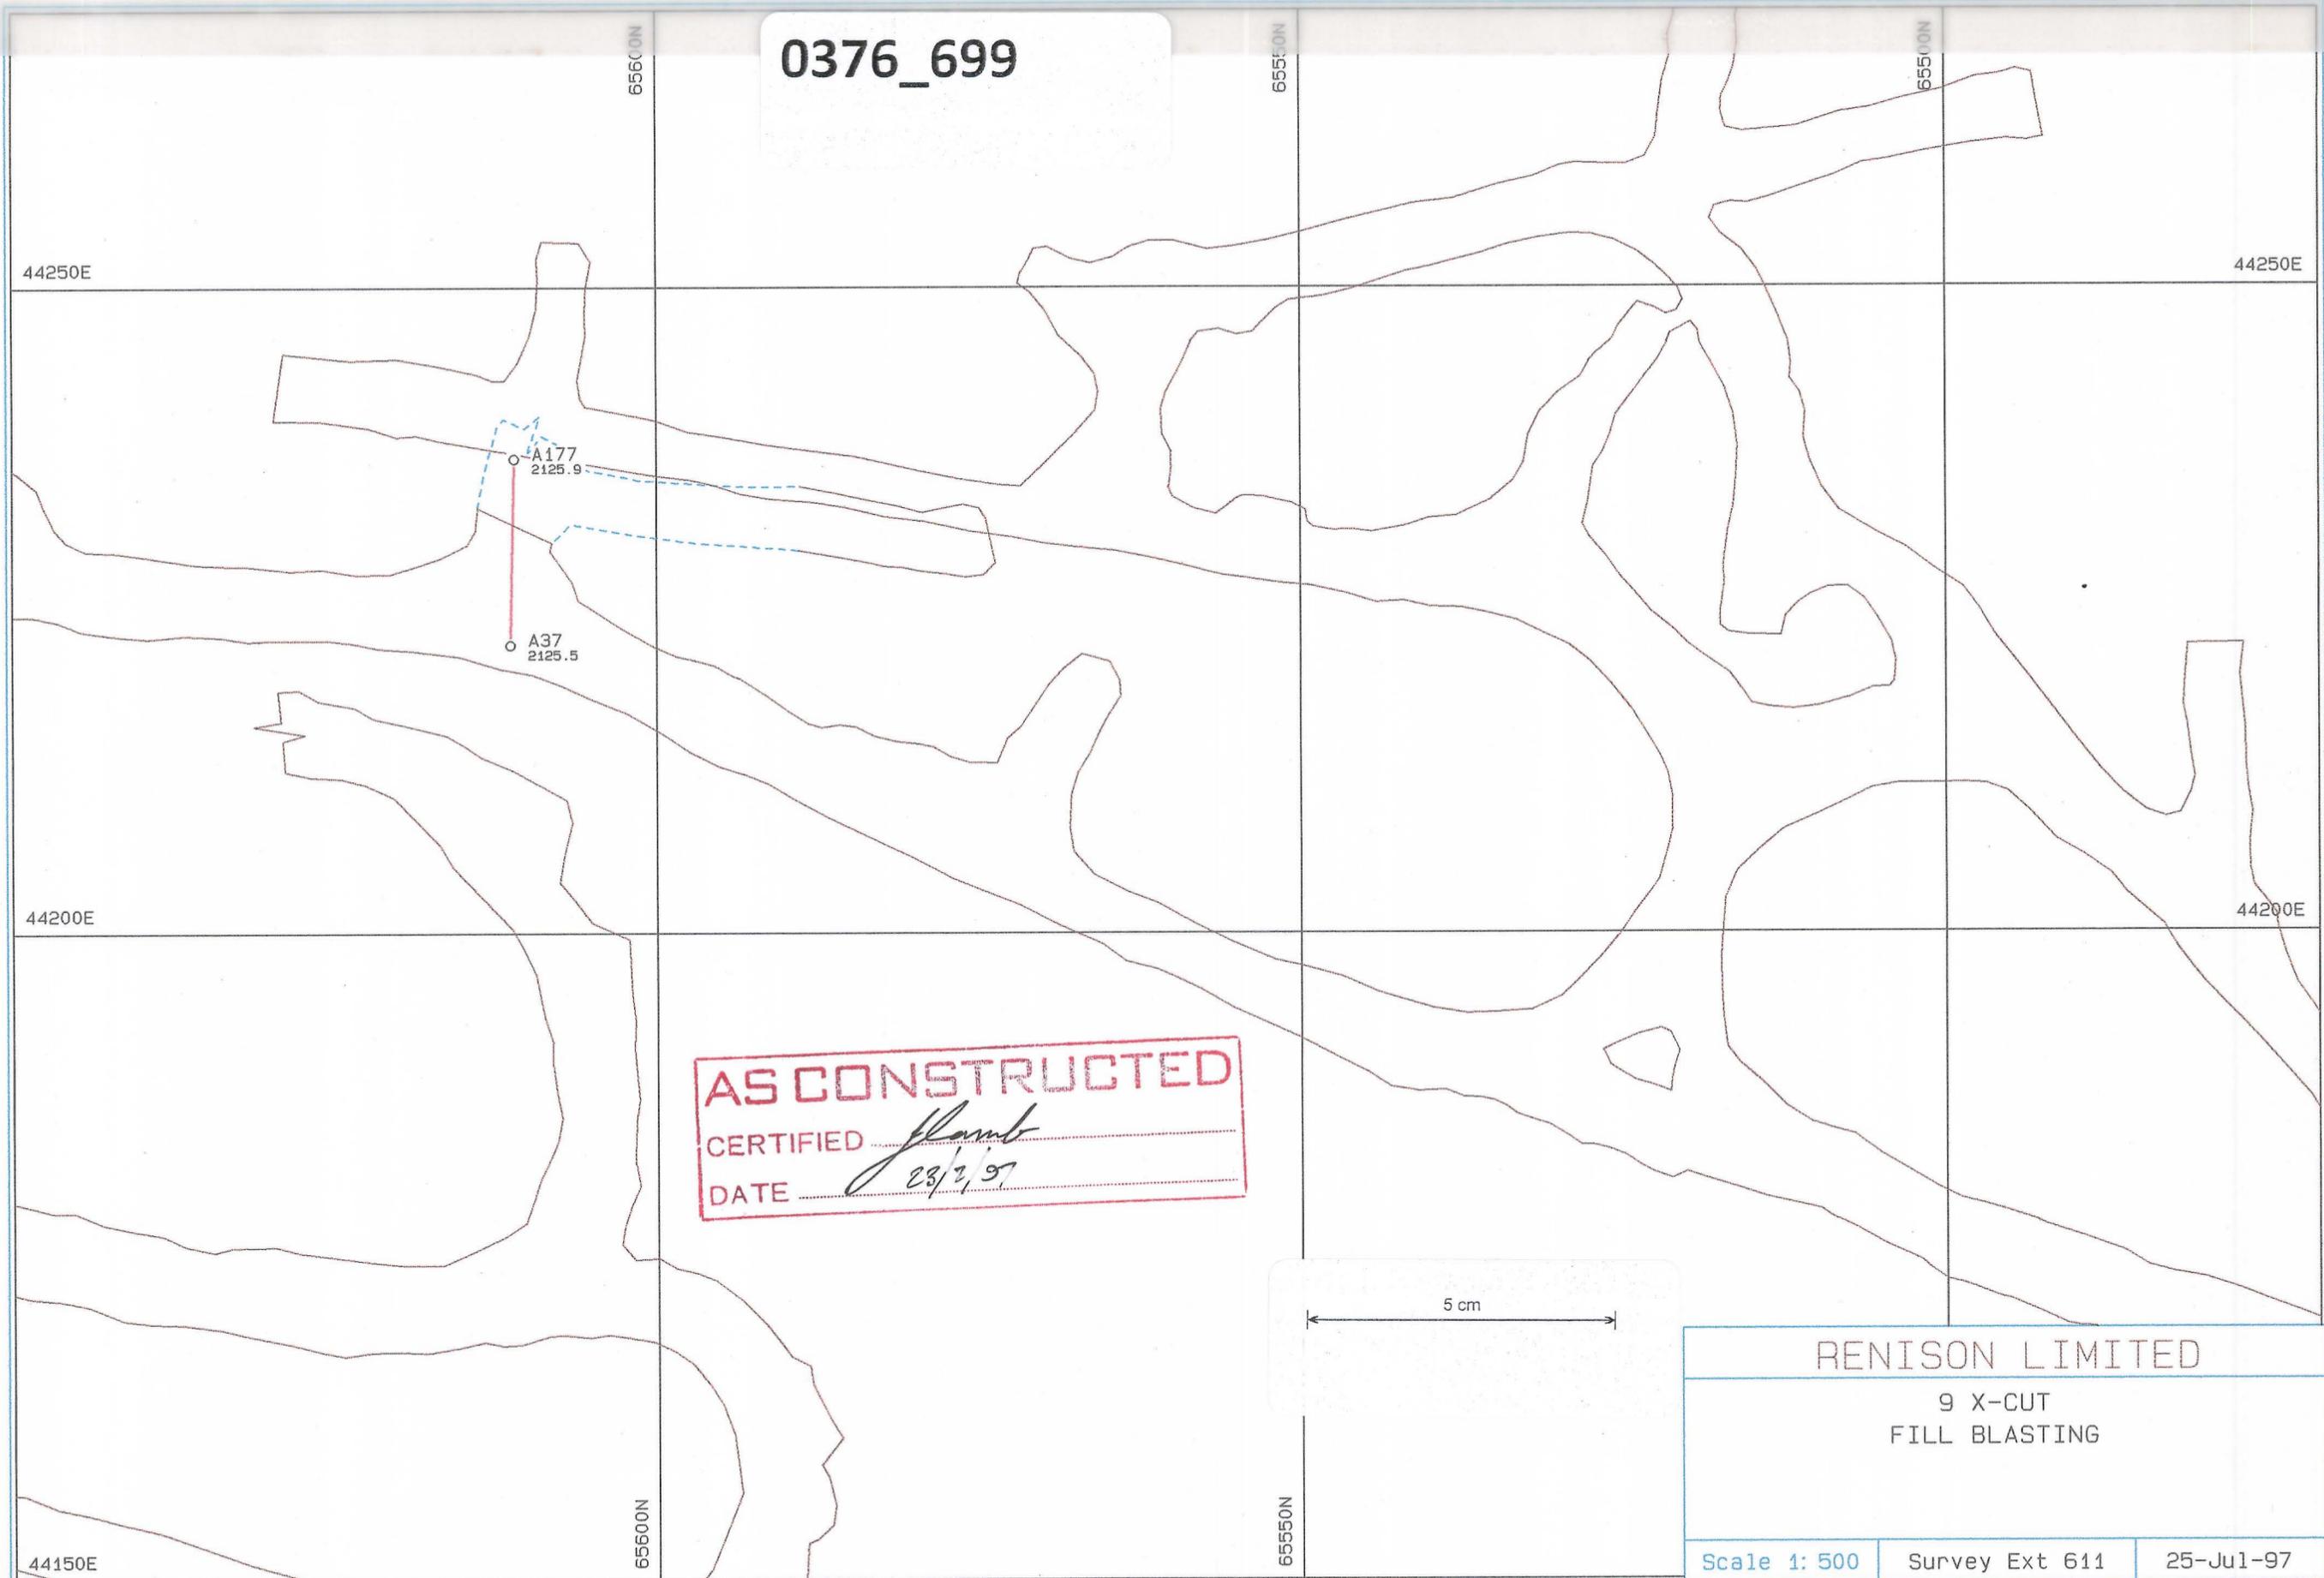

AS CONSTRUCTED
 CERTIFIED *[Signature]*
 DATE *23/2/97*

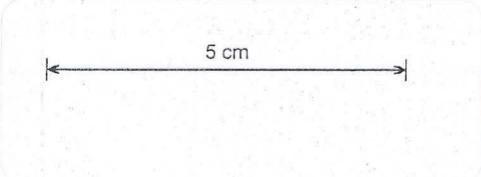

RENISON LIMITED		
9 X-CUT FILL BLASTING		
Scale 1: 500	Survey Ext 611	25-Jul-97

9xcutb.pf