


AS CONSTRUCTED
CERTIFIED *J. Smith*
DATE *6/8/97*

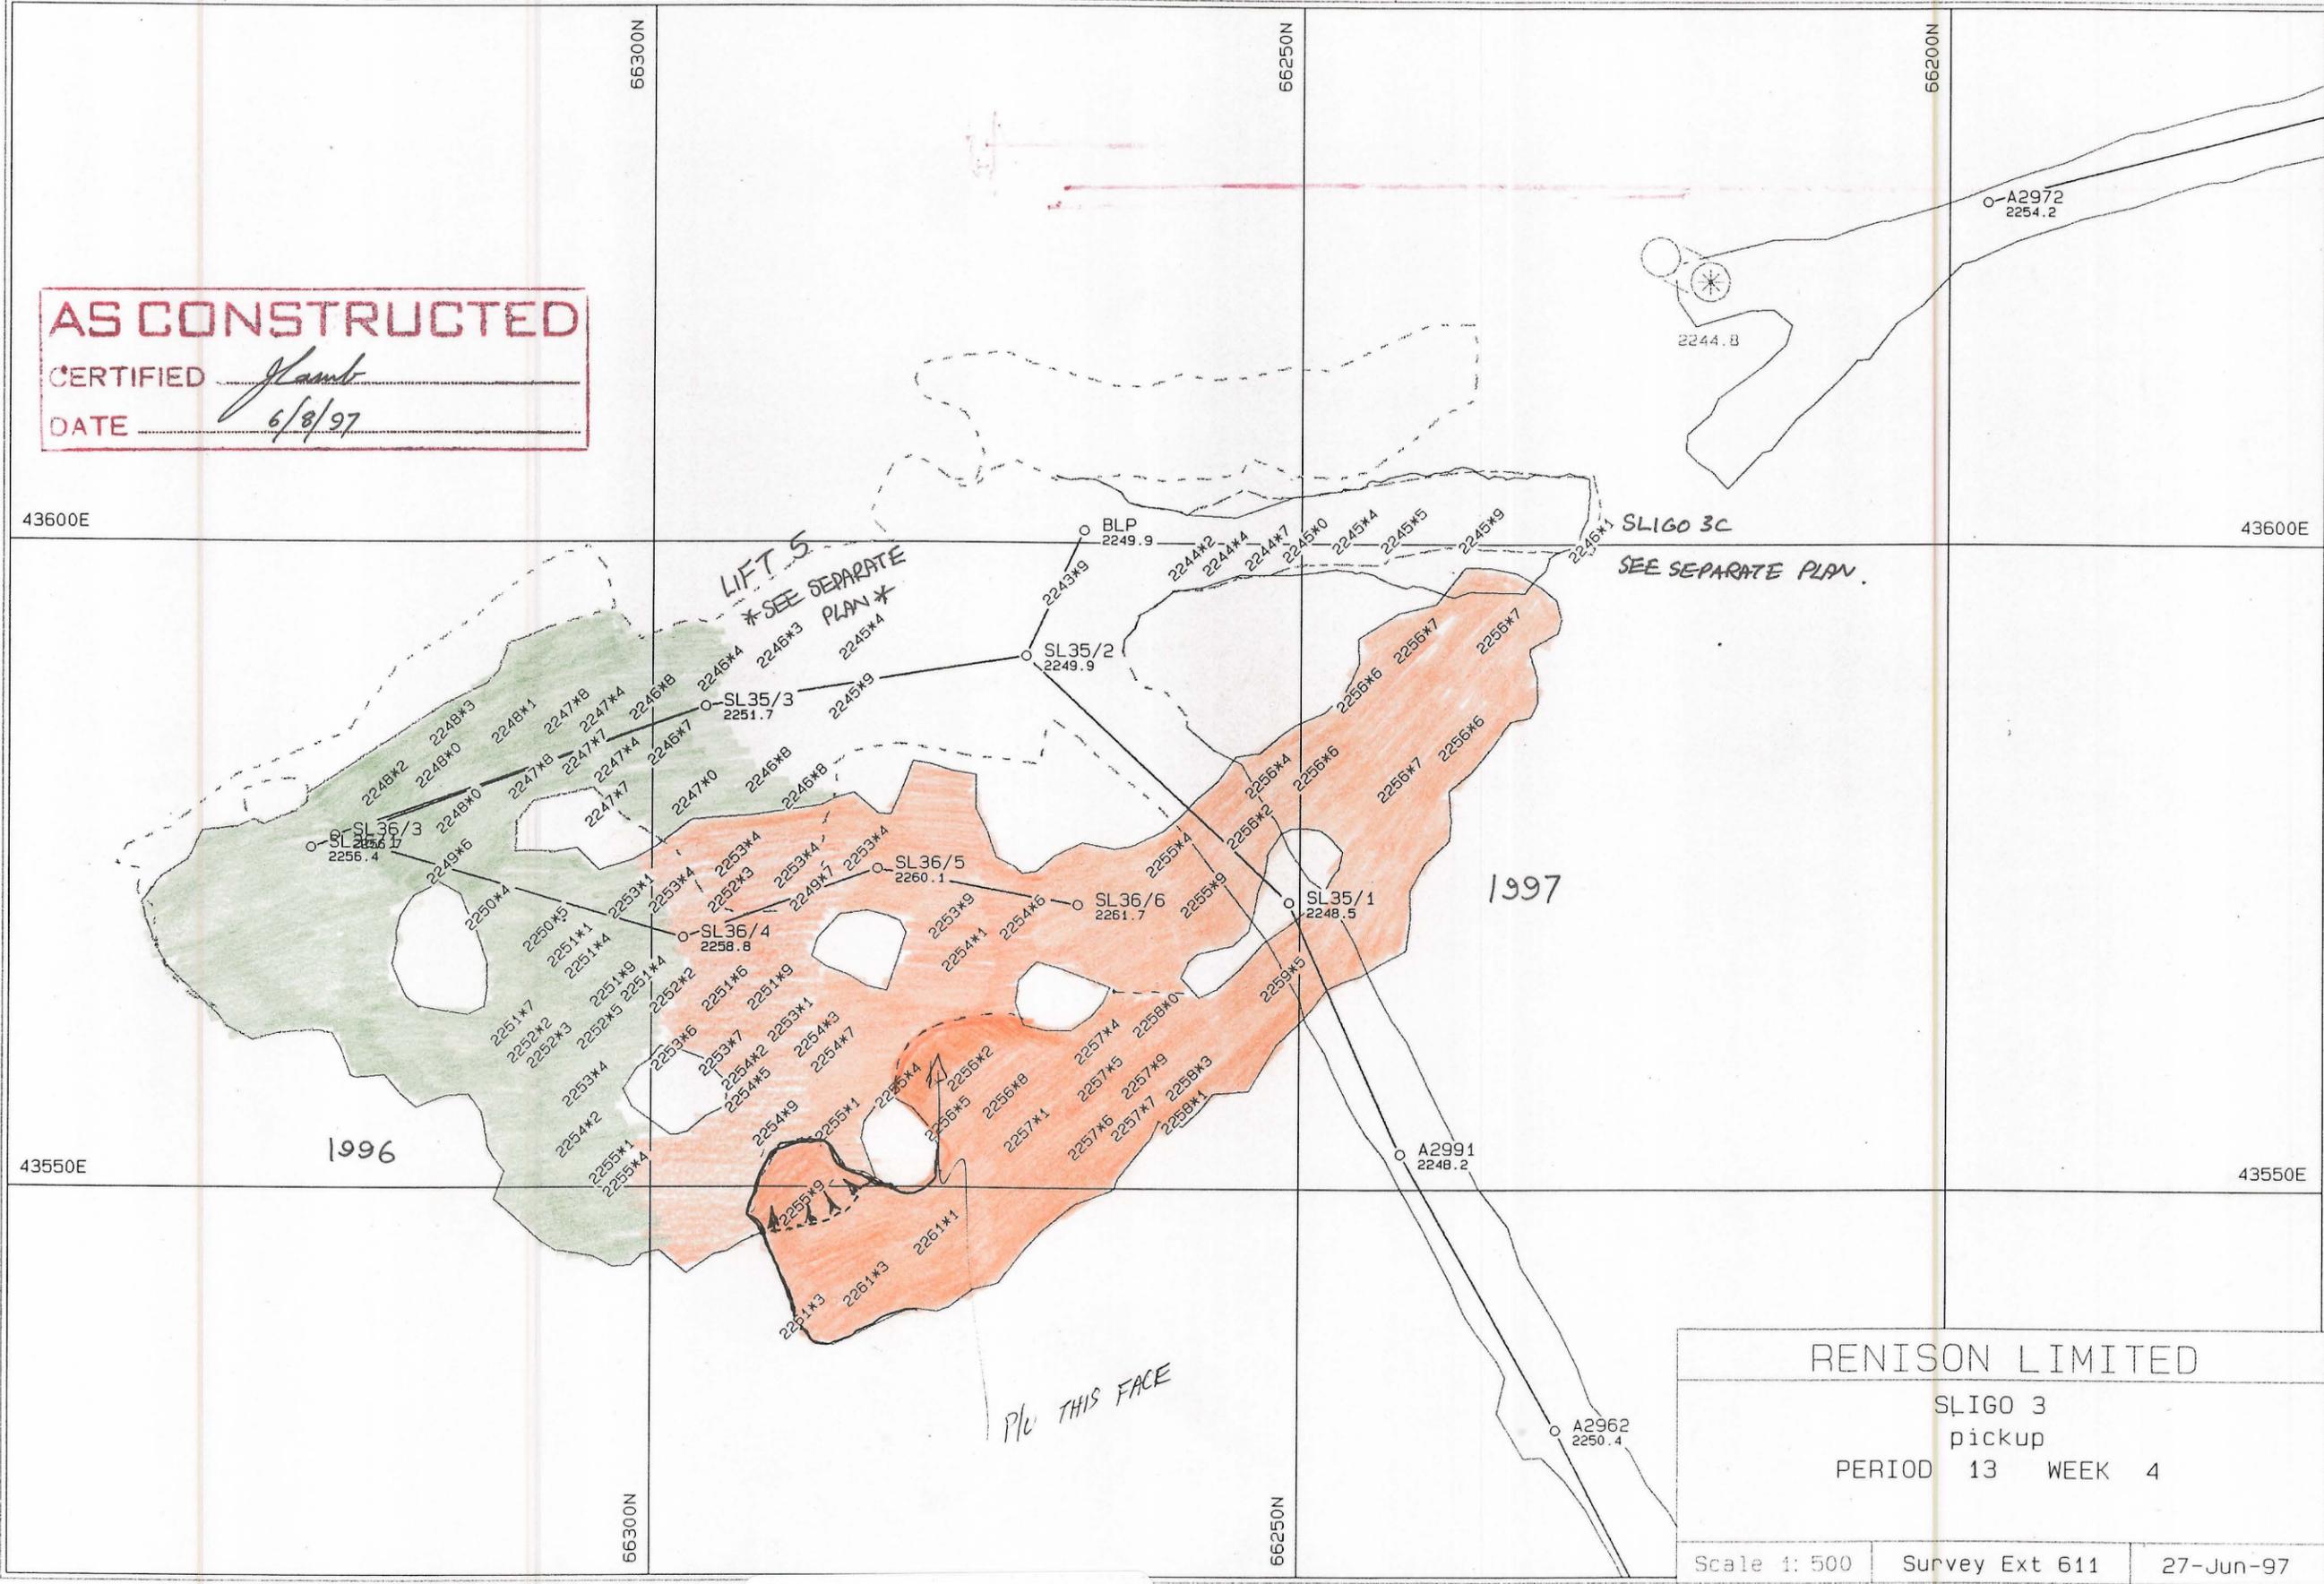

RENISON LIMITED		
SLIGO 3 pickup		
PERIOD 13 WEEK 4		
Scale 1: 500	Survey Ext 611	27-Jun-97

sligo3b.pf

