


AS CONSTRUCTED
CERTIFIED *Glenn*
DATE *6/8/97*

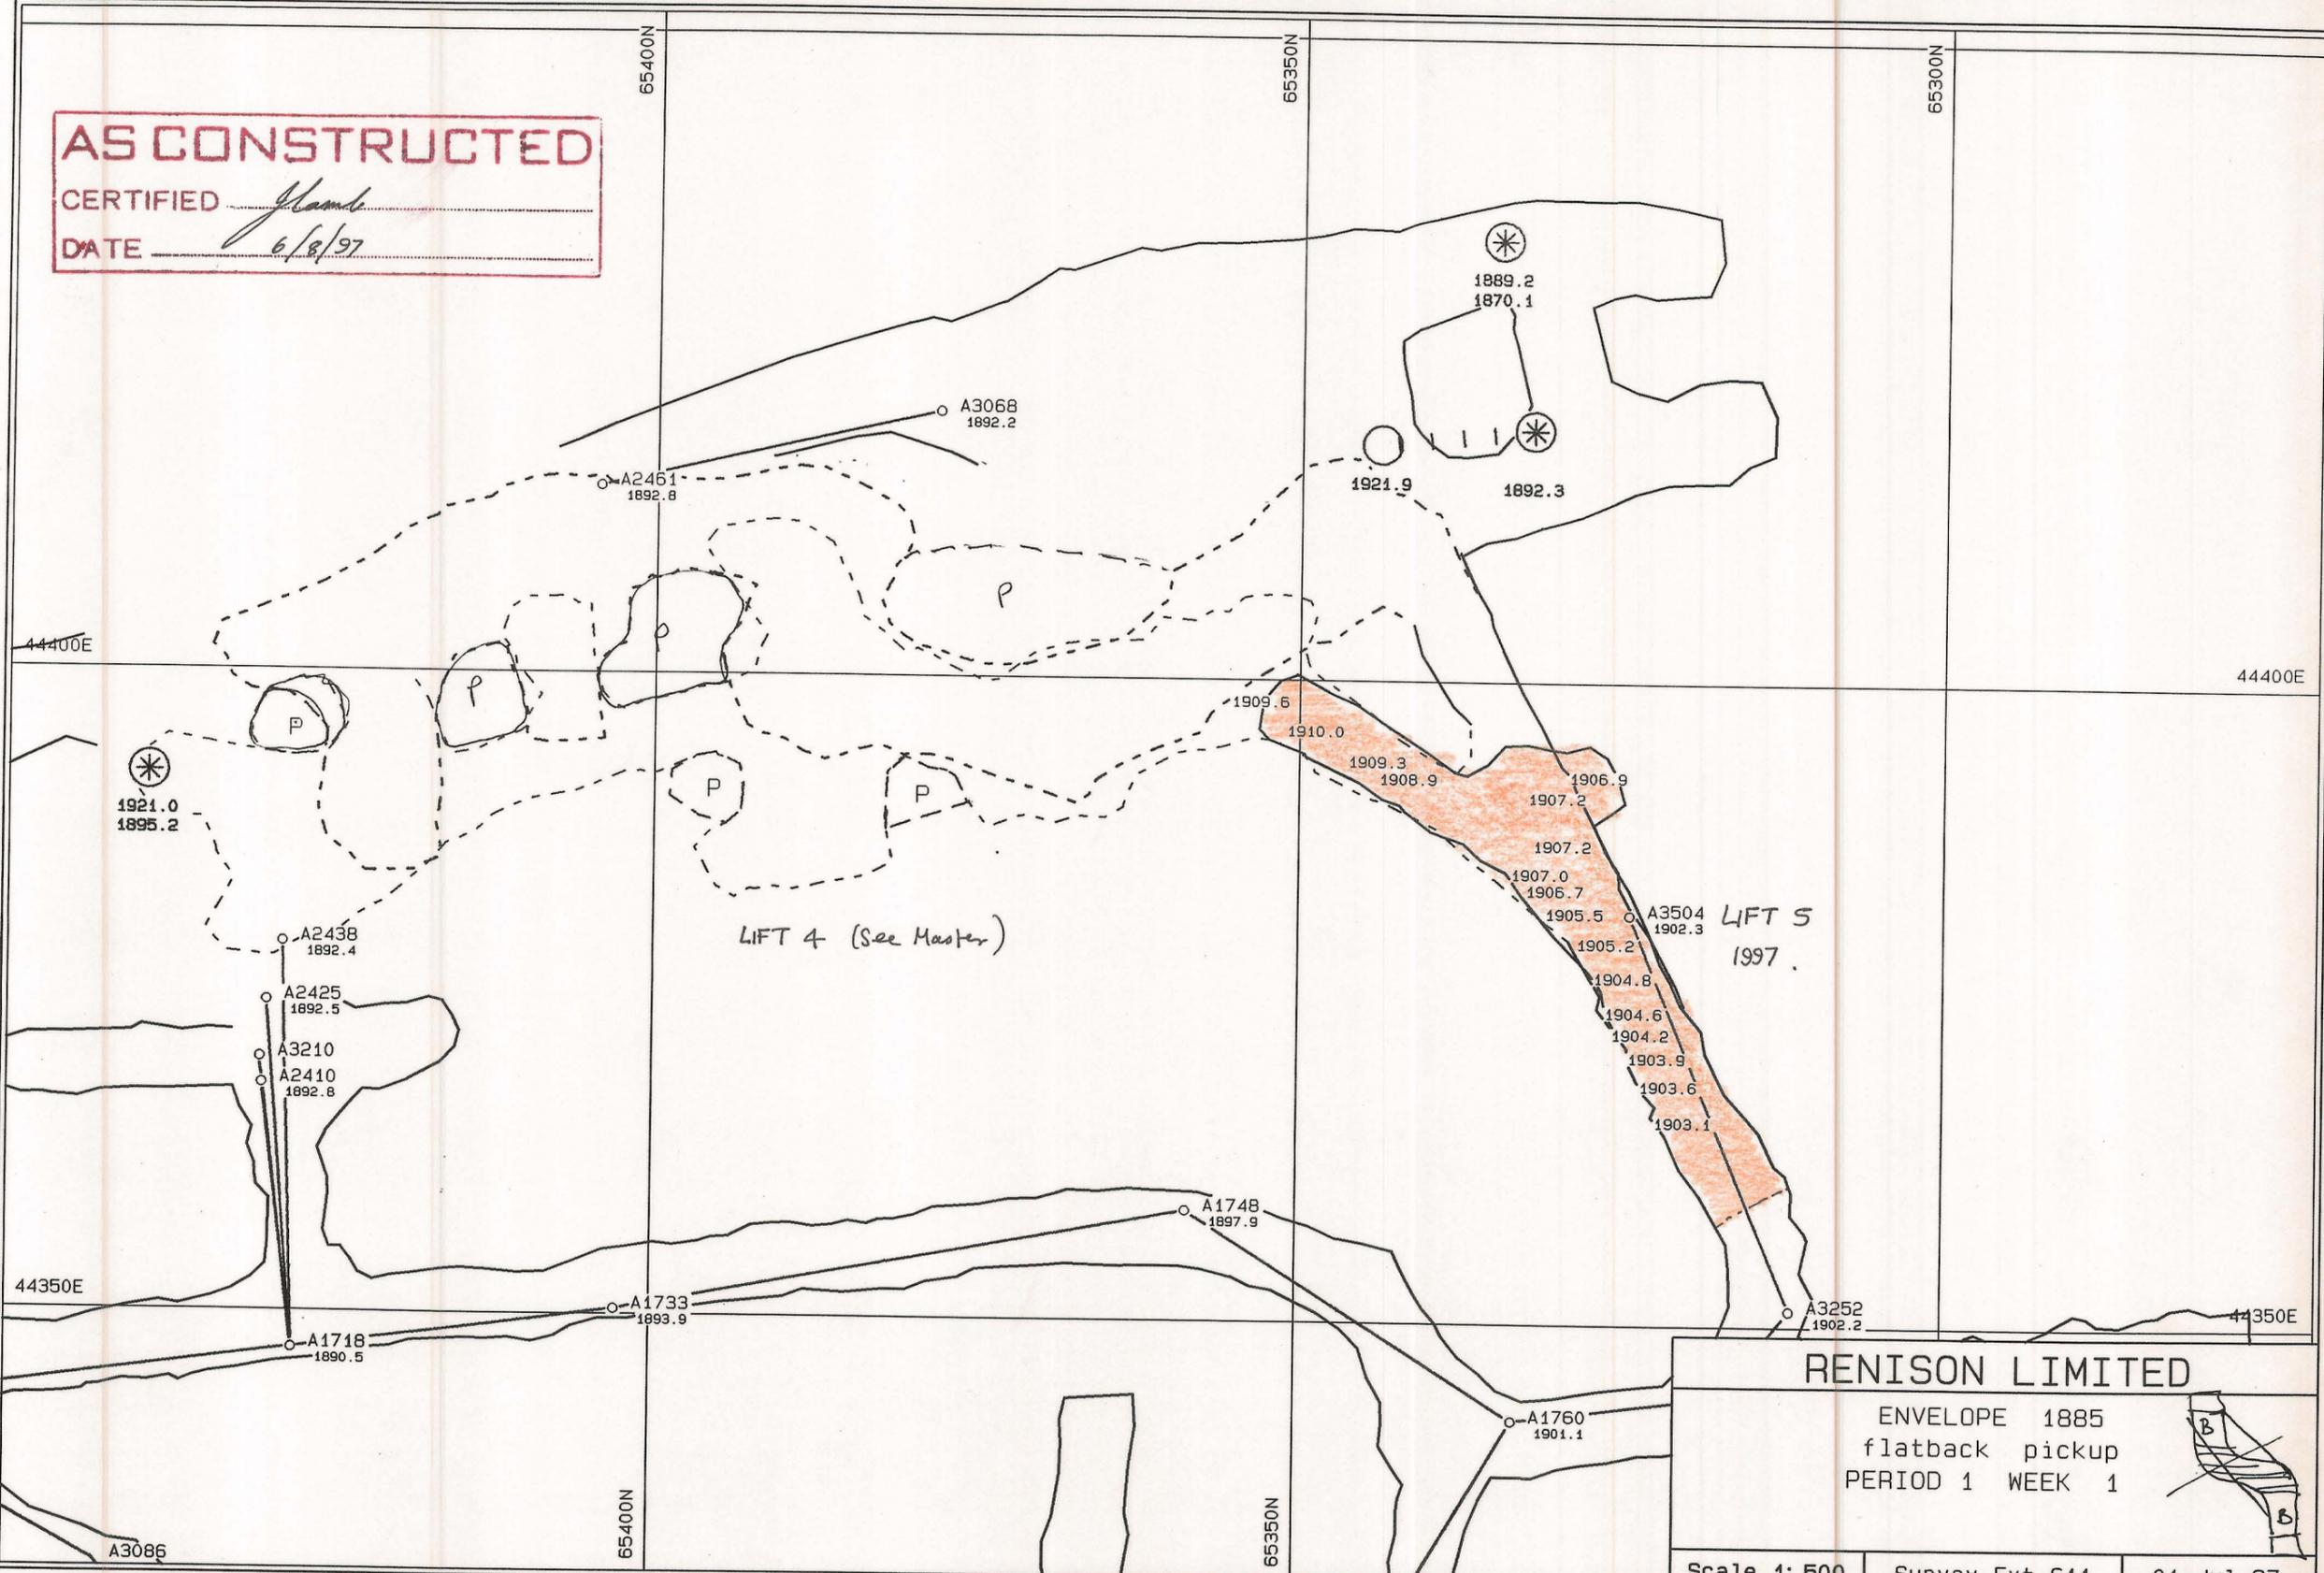

RENISON LIMITED
 ENVELOPE 1885
 flatback pickup
 PERIOD 1 WEEK 1

Scale 1: 500 Survey Ext 611 01-Jul-97

envelopd.pf

