


0376_706

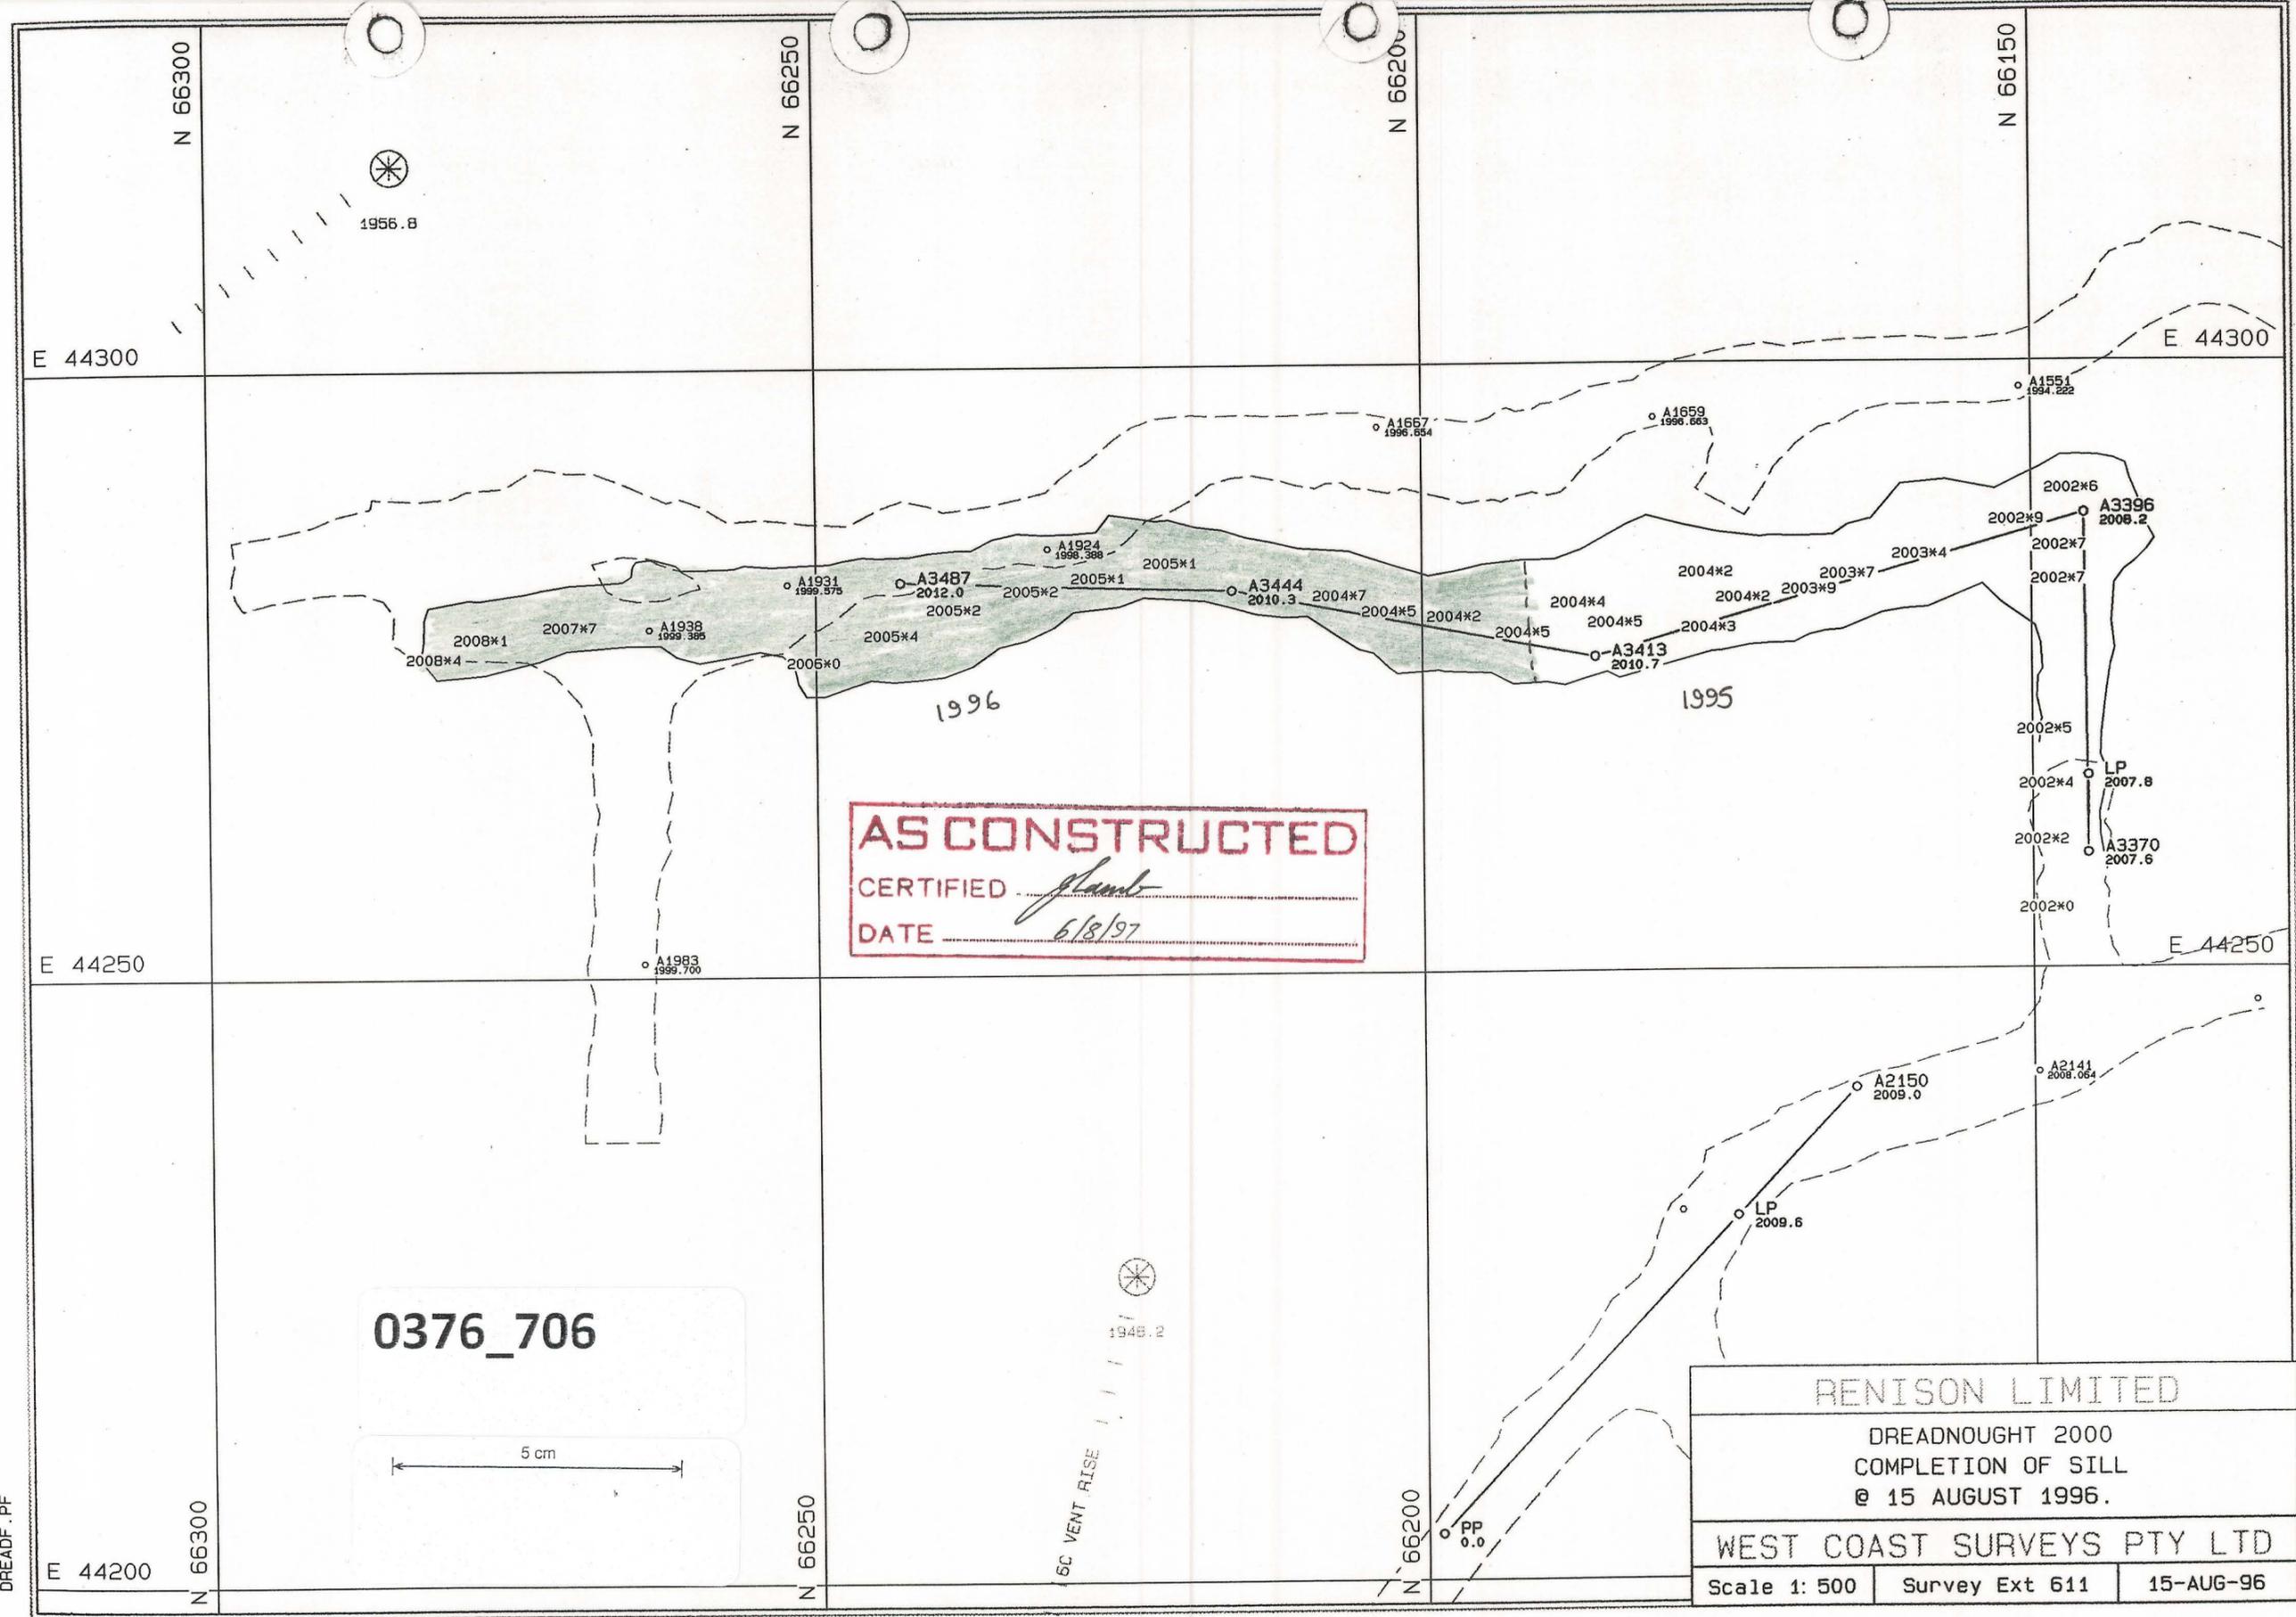

AS CONSTRUCTED
 CERTIFIED *[signature]*
 DATE 6/8/97

0376_706

5 cm

RENISON LIMITED

DREADNOUGHT 2000
 COMPLETION OF SILL
 @ 15 AUGUST 1996.

WEST COAST SURVEYS PTY LTD

Scale 1: 500 | Survey Ext 611 | 15-AUG-96

DREADF.PF