


0376\_707

5 cm

**AS CONSTRUCTED**  
CERTIFIED *Glamb*  
DATE *6/8/97*

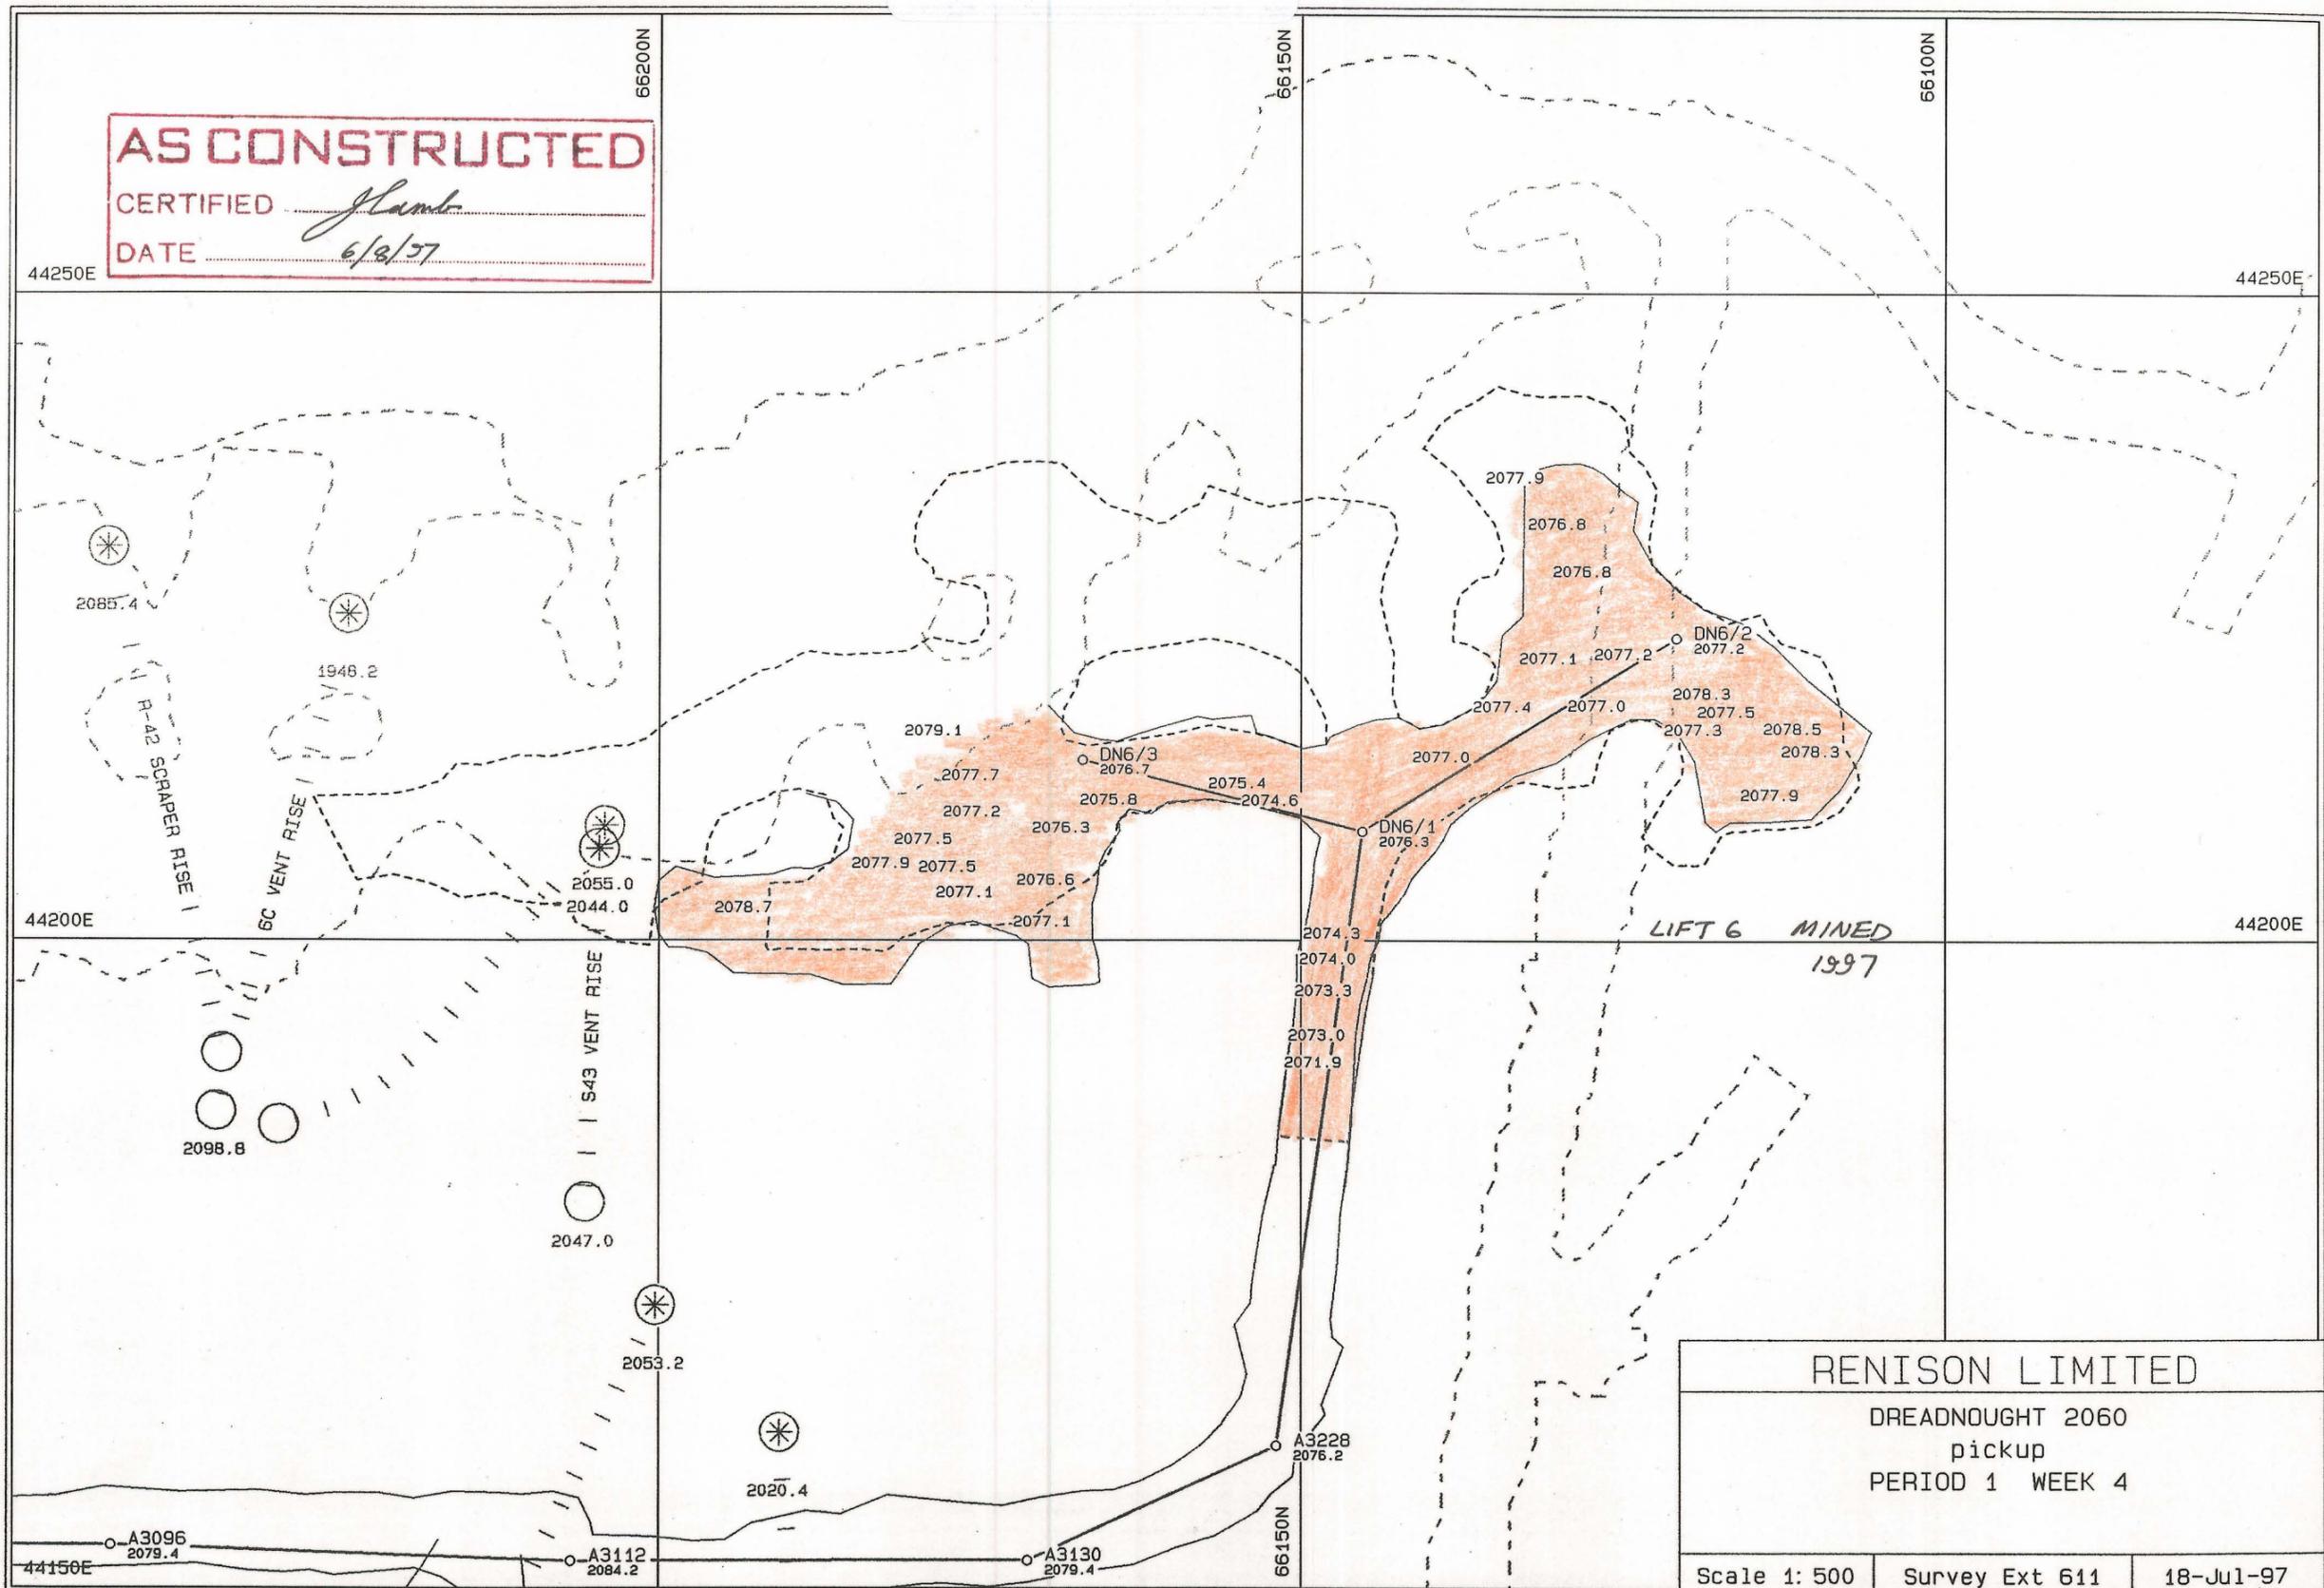

RENISON LIMITED		
DREADNOUGHT 2060 pickup PERIOD 1 WEEK 4		
Scale 1: 500	Survey Ext 611	18-Jul-97

dreadnoug.pf

0376\_707