


0376_709

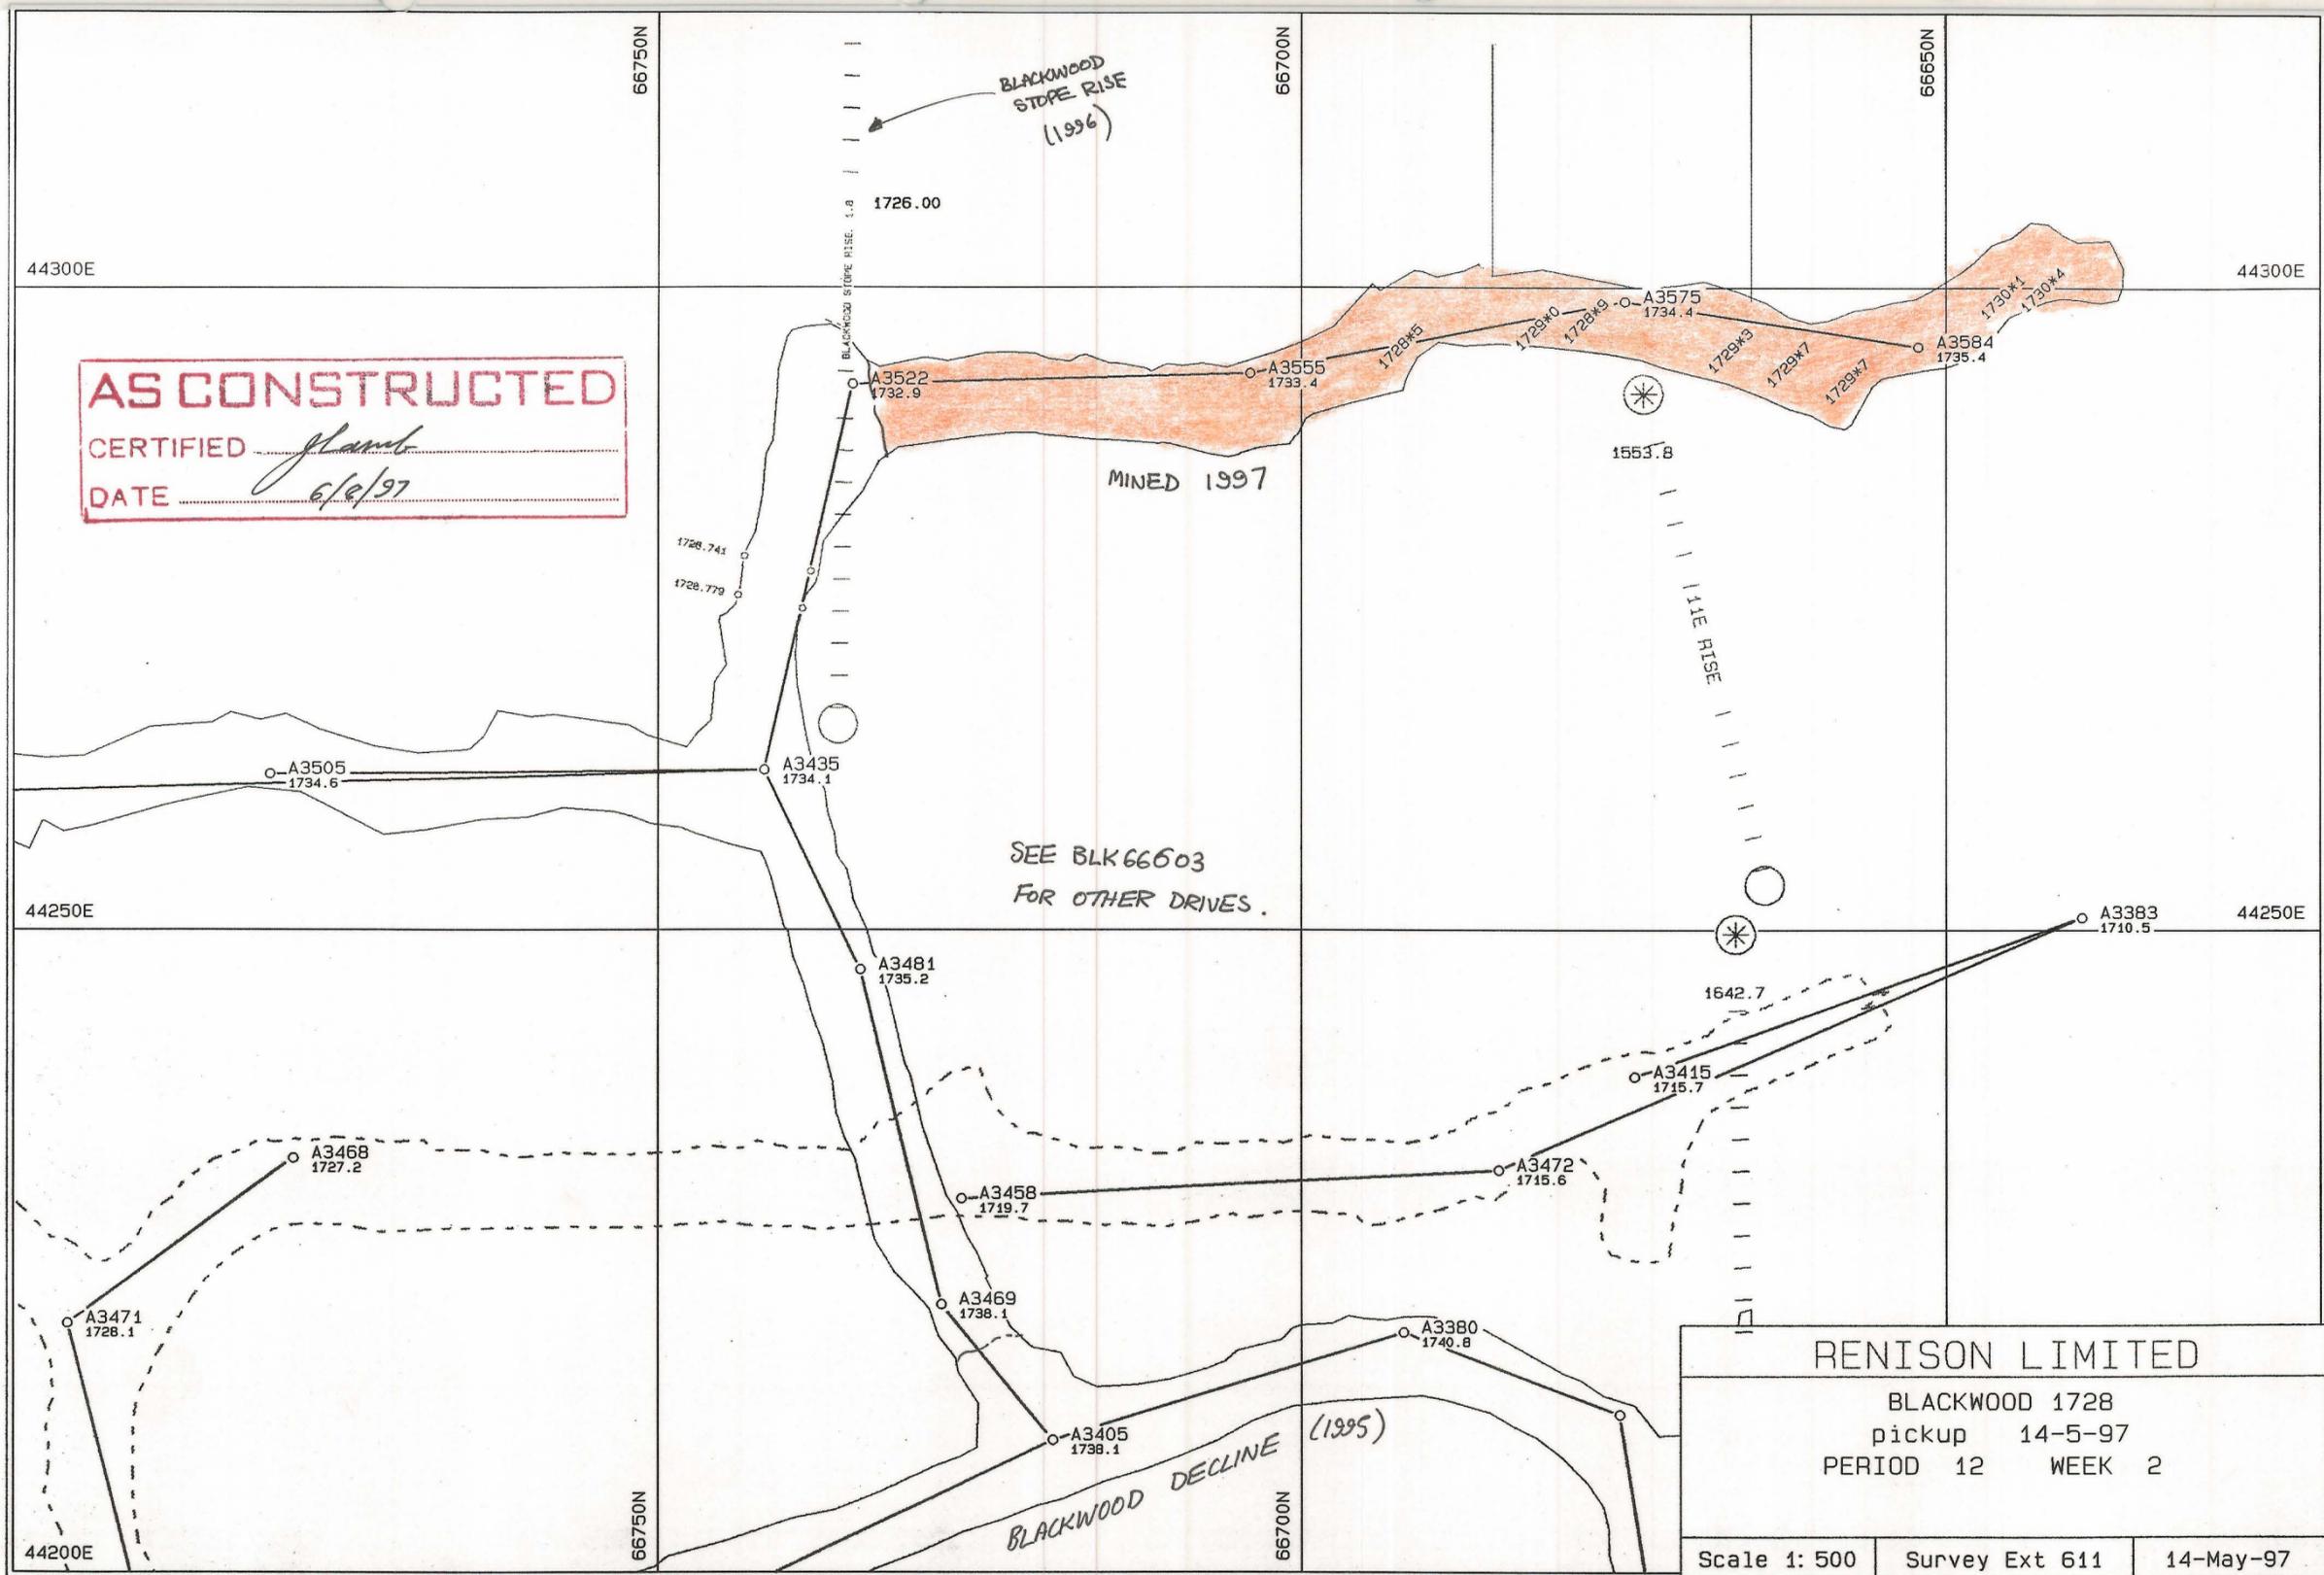

blackwod.pf

SURPAC SOFTWARE INTERNATIONAL. AUSTRALIA

0376_709