


0376_710

0376_710

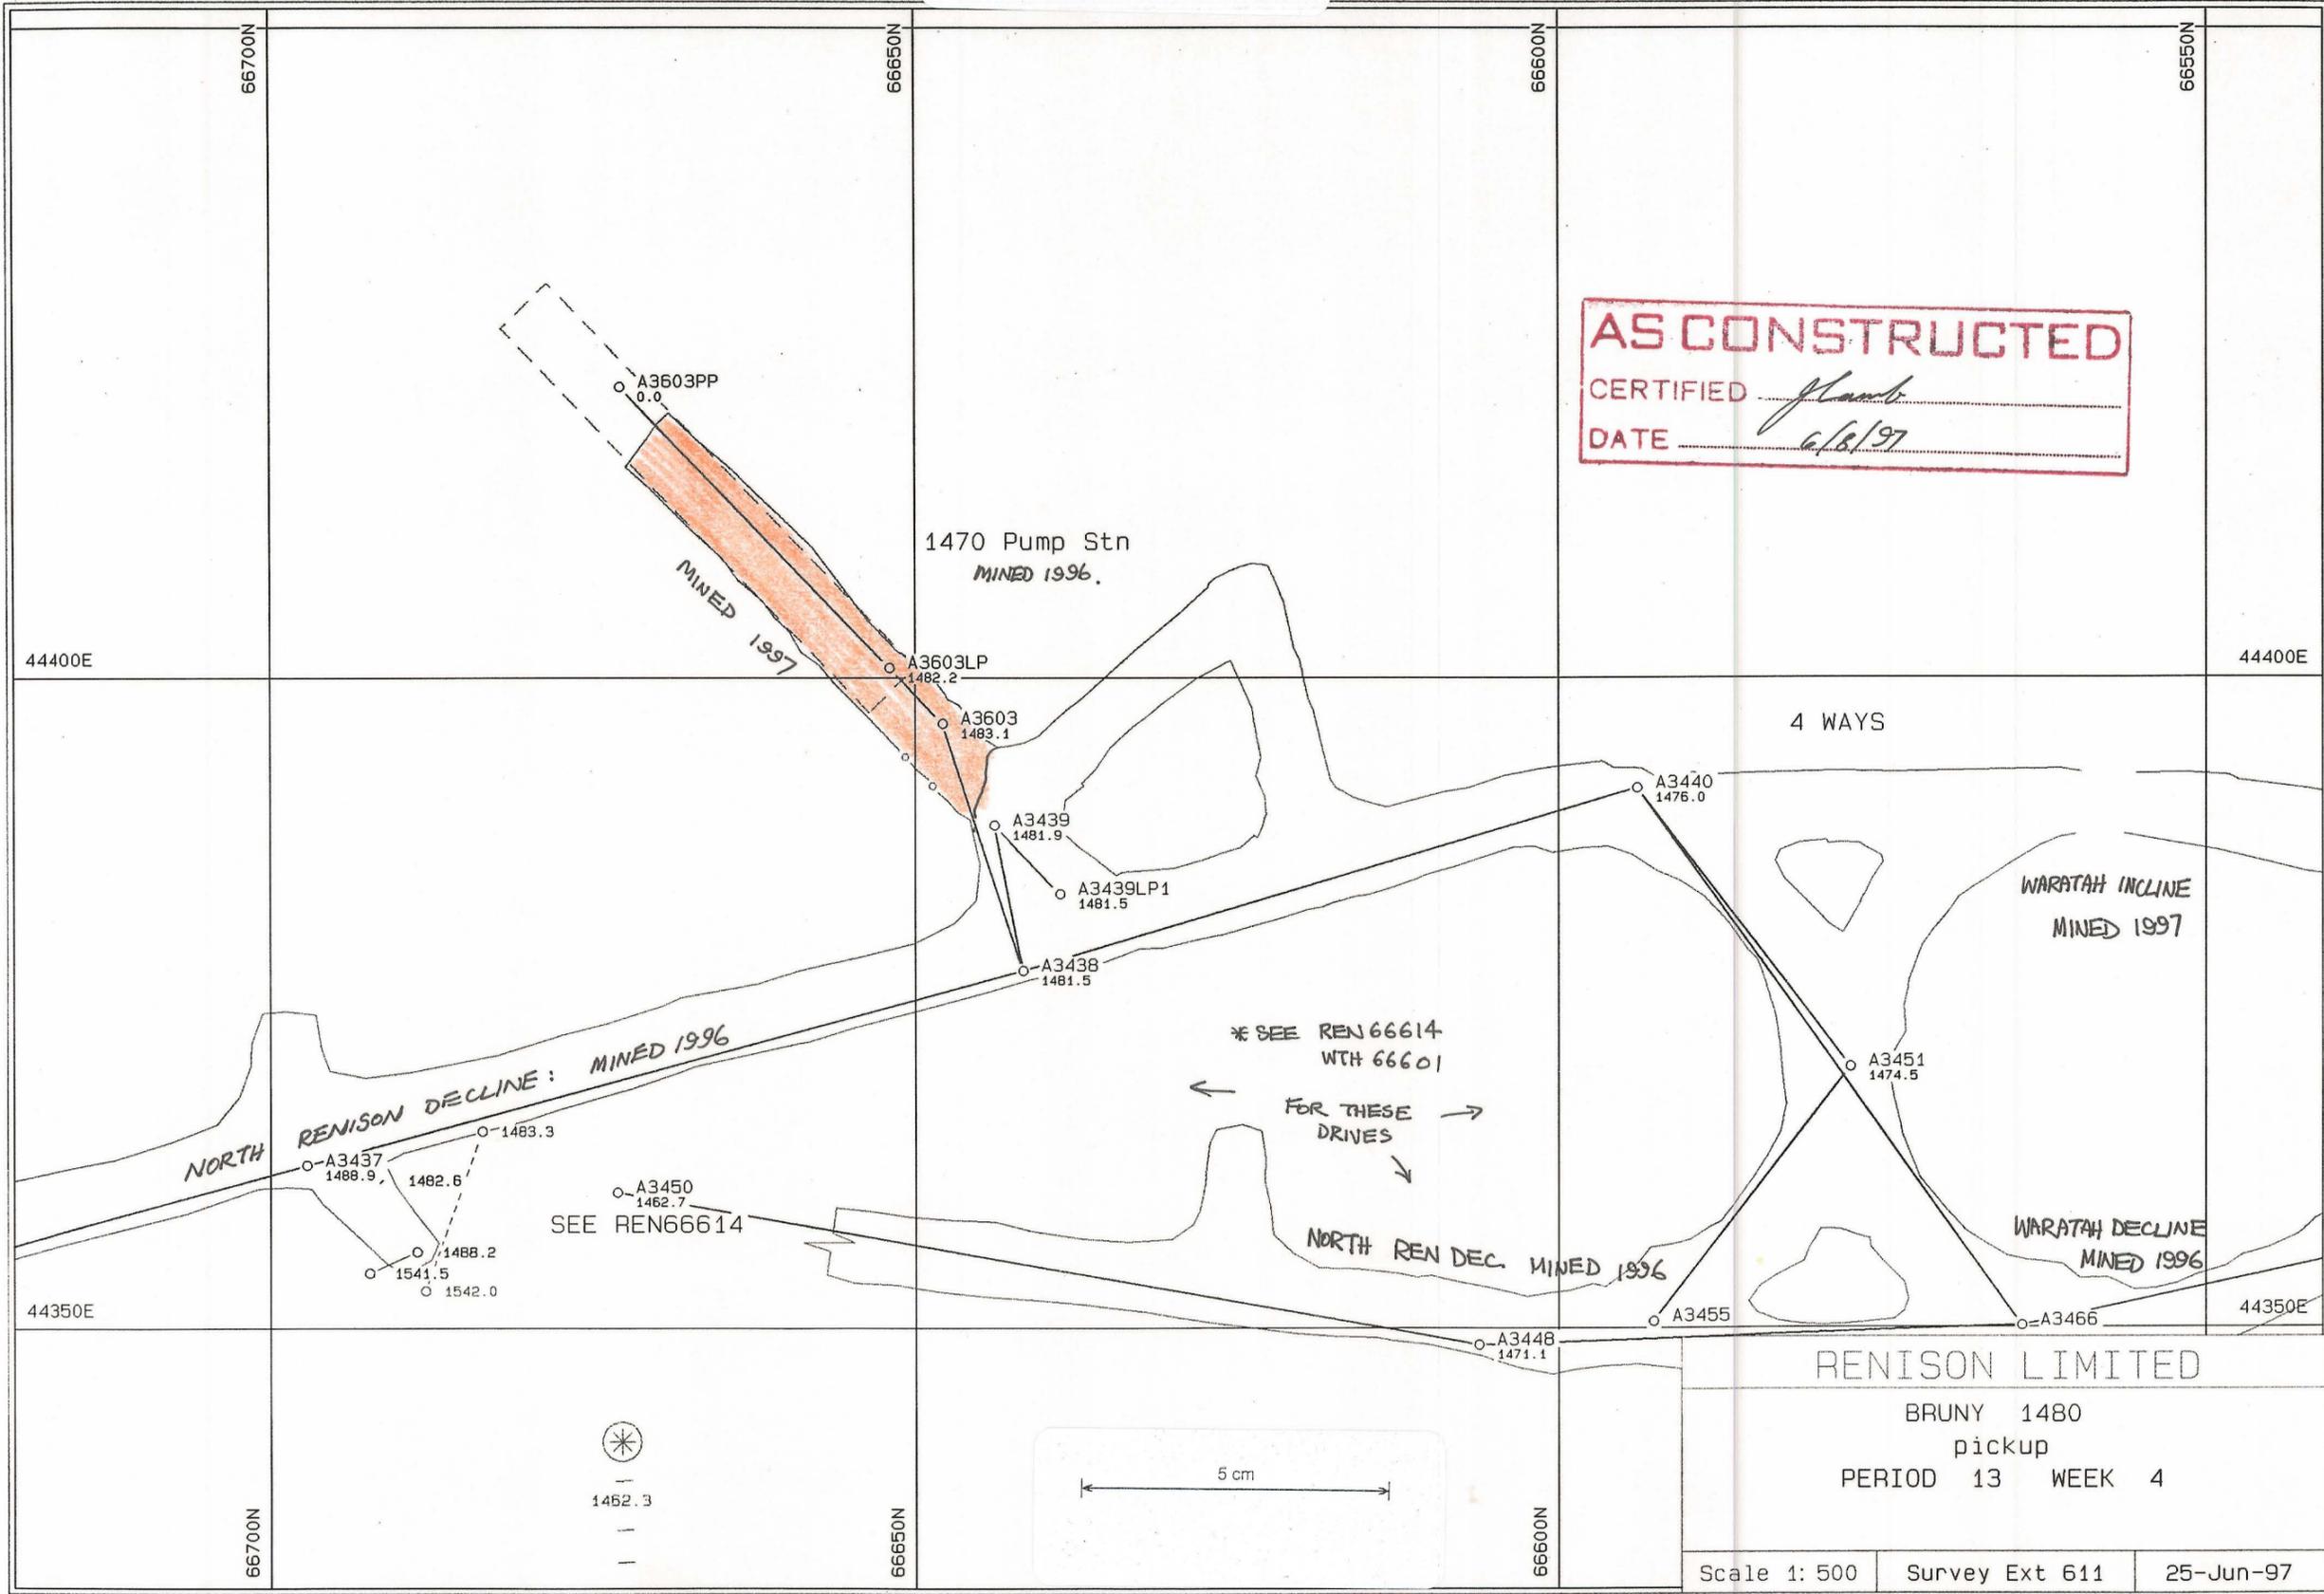

AS CONSTRUCTED
 CERTIFIED *[signature]*
 DATE 6/6/97

4 WAYS

WARATAH INCLINE
MINED 1997

WARATAH DECLINE
MINED 1996

NORTH RENISON DECLINE: MINED 1996

* SEE REN66614
WITH 66601
FOR THESE
DRIVES

NORTH REN DEC. MINED 1996

RENISON LIMITED

BRUNY 1480
pickup
PERIOD 13 WEEK 4

Scale 1: 500 | Survey Ext 611 | 25-Jun-97

northbrc.pt