


0376_711

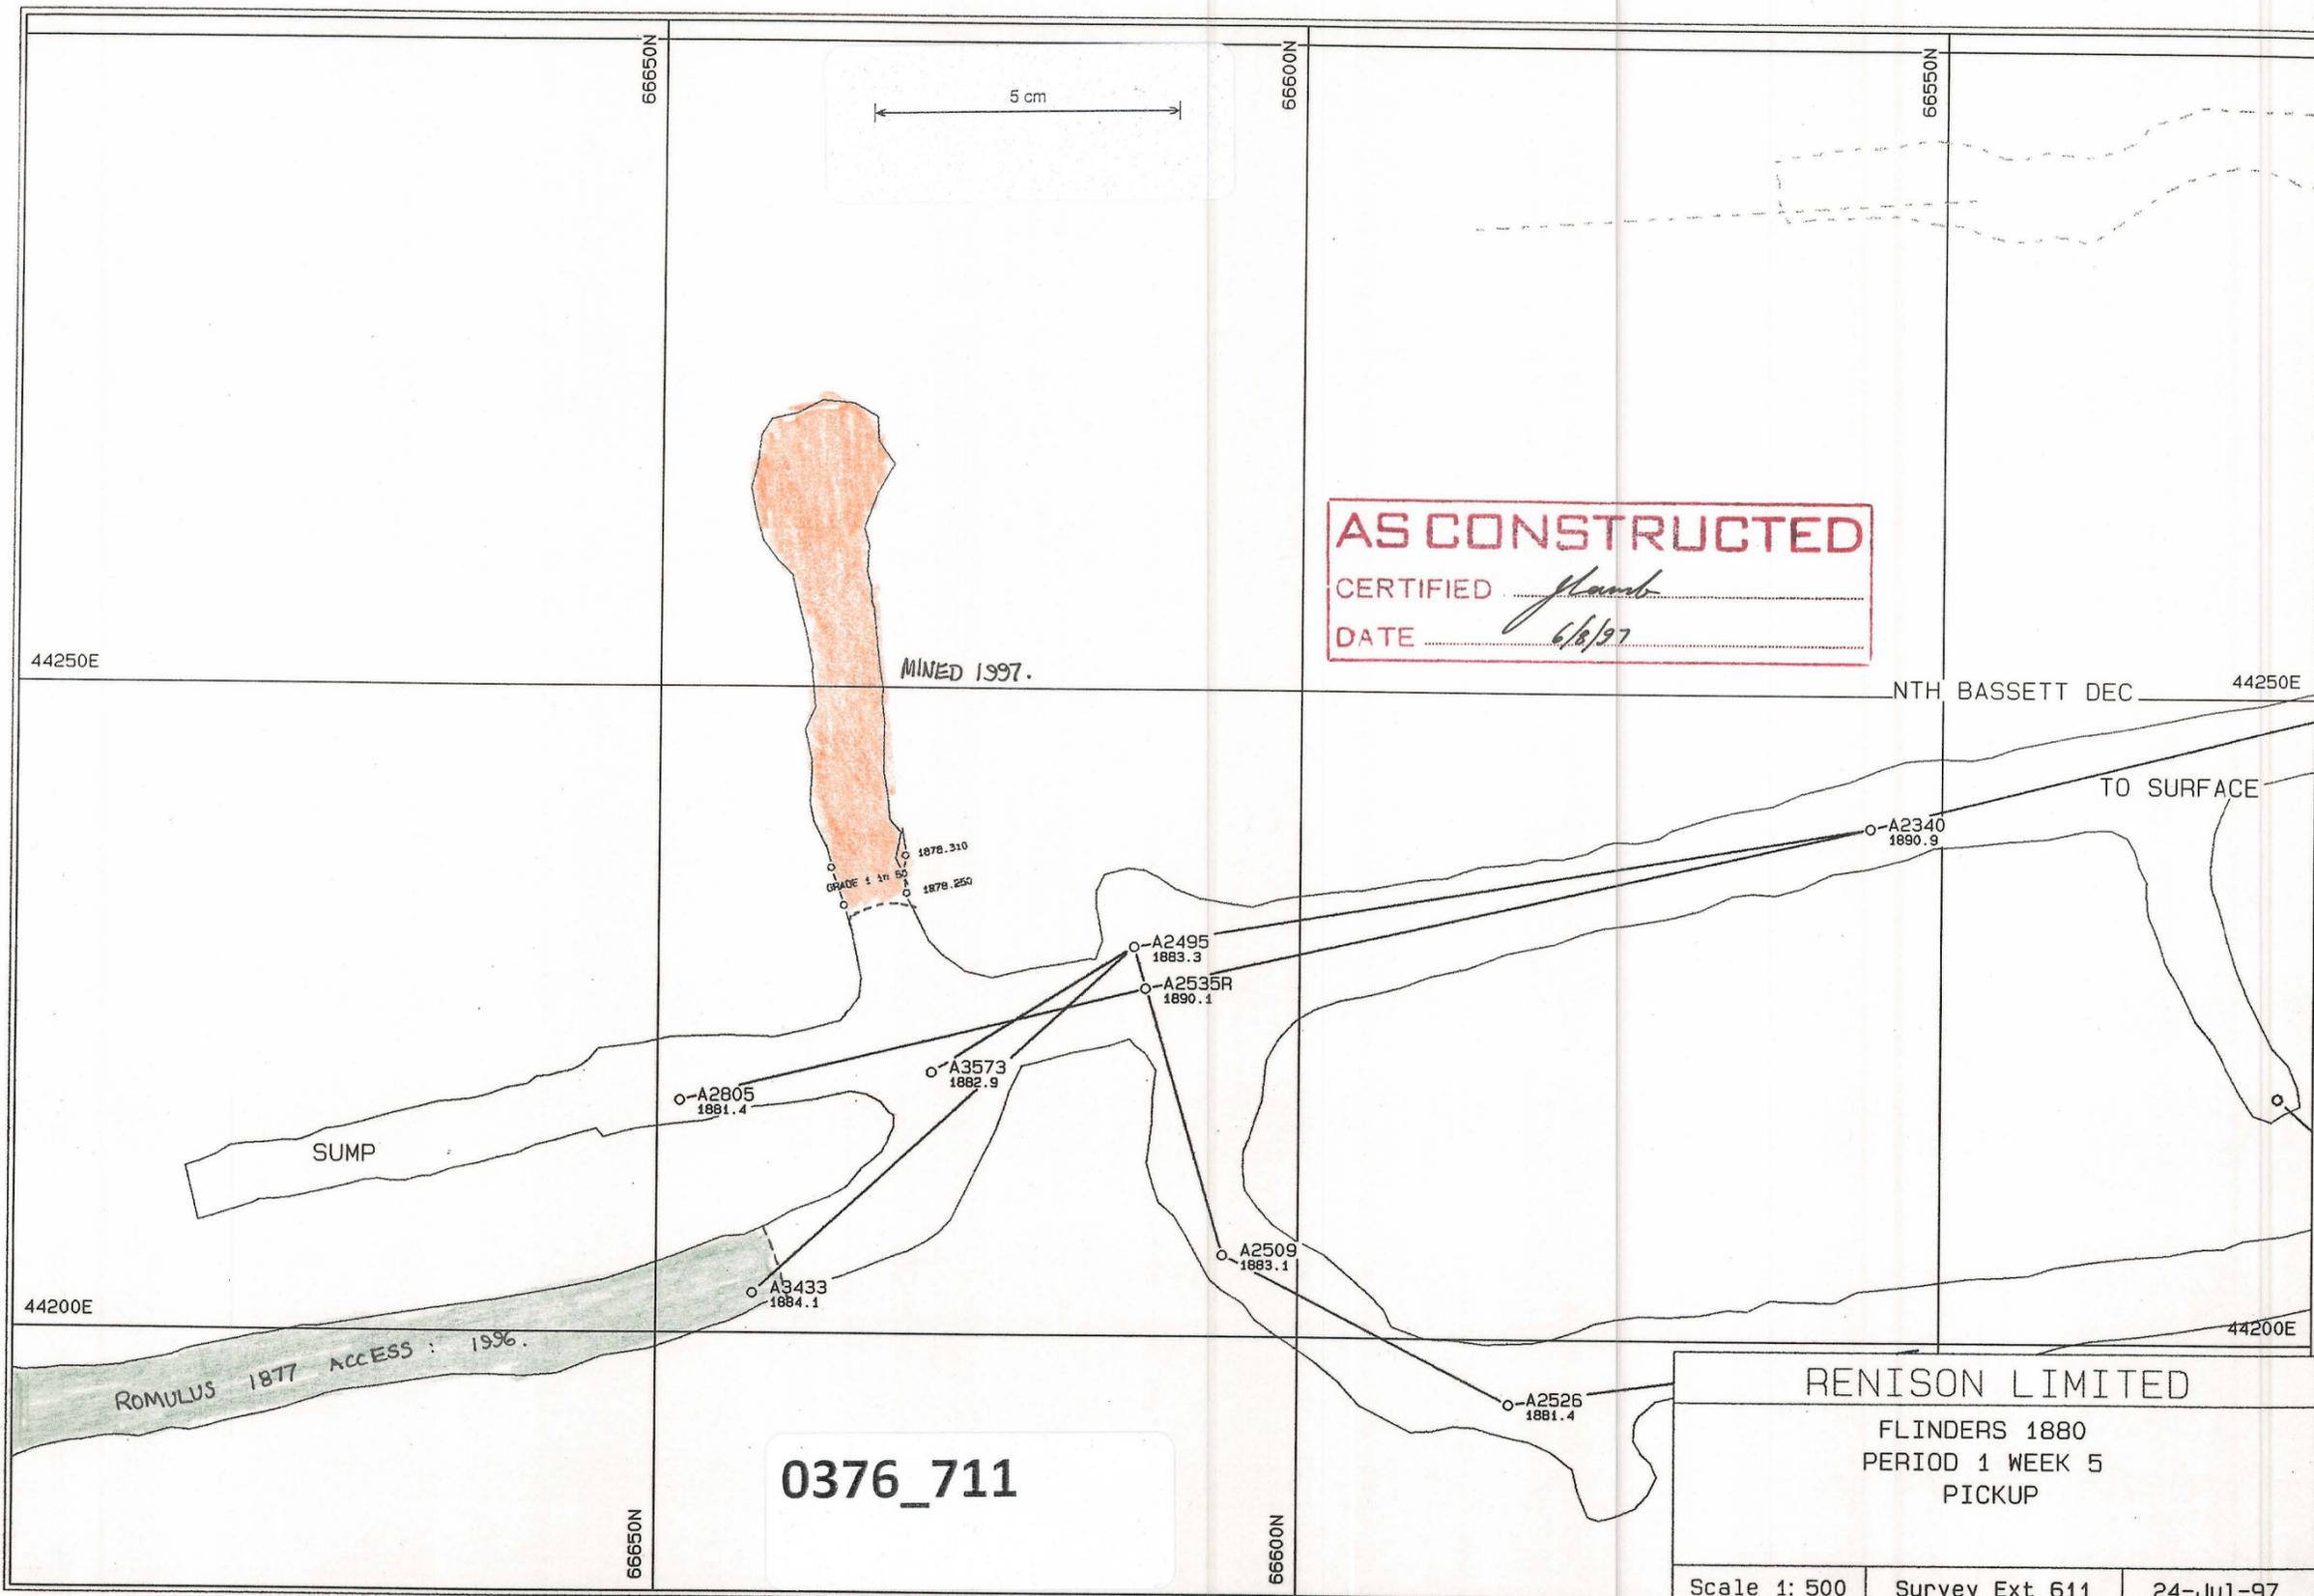

AS CONSTRUCTED
 CERTIFIED *flamb*
 DATE *6/8/97*

0376_711

RENISON LIMITED

FLINDERS 1880
PERIOD 1 WEEK 5
PICKUP

Scale 1: 500	Survey Ext 611	24-Jul-97
--------------	----------------	-----------

northfb.pf