


0376\_712

5 cm

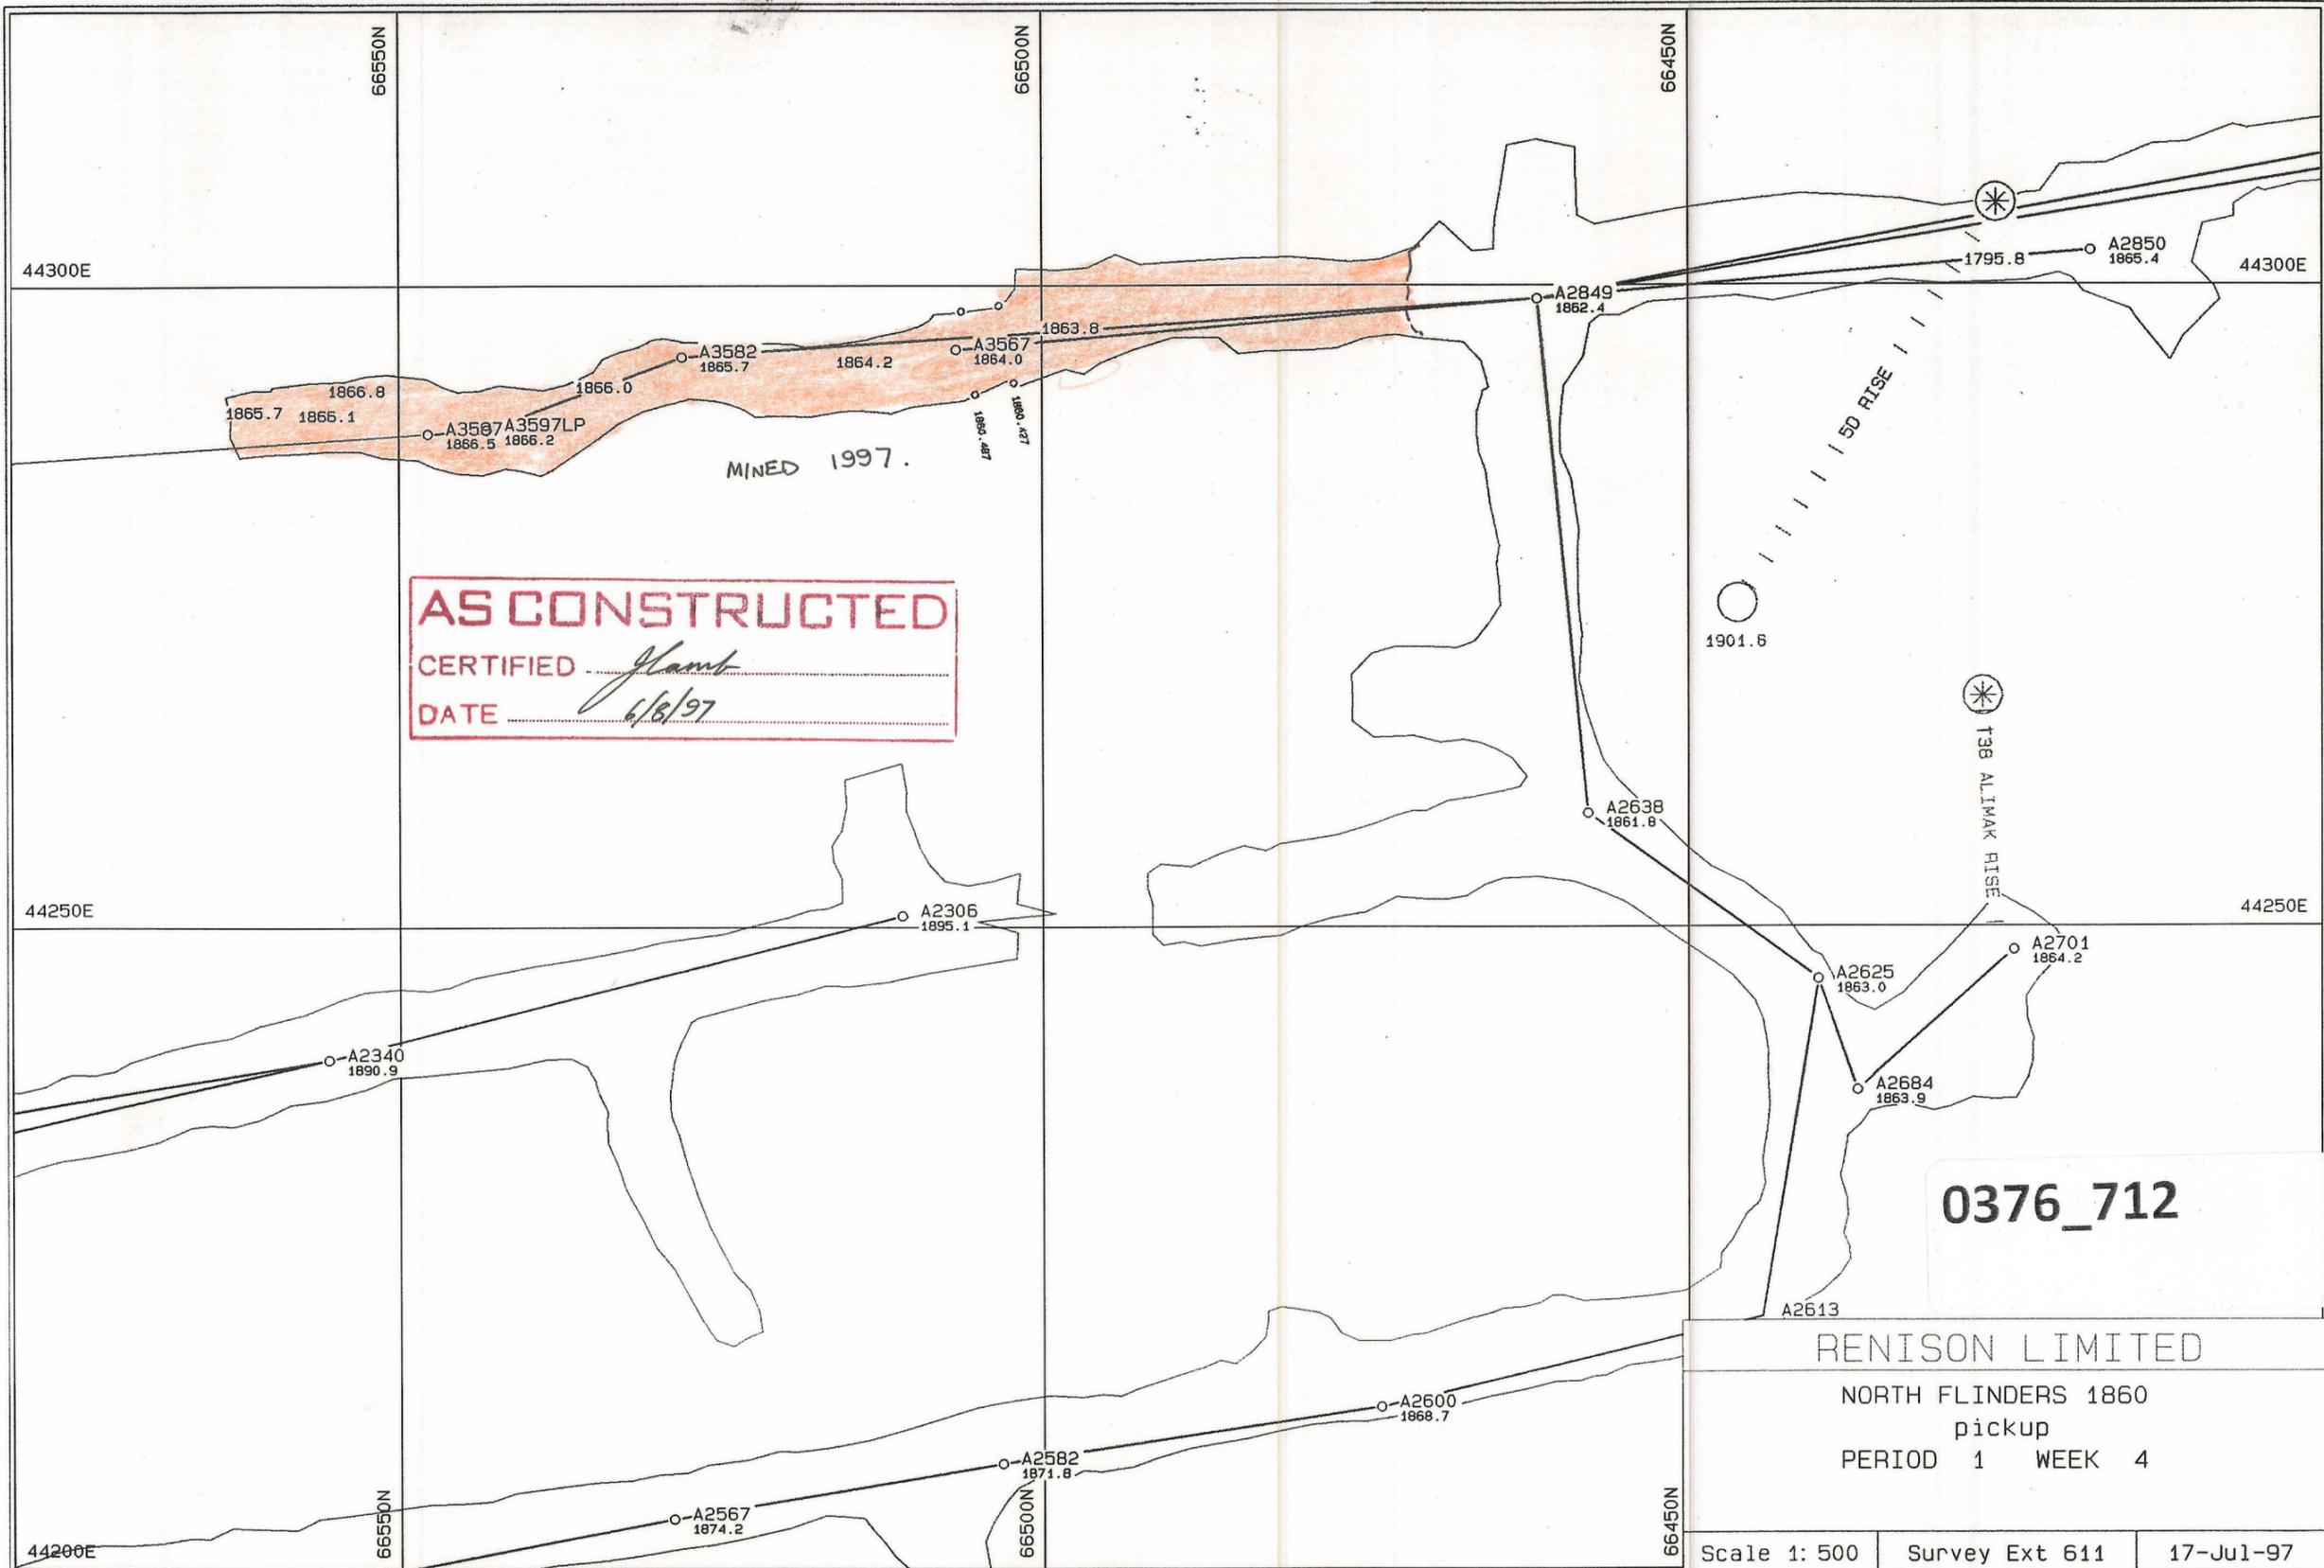

**AS CONSTRUCTED**  
 CERTIFIED *Glamb*  
 DATE *6/8/97*

0376\_712

RENISON LIMITED  
 NORTH FLINDERS 1860  
 pickup  
 PERIOD 1 WEEK 4

Scale 1: 500    Survey Ext 611    17-Jul-97