



0376_713

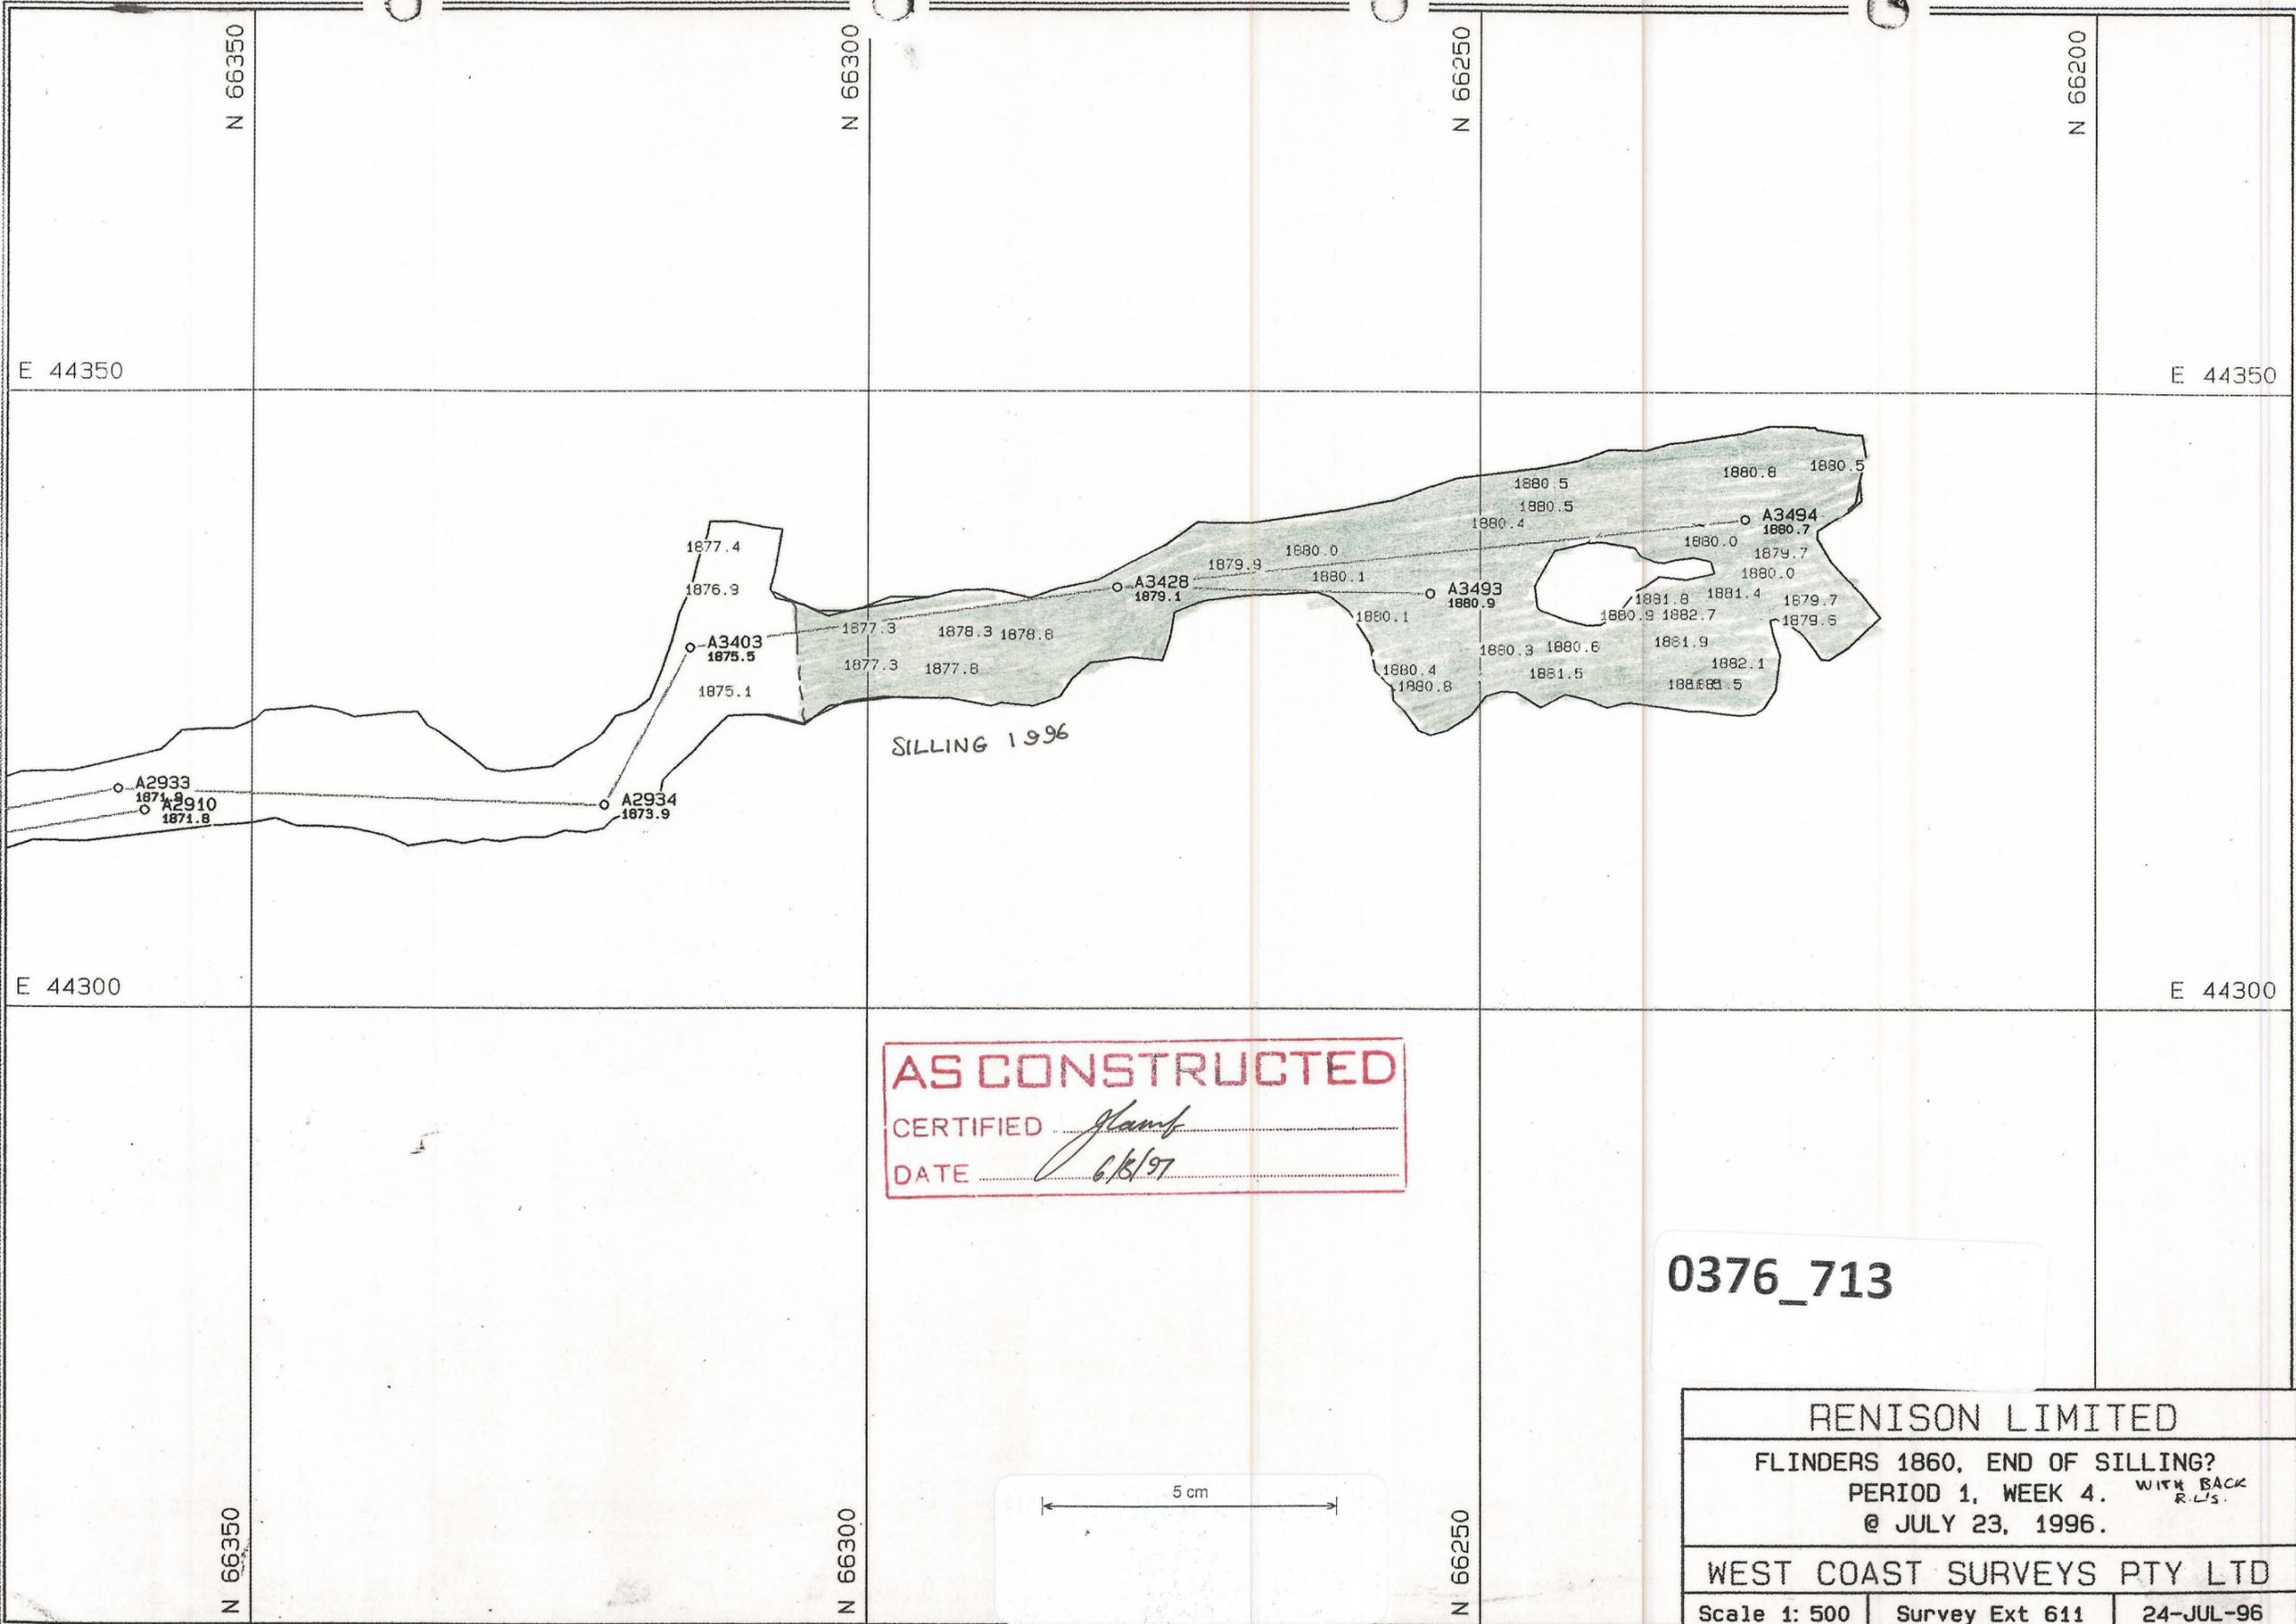

AS CONSTRUCTED
 CERTIFIED *flamb*
 DATE *6/18/97*

0376_713

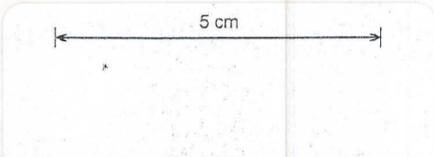

RENISON LIMITED		
FLINDERS 1860, END OF SILLING?		
PERIOD 1, WEEK 4. WITH BACK R.L.S.		
@ JULY 23, 1996.		
WEST COAST SURVEYS PTY LTD		
Scale 1: 500	Survey Ext 611	24-JUL-96

FLINDB.PF