


0376_714

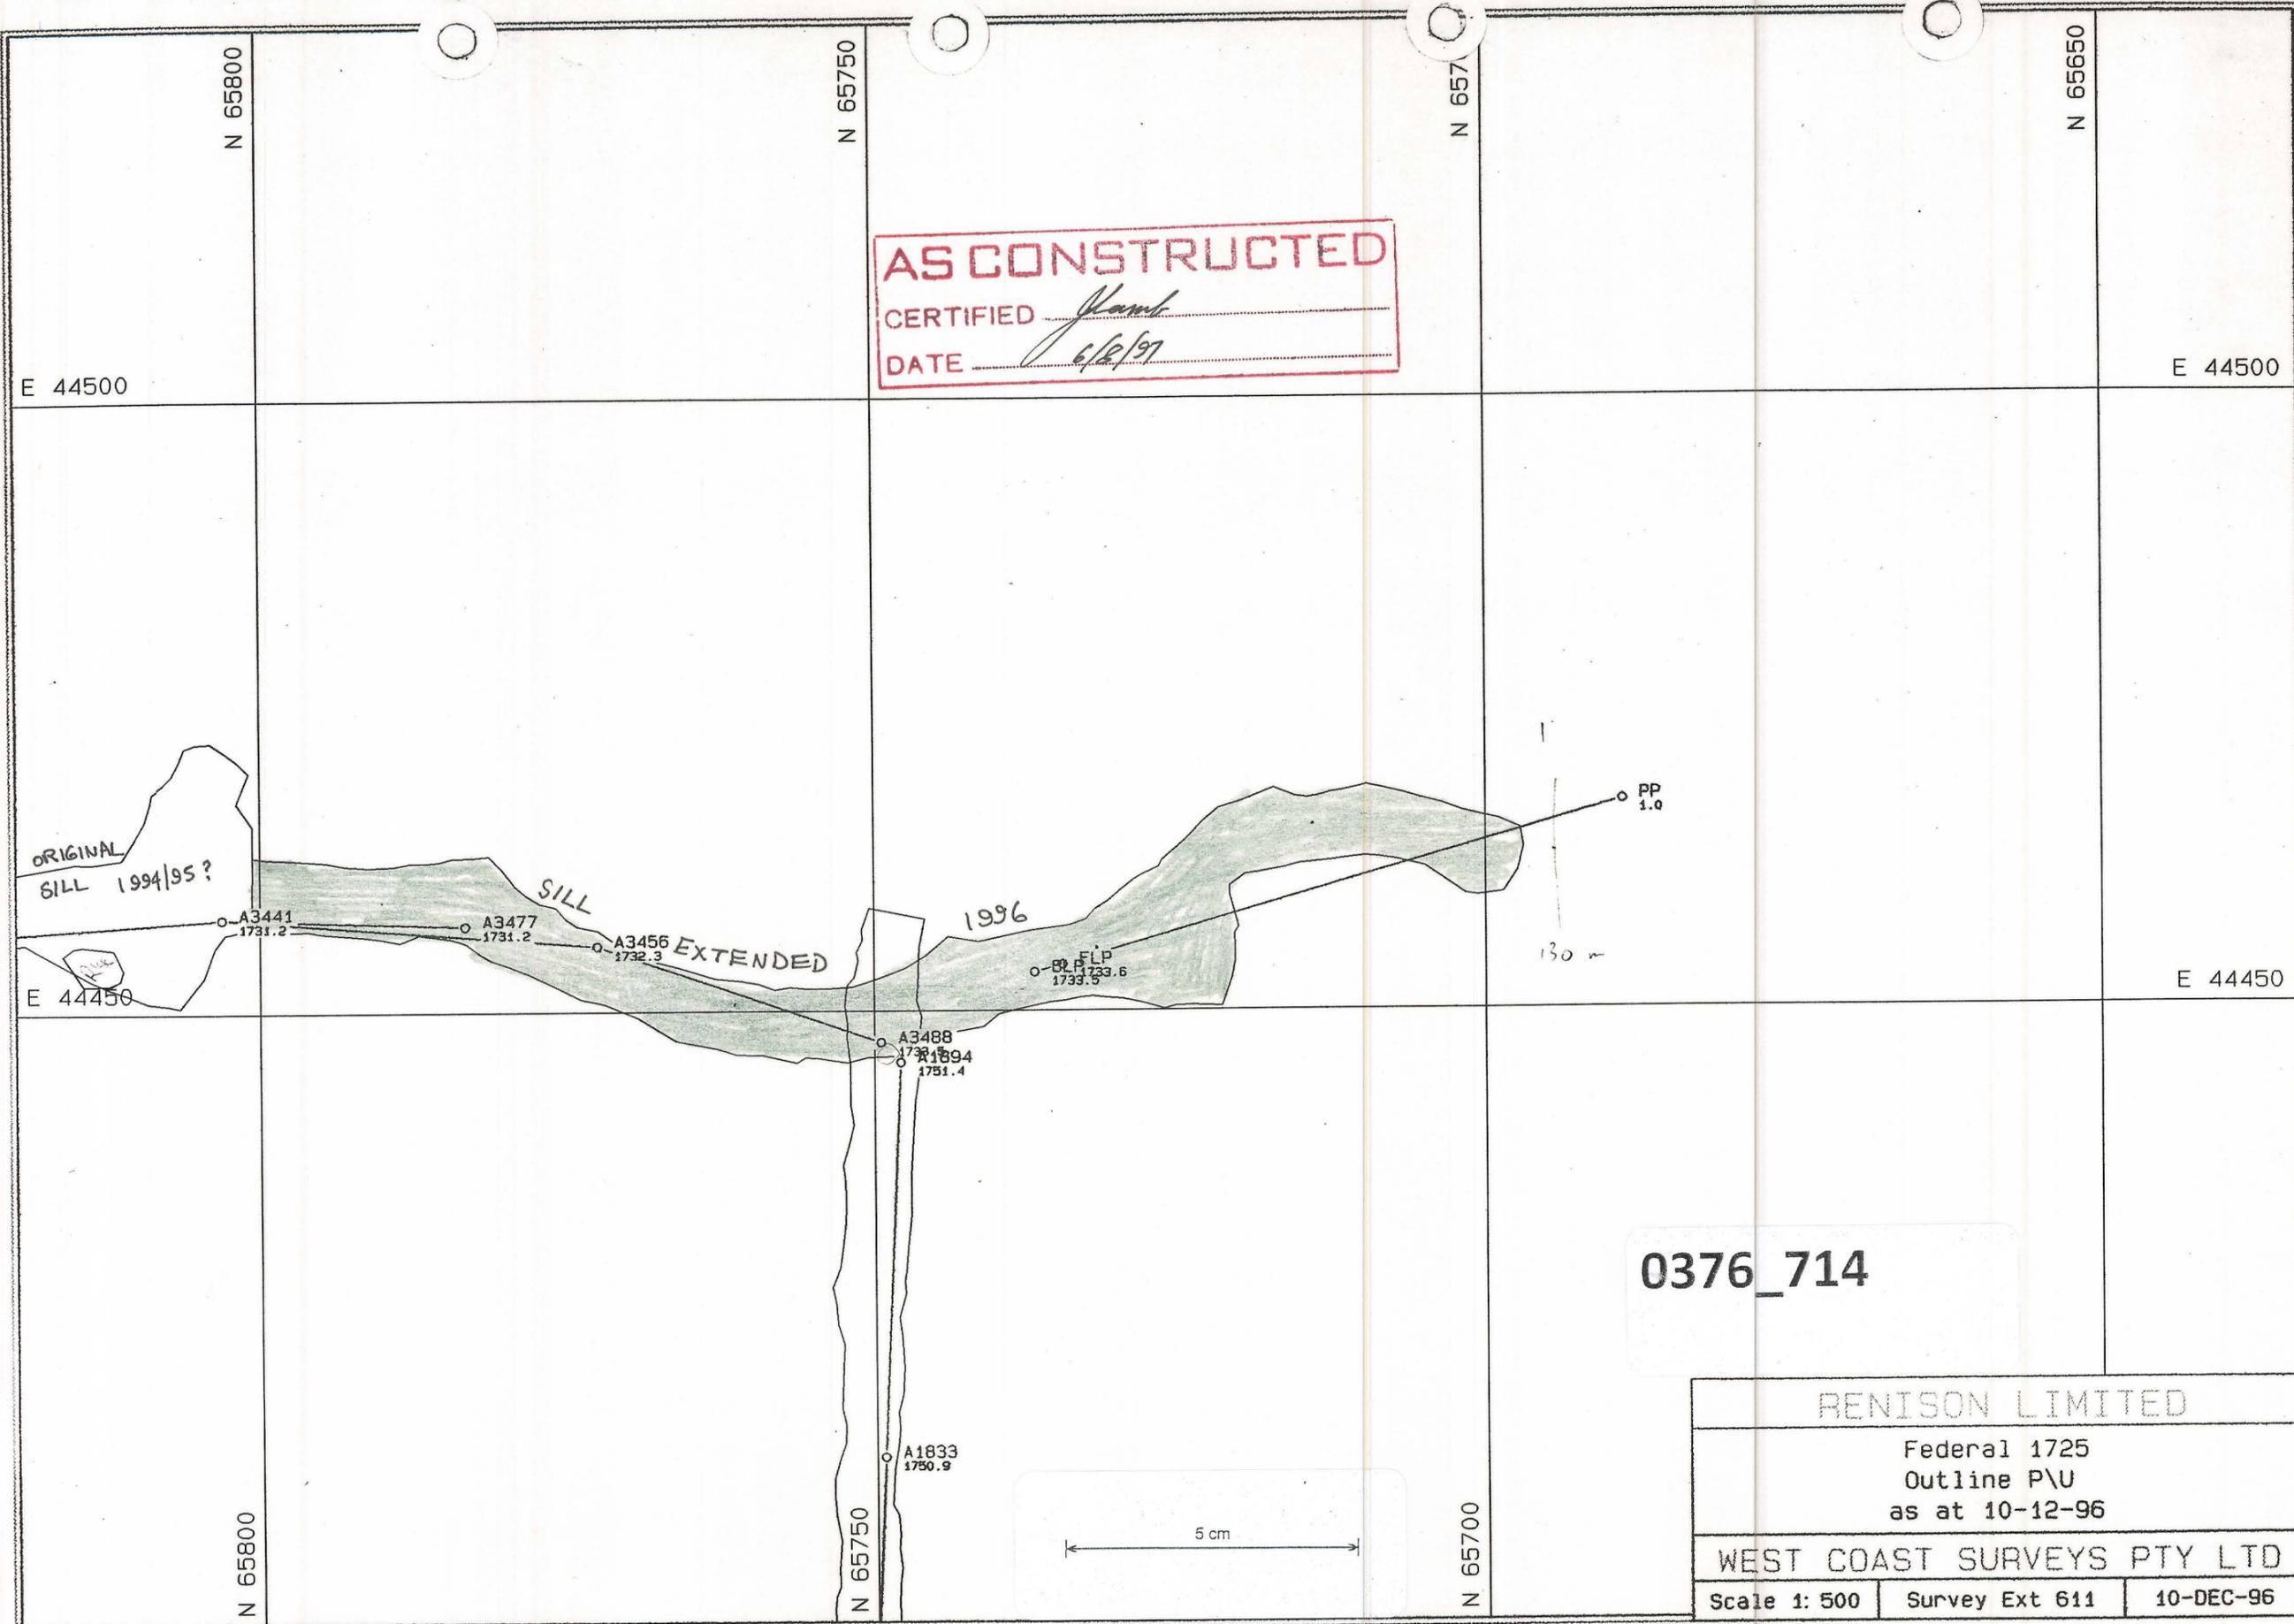

AS CONSTRUCTED
 CERTIFIED *[Signature]*
 DATE *6/12/97*

0376_714

RENISON LIMITED		
Federal 1725 Outline P/U as at 10-12-96		
WEST COAST SURVEYS PTY LTD		
Scale 1: 500	Survey Ext 611	10-DEC-96

FEDERF.PF