


0376\_715

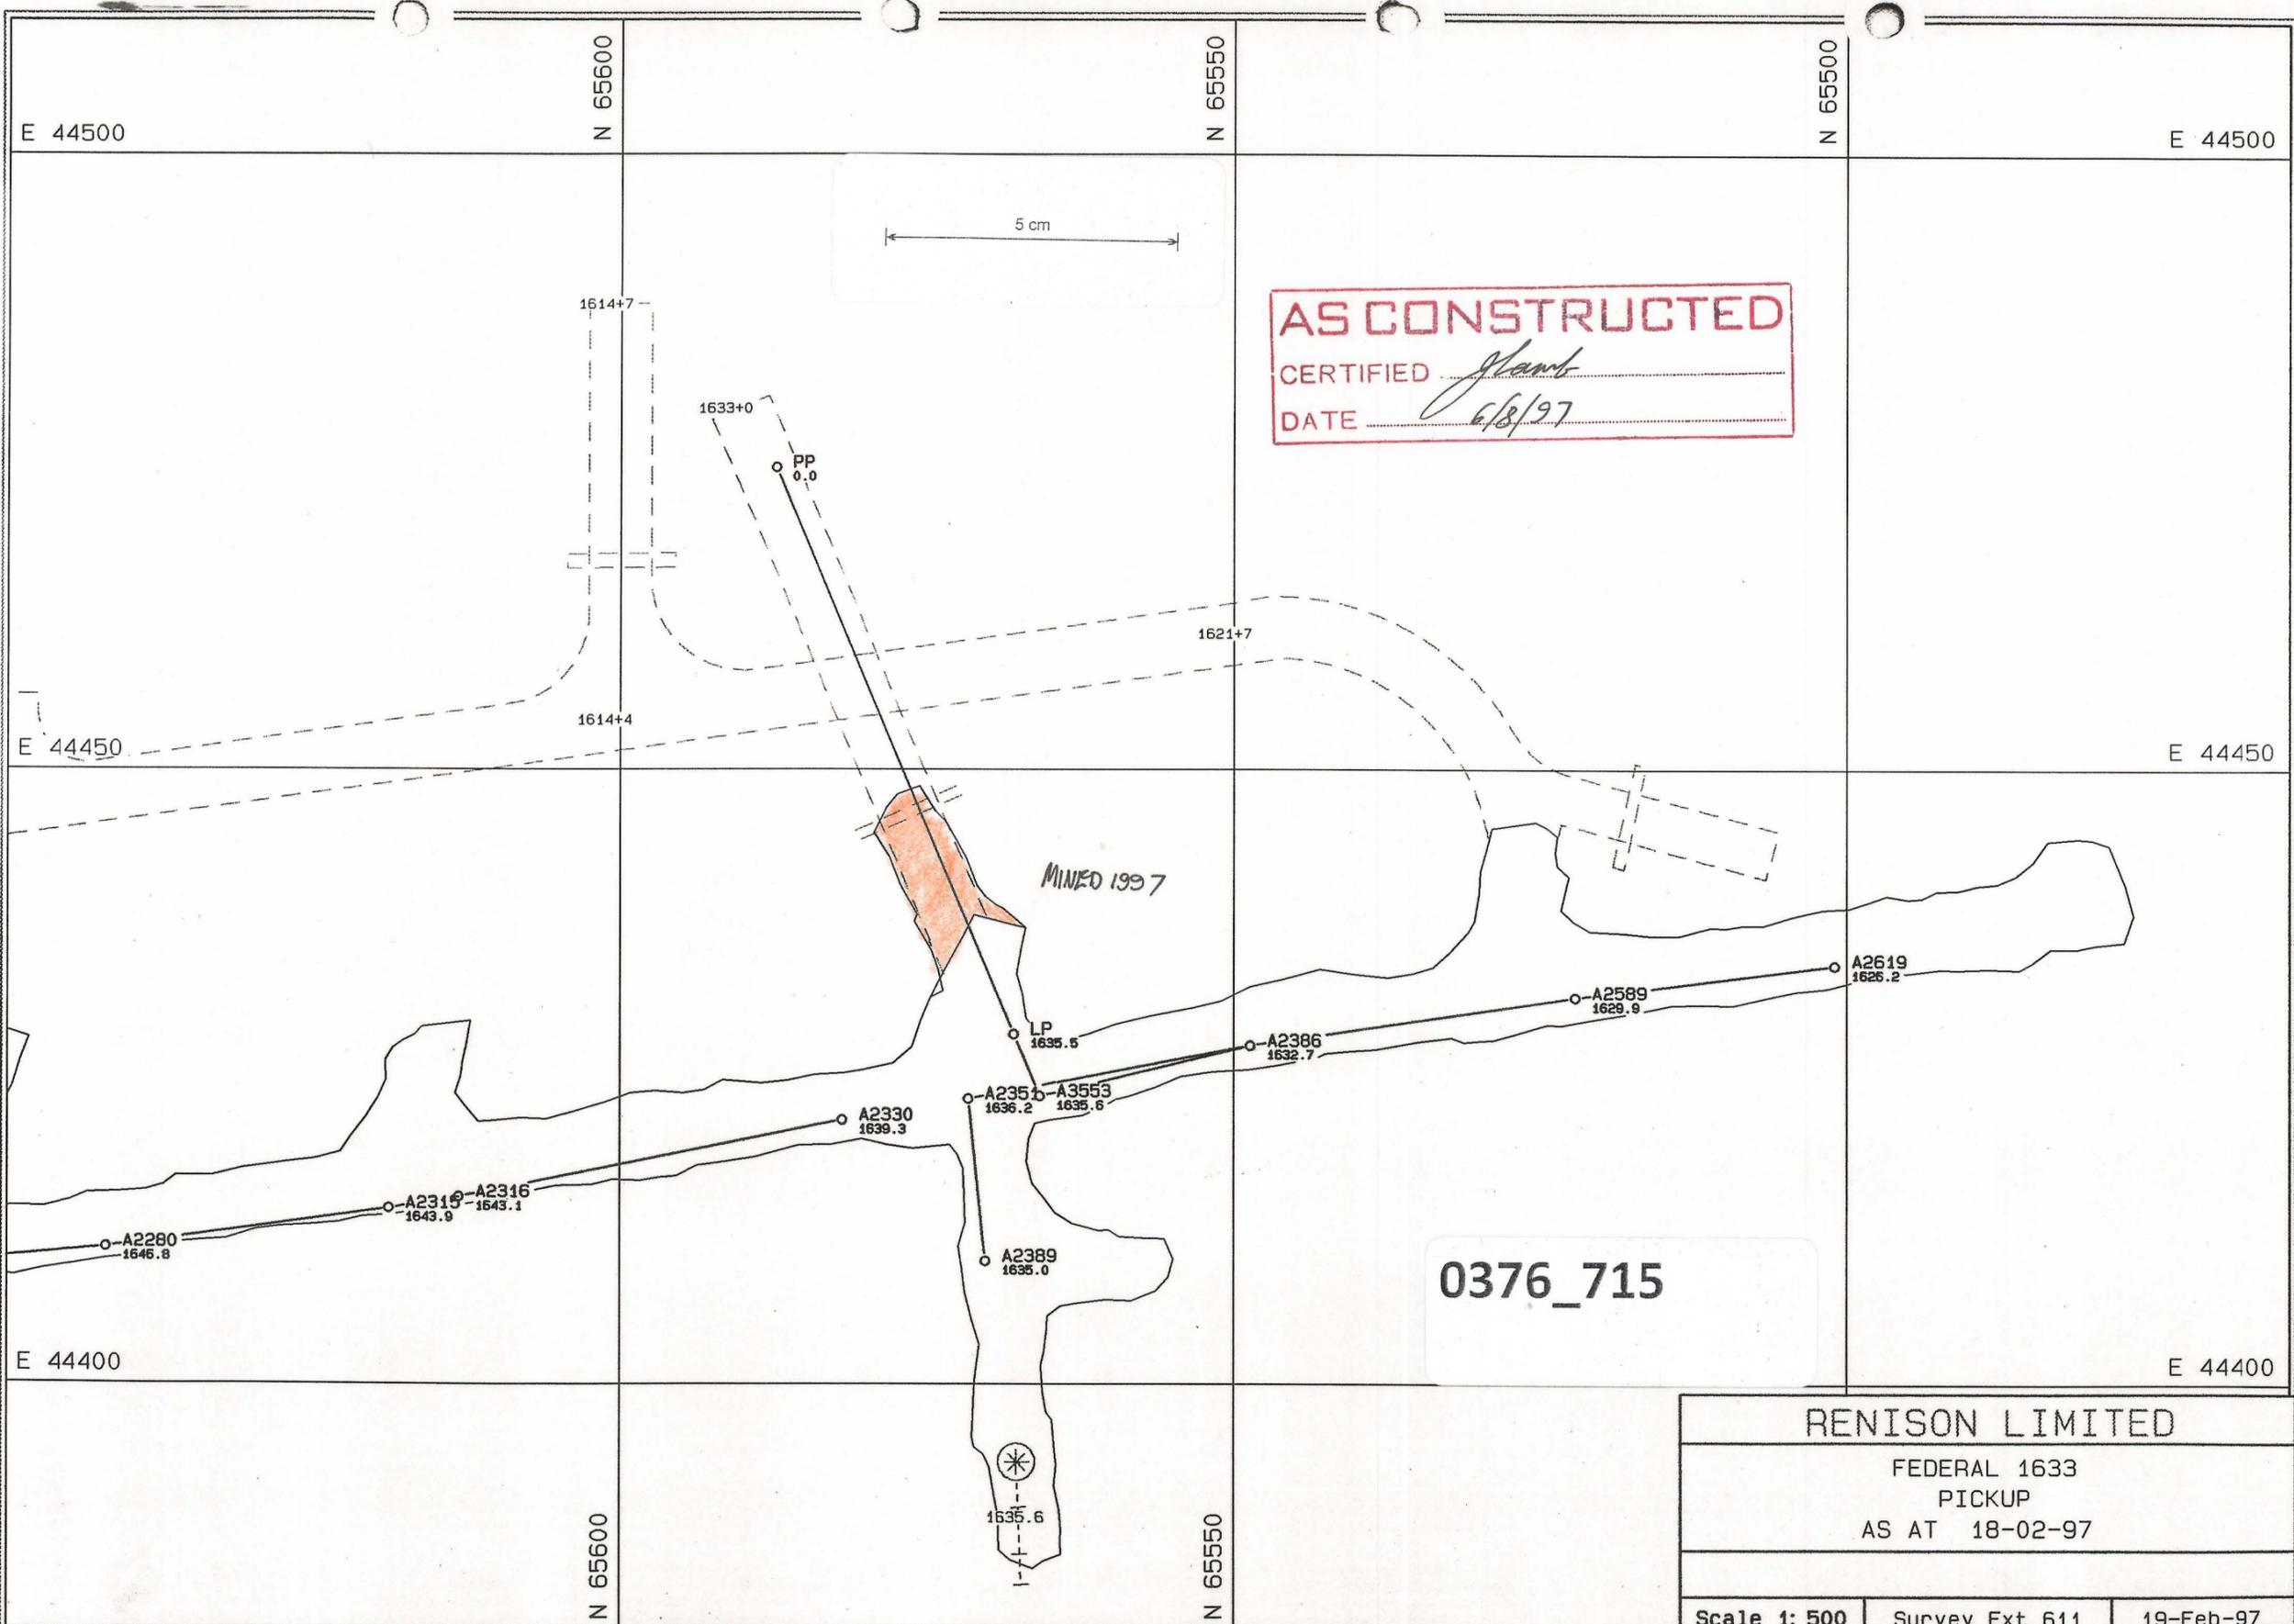

**AS CONSTRUCTED**  
 CERTIFIED *[Signature]*  
 DATE *6/8/97*

0376\_715

<b>RENISON LIMITED</b>		
FEDERAL 1633 PICKUP AS AT 18-02-97		
Scale 1: 500	Survey Ext 611	19-Feb-97

federala.pf