


0376_716

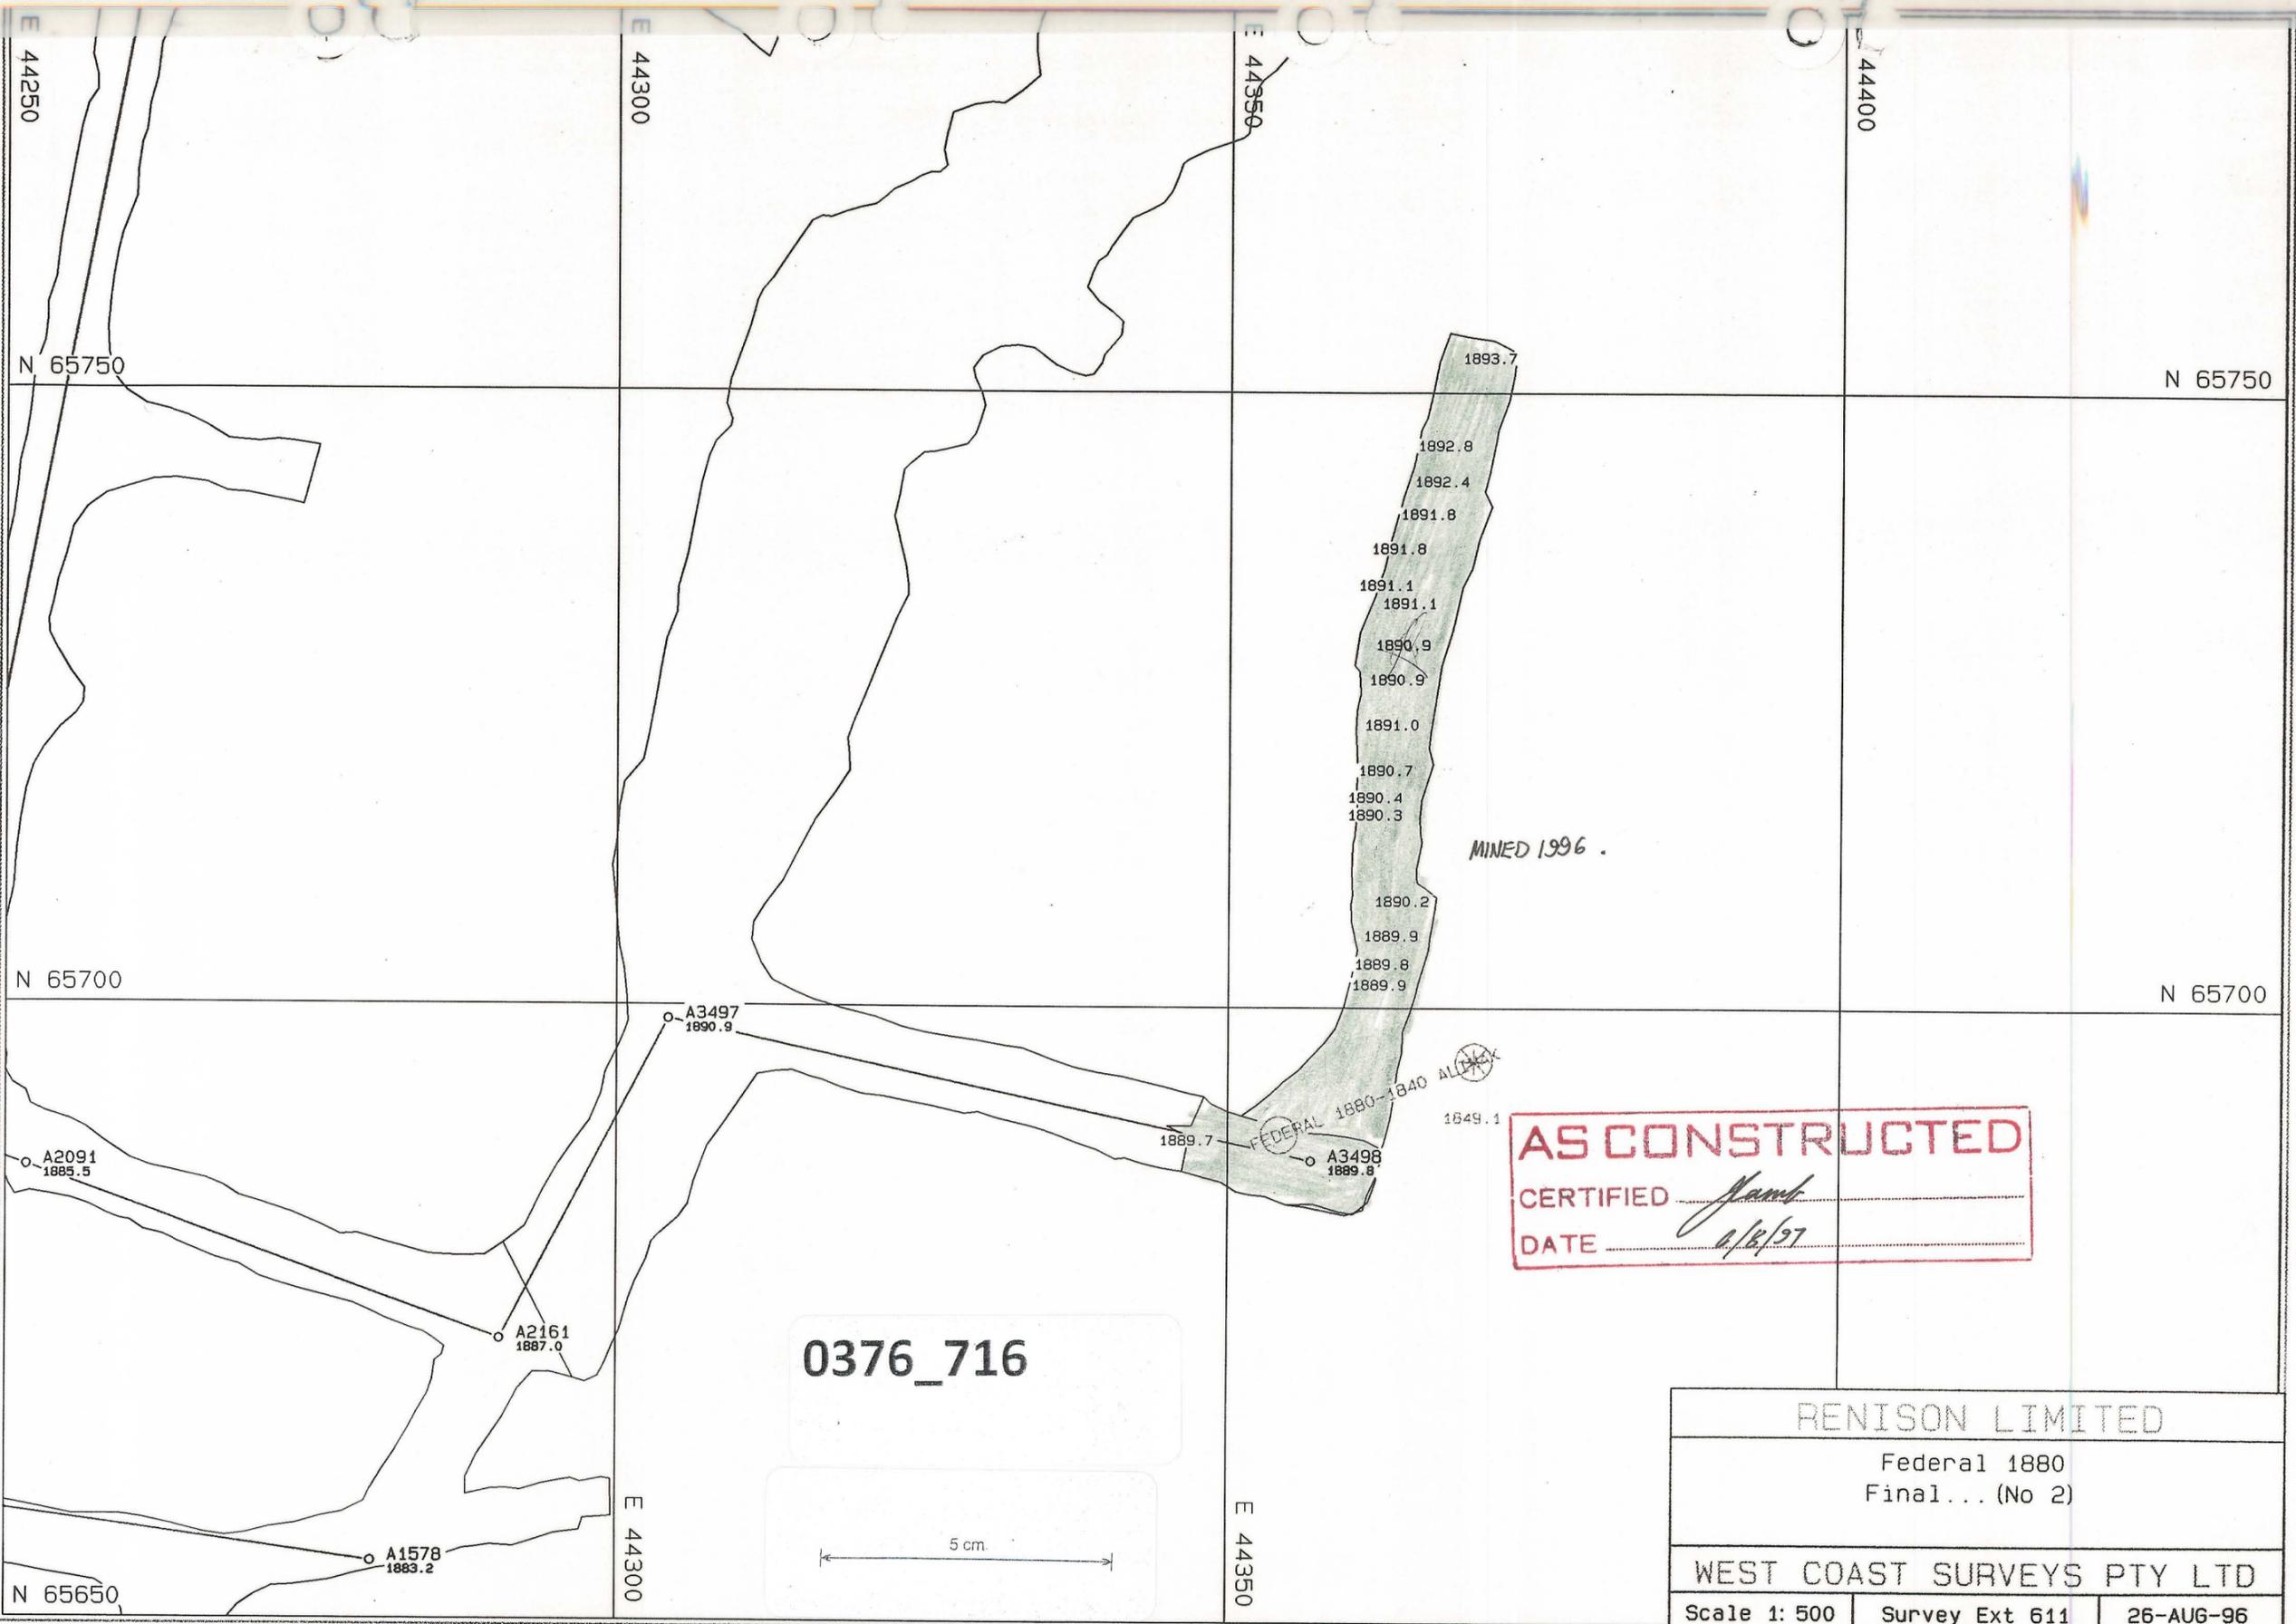

0376_716

AS CONSTRUCTED
 CERTIFIED *Jamb*
 DATE *2/12/97*

RENISON LIMITED		
Federal 1880 Final... (No 2)		
WEST COAST SURVEYS PTY LTD		
Scale 1: 500	Survey Ext 611	26-AUG-96

FEDERA . PF