


0376_717

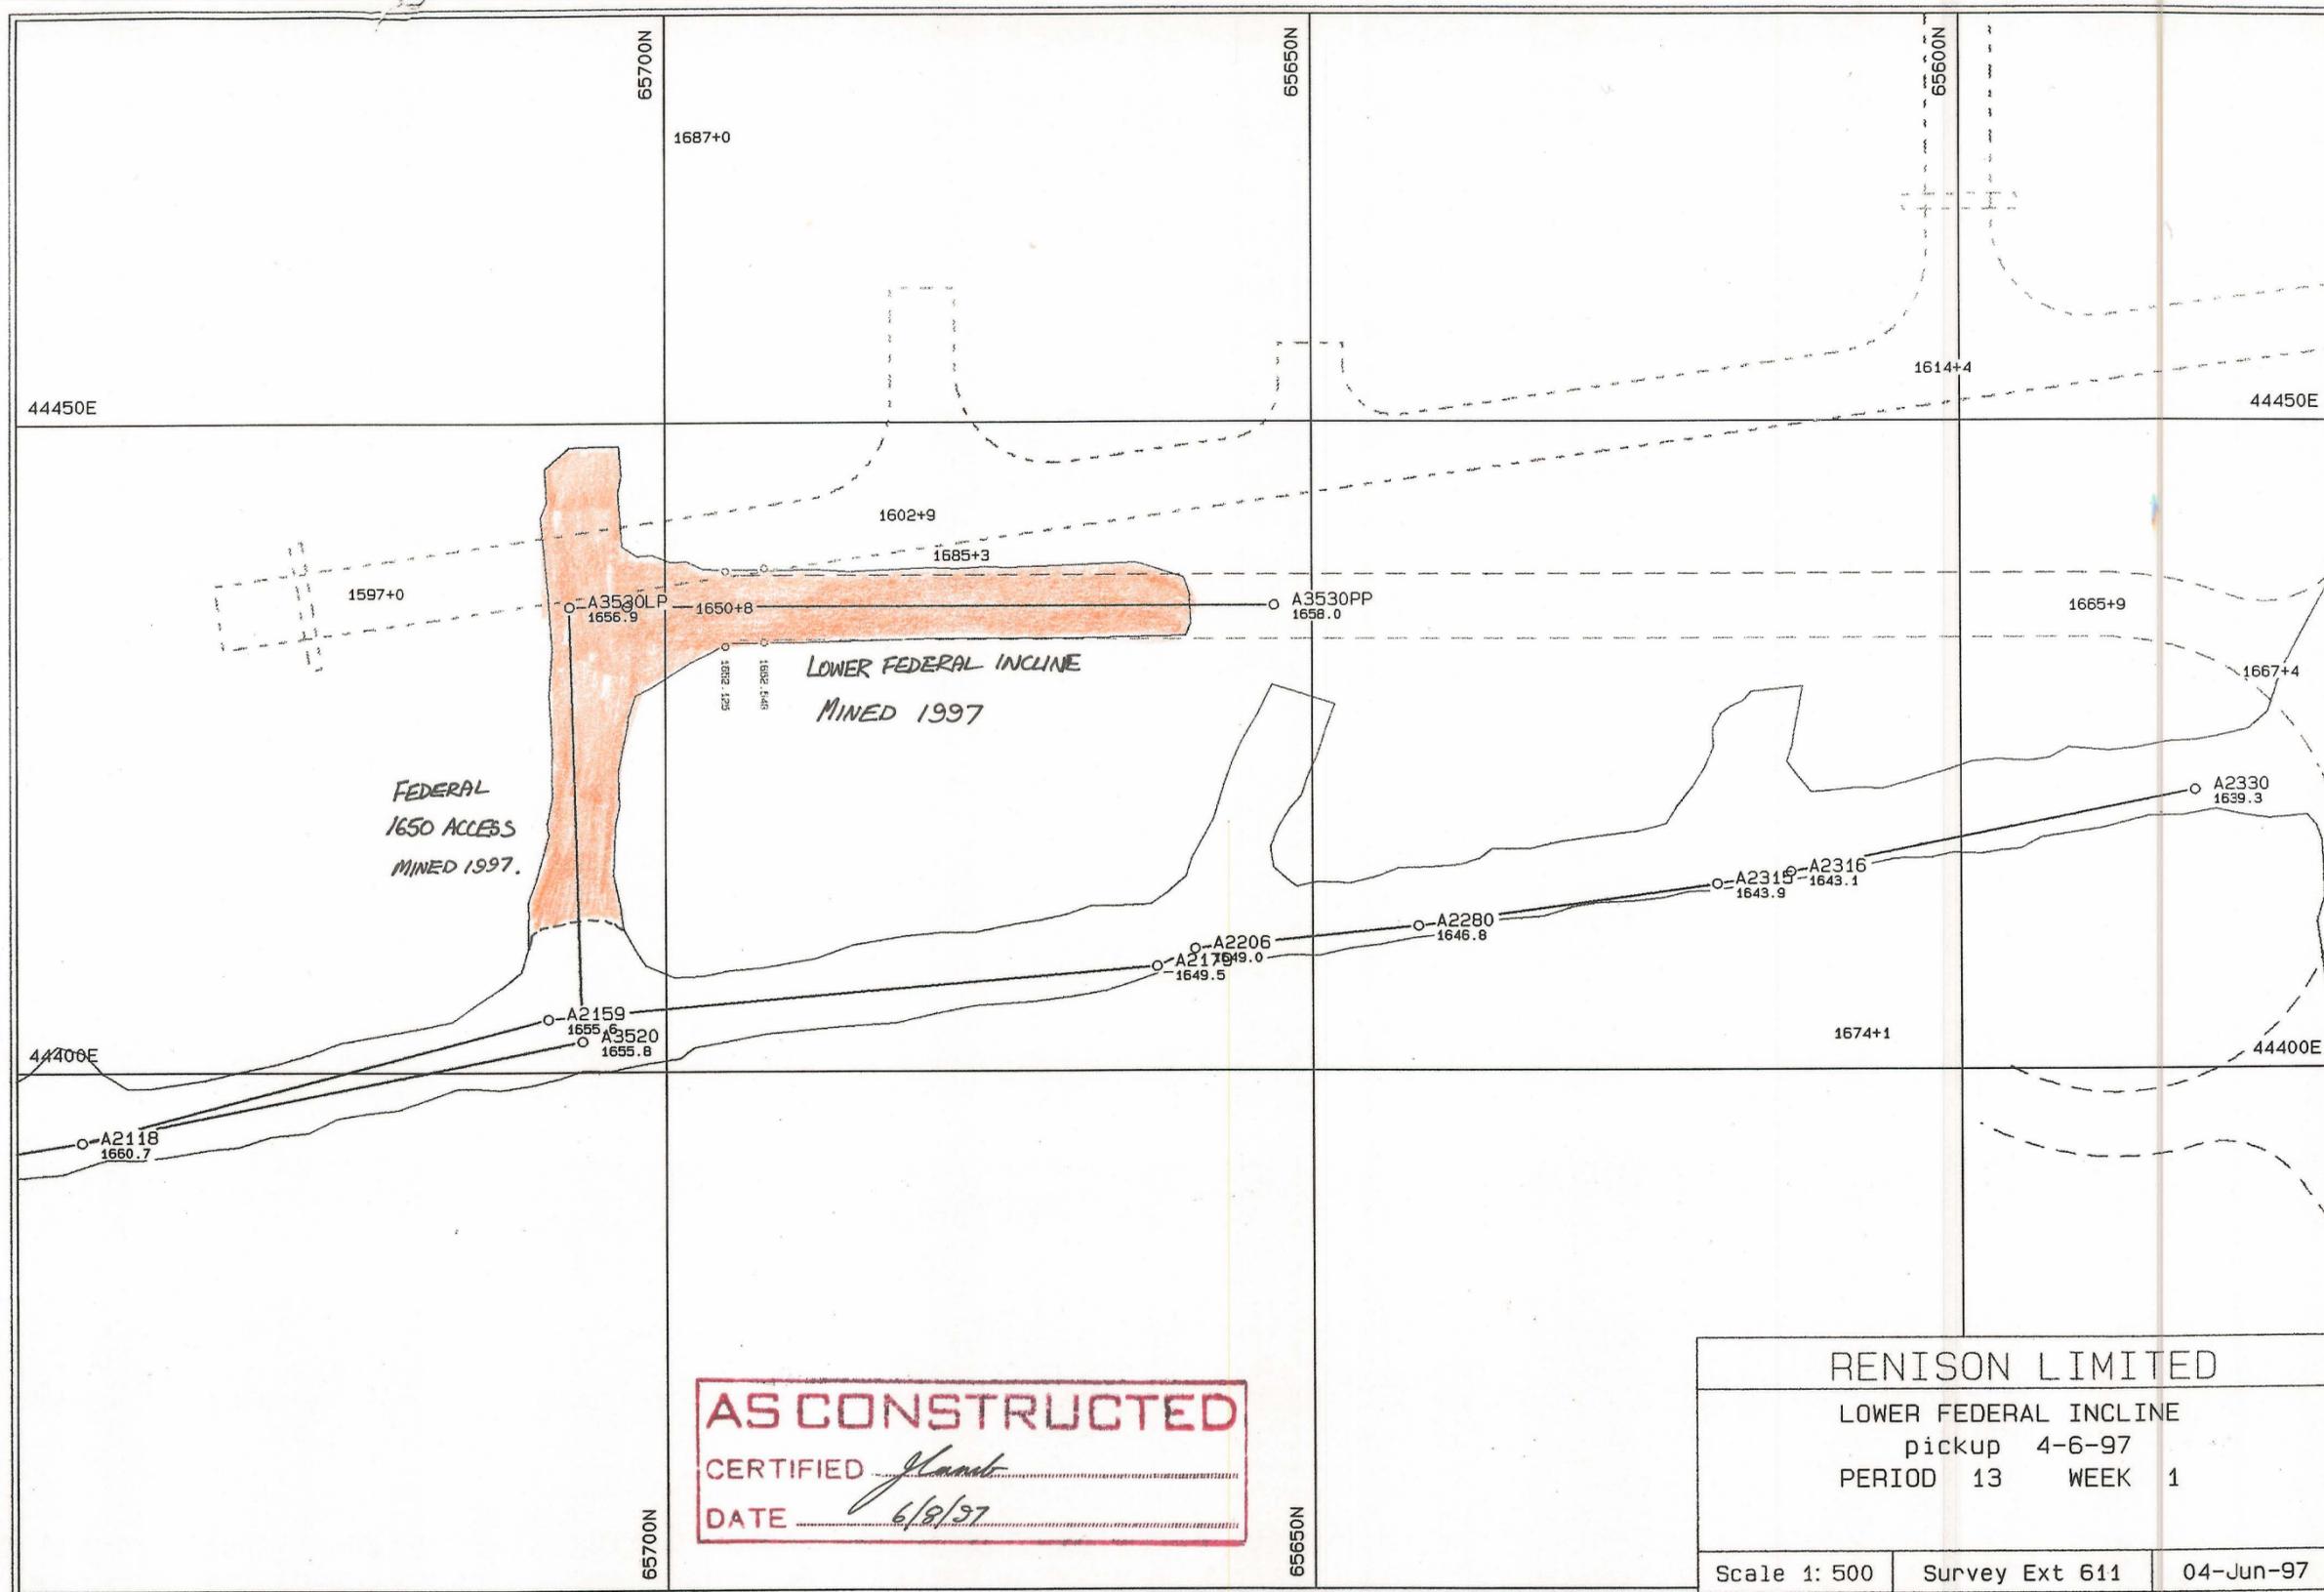

lowerfea.pf

5 cm

0376_717