


0376_719

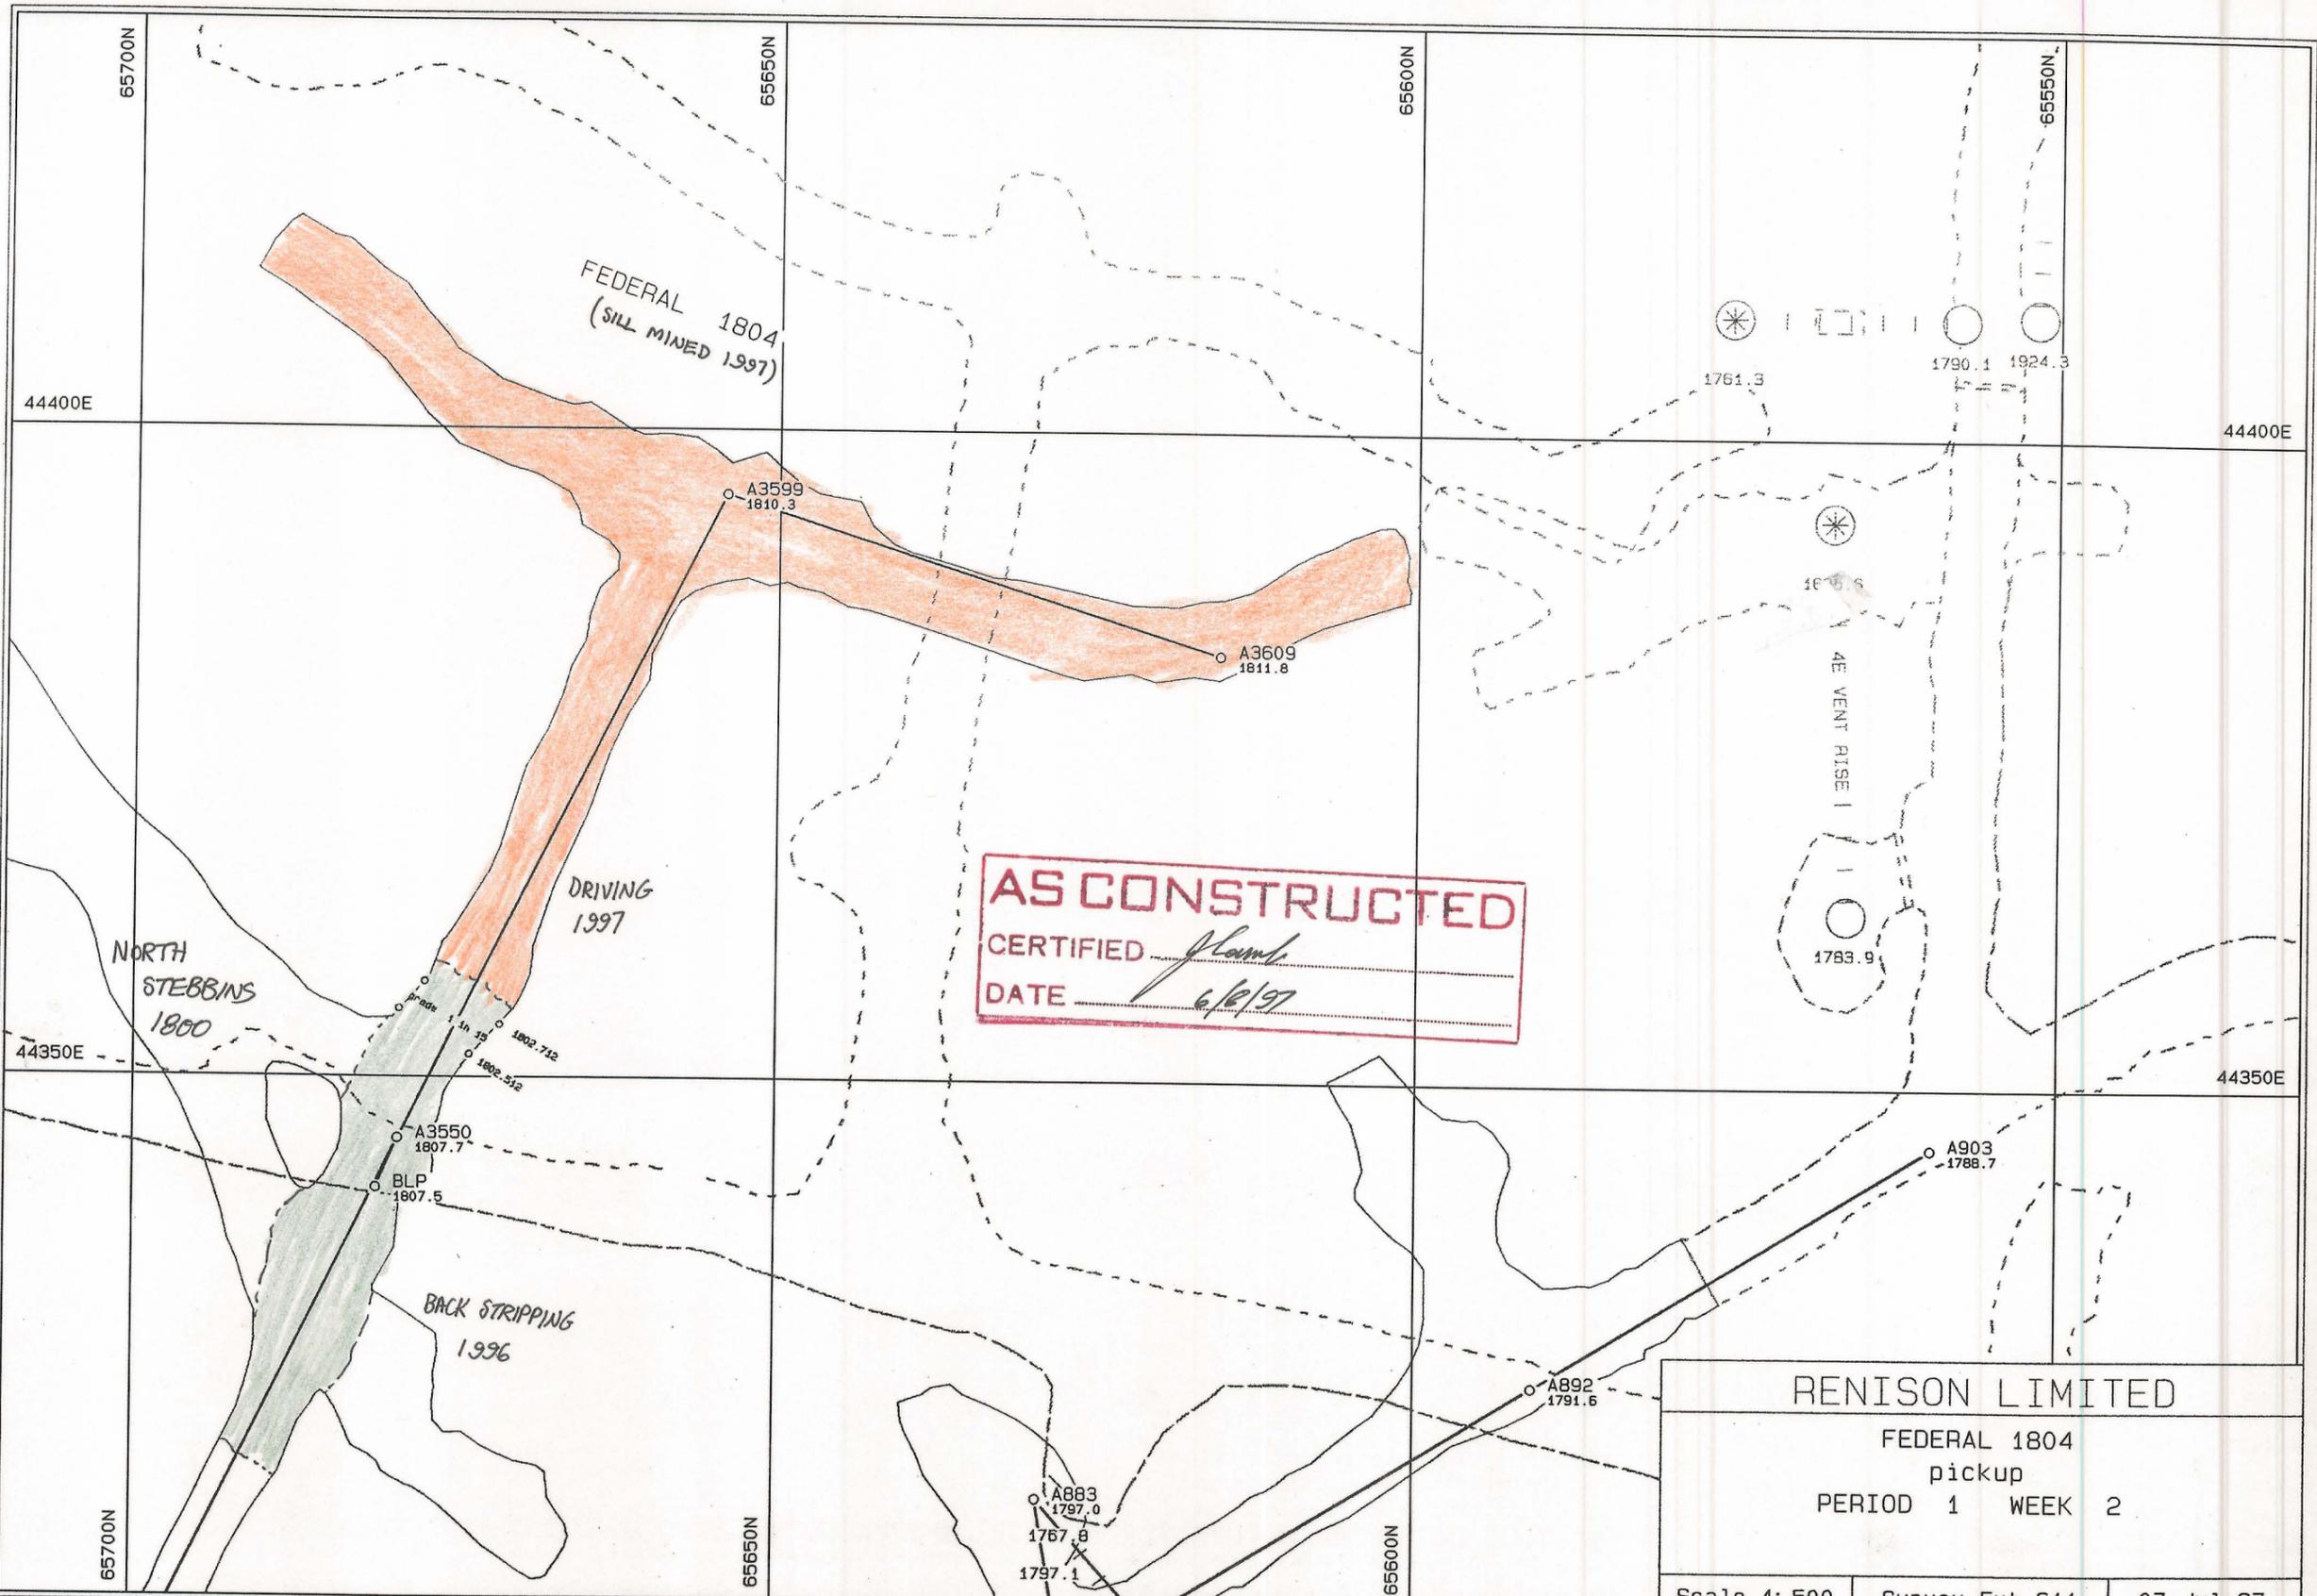

AS CONSTRUCTED
 CERTIFIED *[Signature]*
 DATE *6/10/97*

RENISON LIMITED		
FEDERAL 1804 pickup		
PERIOD 1 WEEK 2		
Scale 1: 500	Survey Ext 611	07-Jul-97

federal1.pf

0376_719

