



0376_720

0376_720

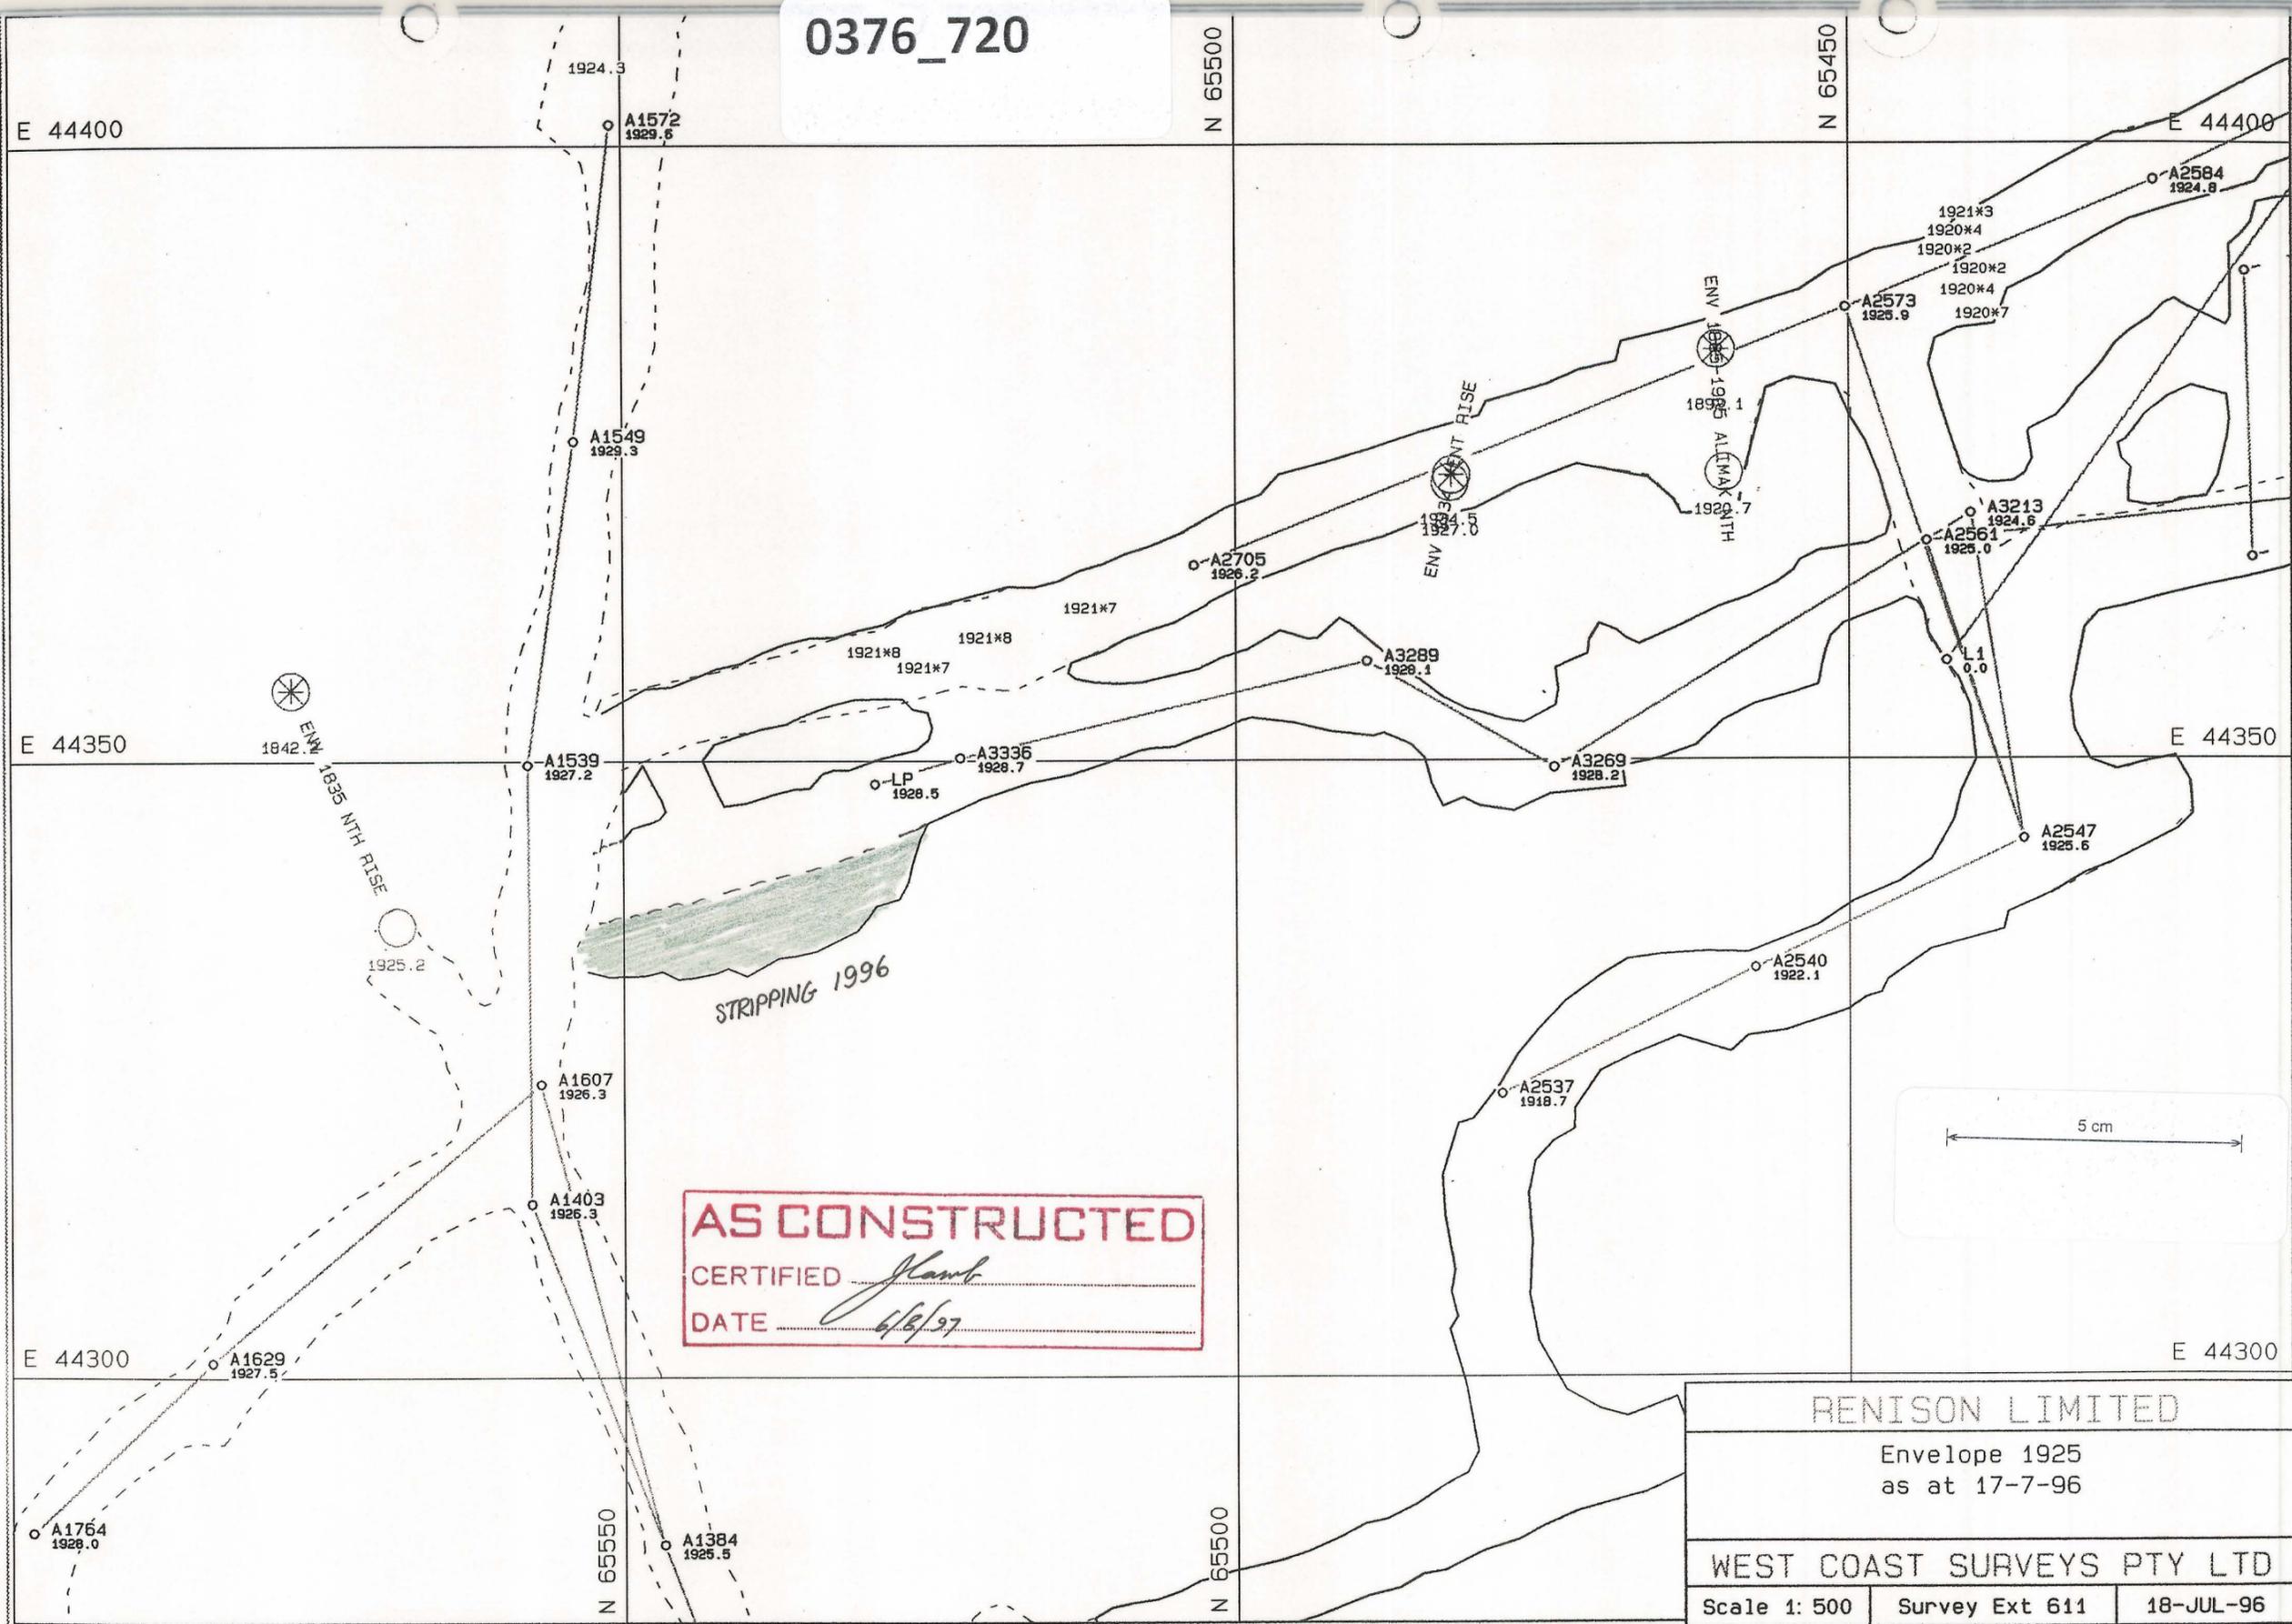

AS CONSTRUCTED
 CERTIFIED *[Signature]*
 DATE *4/8/97*

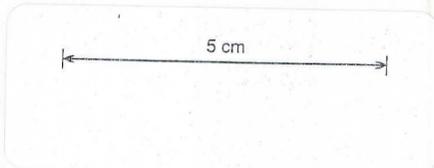

RENISON LIMITED		
Envelope 1925 as at 17-7-96		
WEST COAST SURVEYS PTY LTD		
Scale 1: 500	Survey Ext 611	18-JUL-96