


0376_722

5 cm

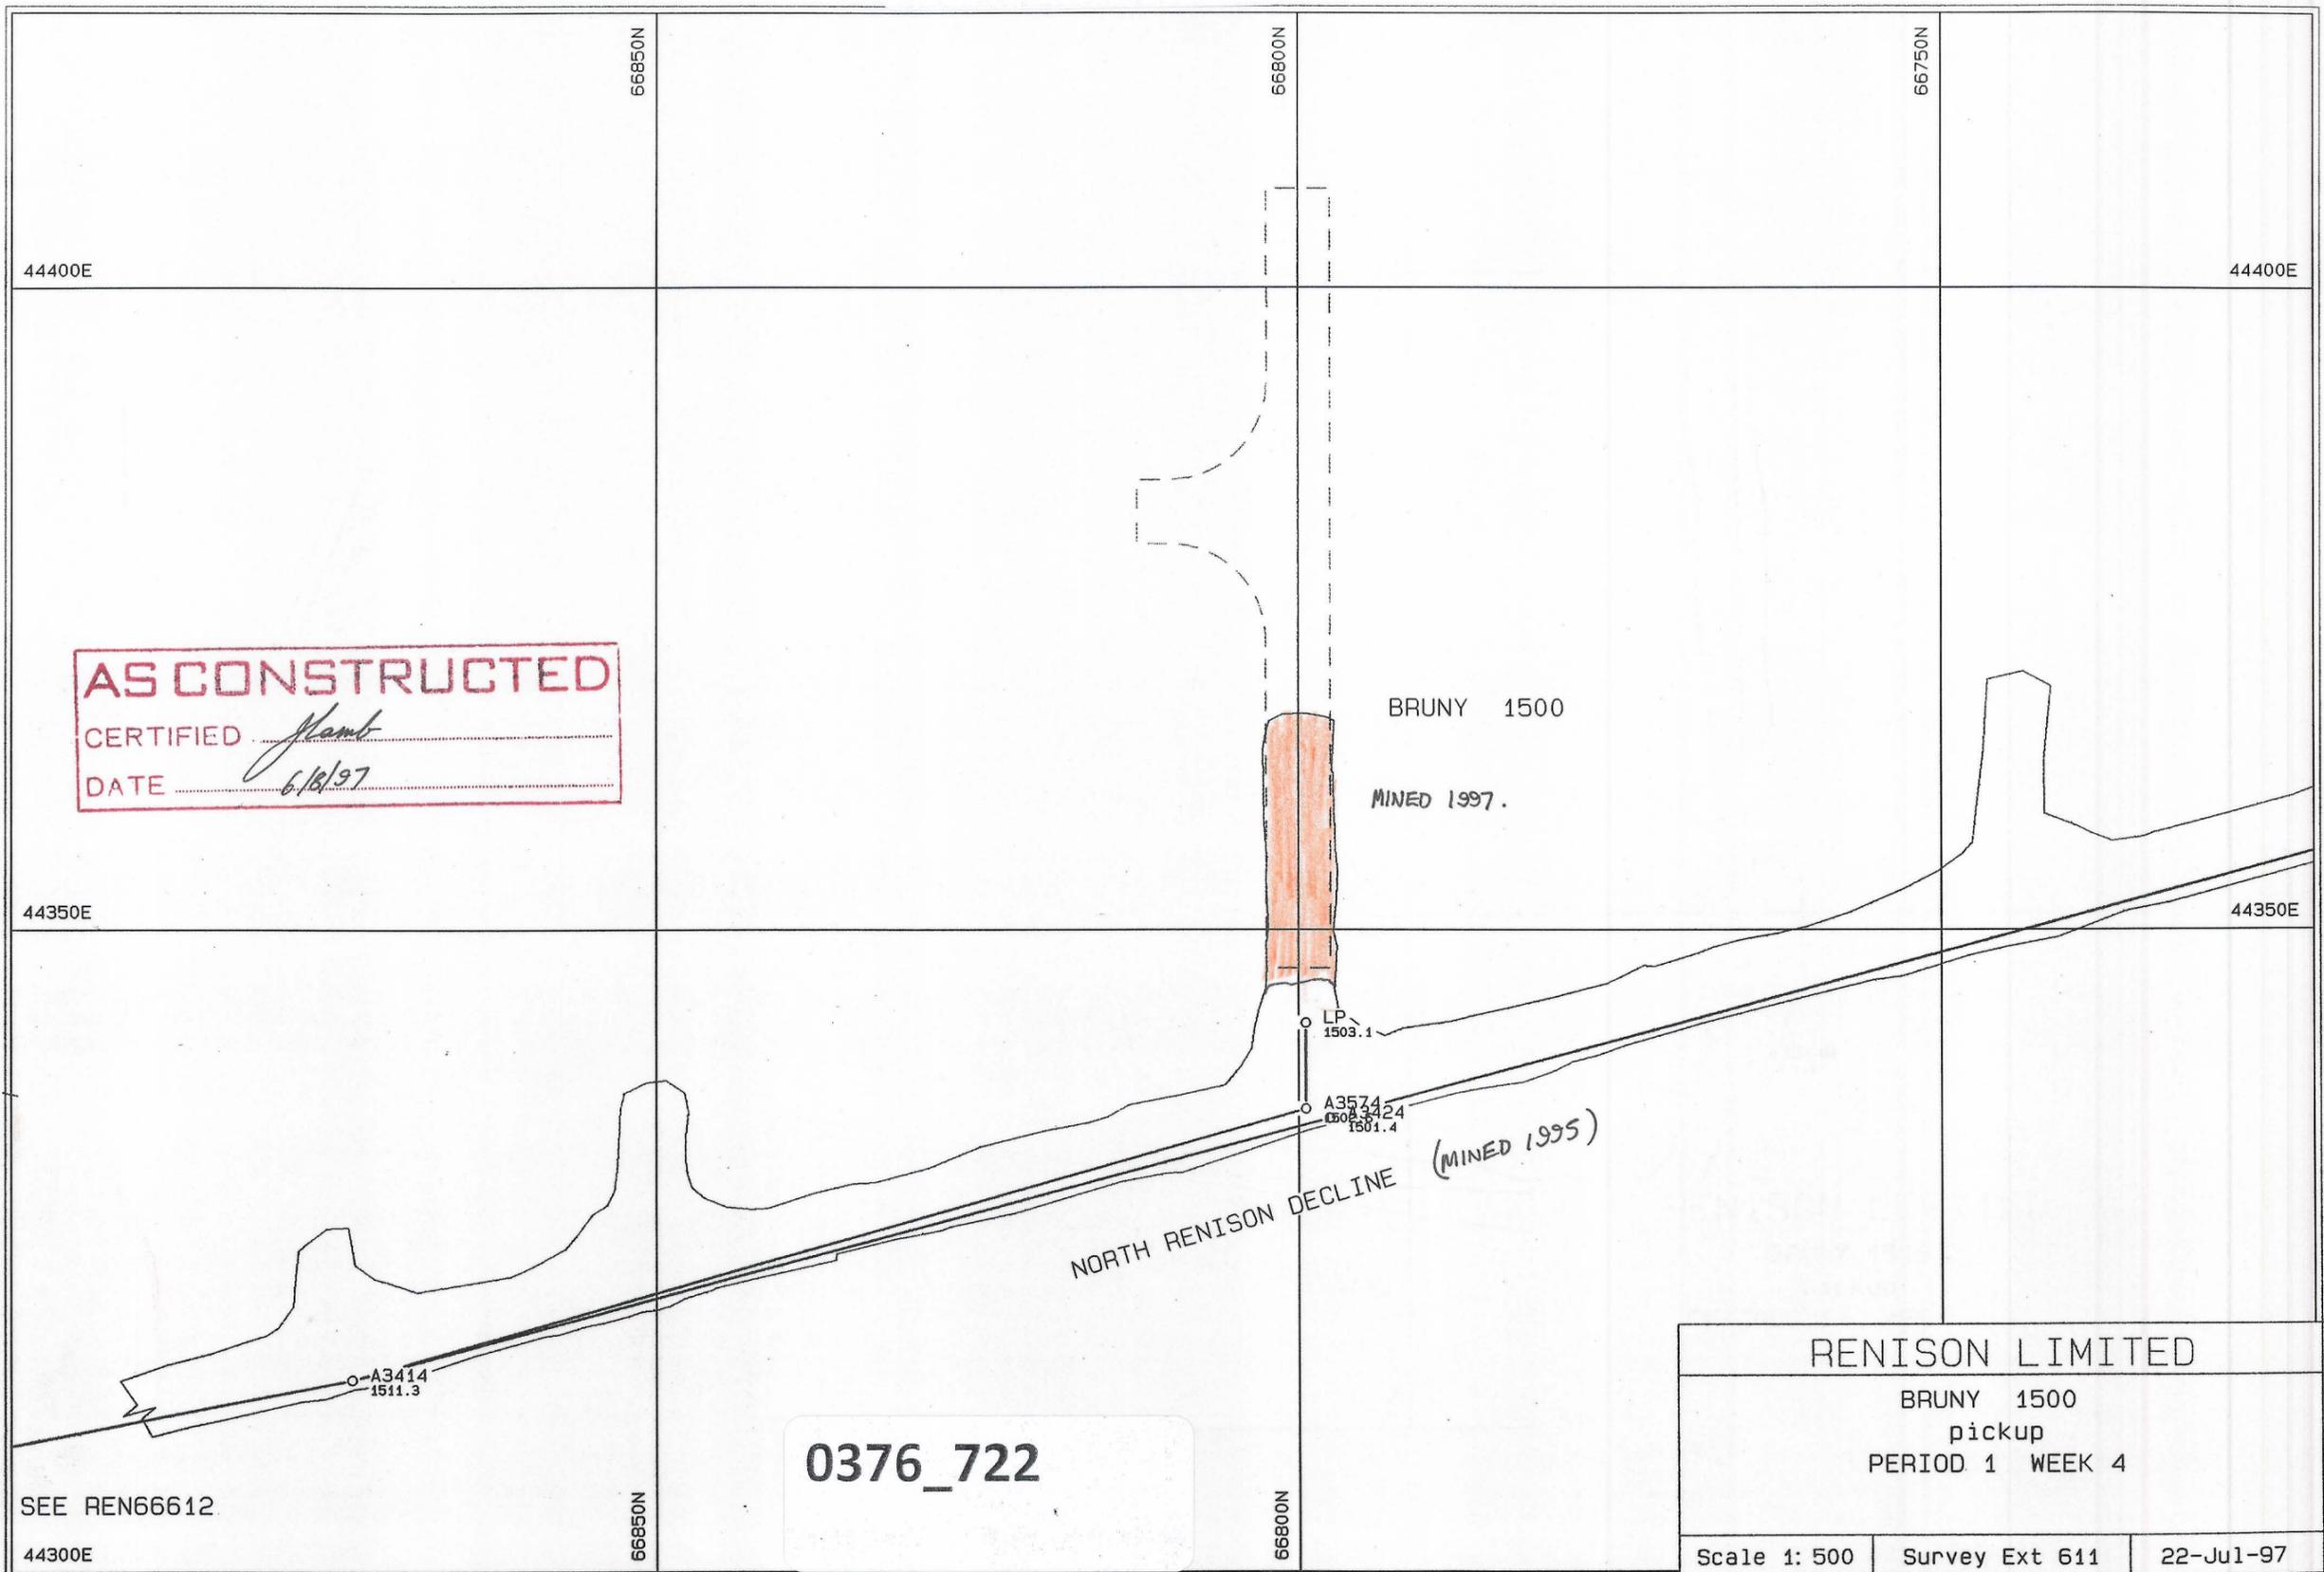

AS CONSTRUCTED
 CERTIFIED *[Signature]*
 DATE 6/13/97

BRUNY 1500
 MINED 1997.

NORTH RENISON DECLINE (MINED 1995)

RENISON LIMITED		
BRUNY 1500 pickup PERIOD 1 WEEK 4		
Scale 1: 500	Survey Ext 611	22-Jul-97

0376_722

bruny15b.pf

SEE REN66612