


0376_723

0376_723

5 cm

NORTH ARGENT

AS CONSTRUCTED
 CERTIFIED *Grant*
 DATE *6/8/97*

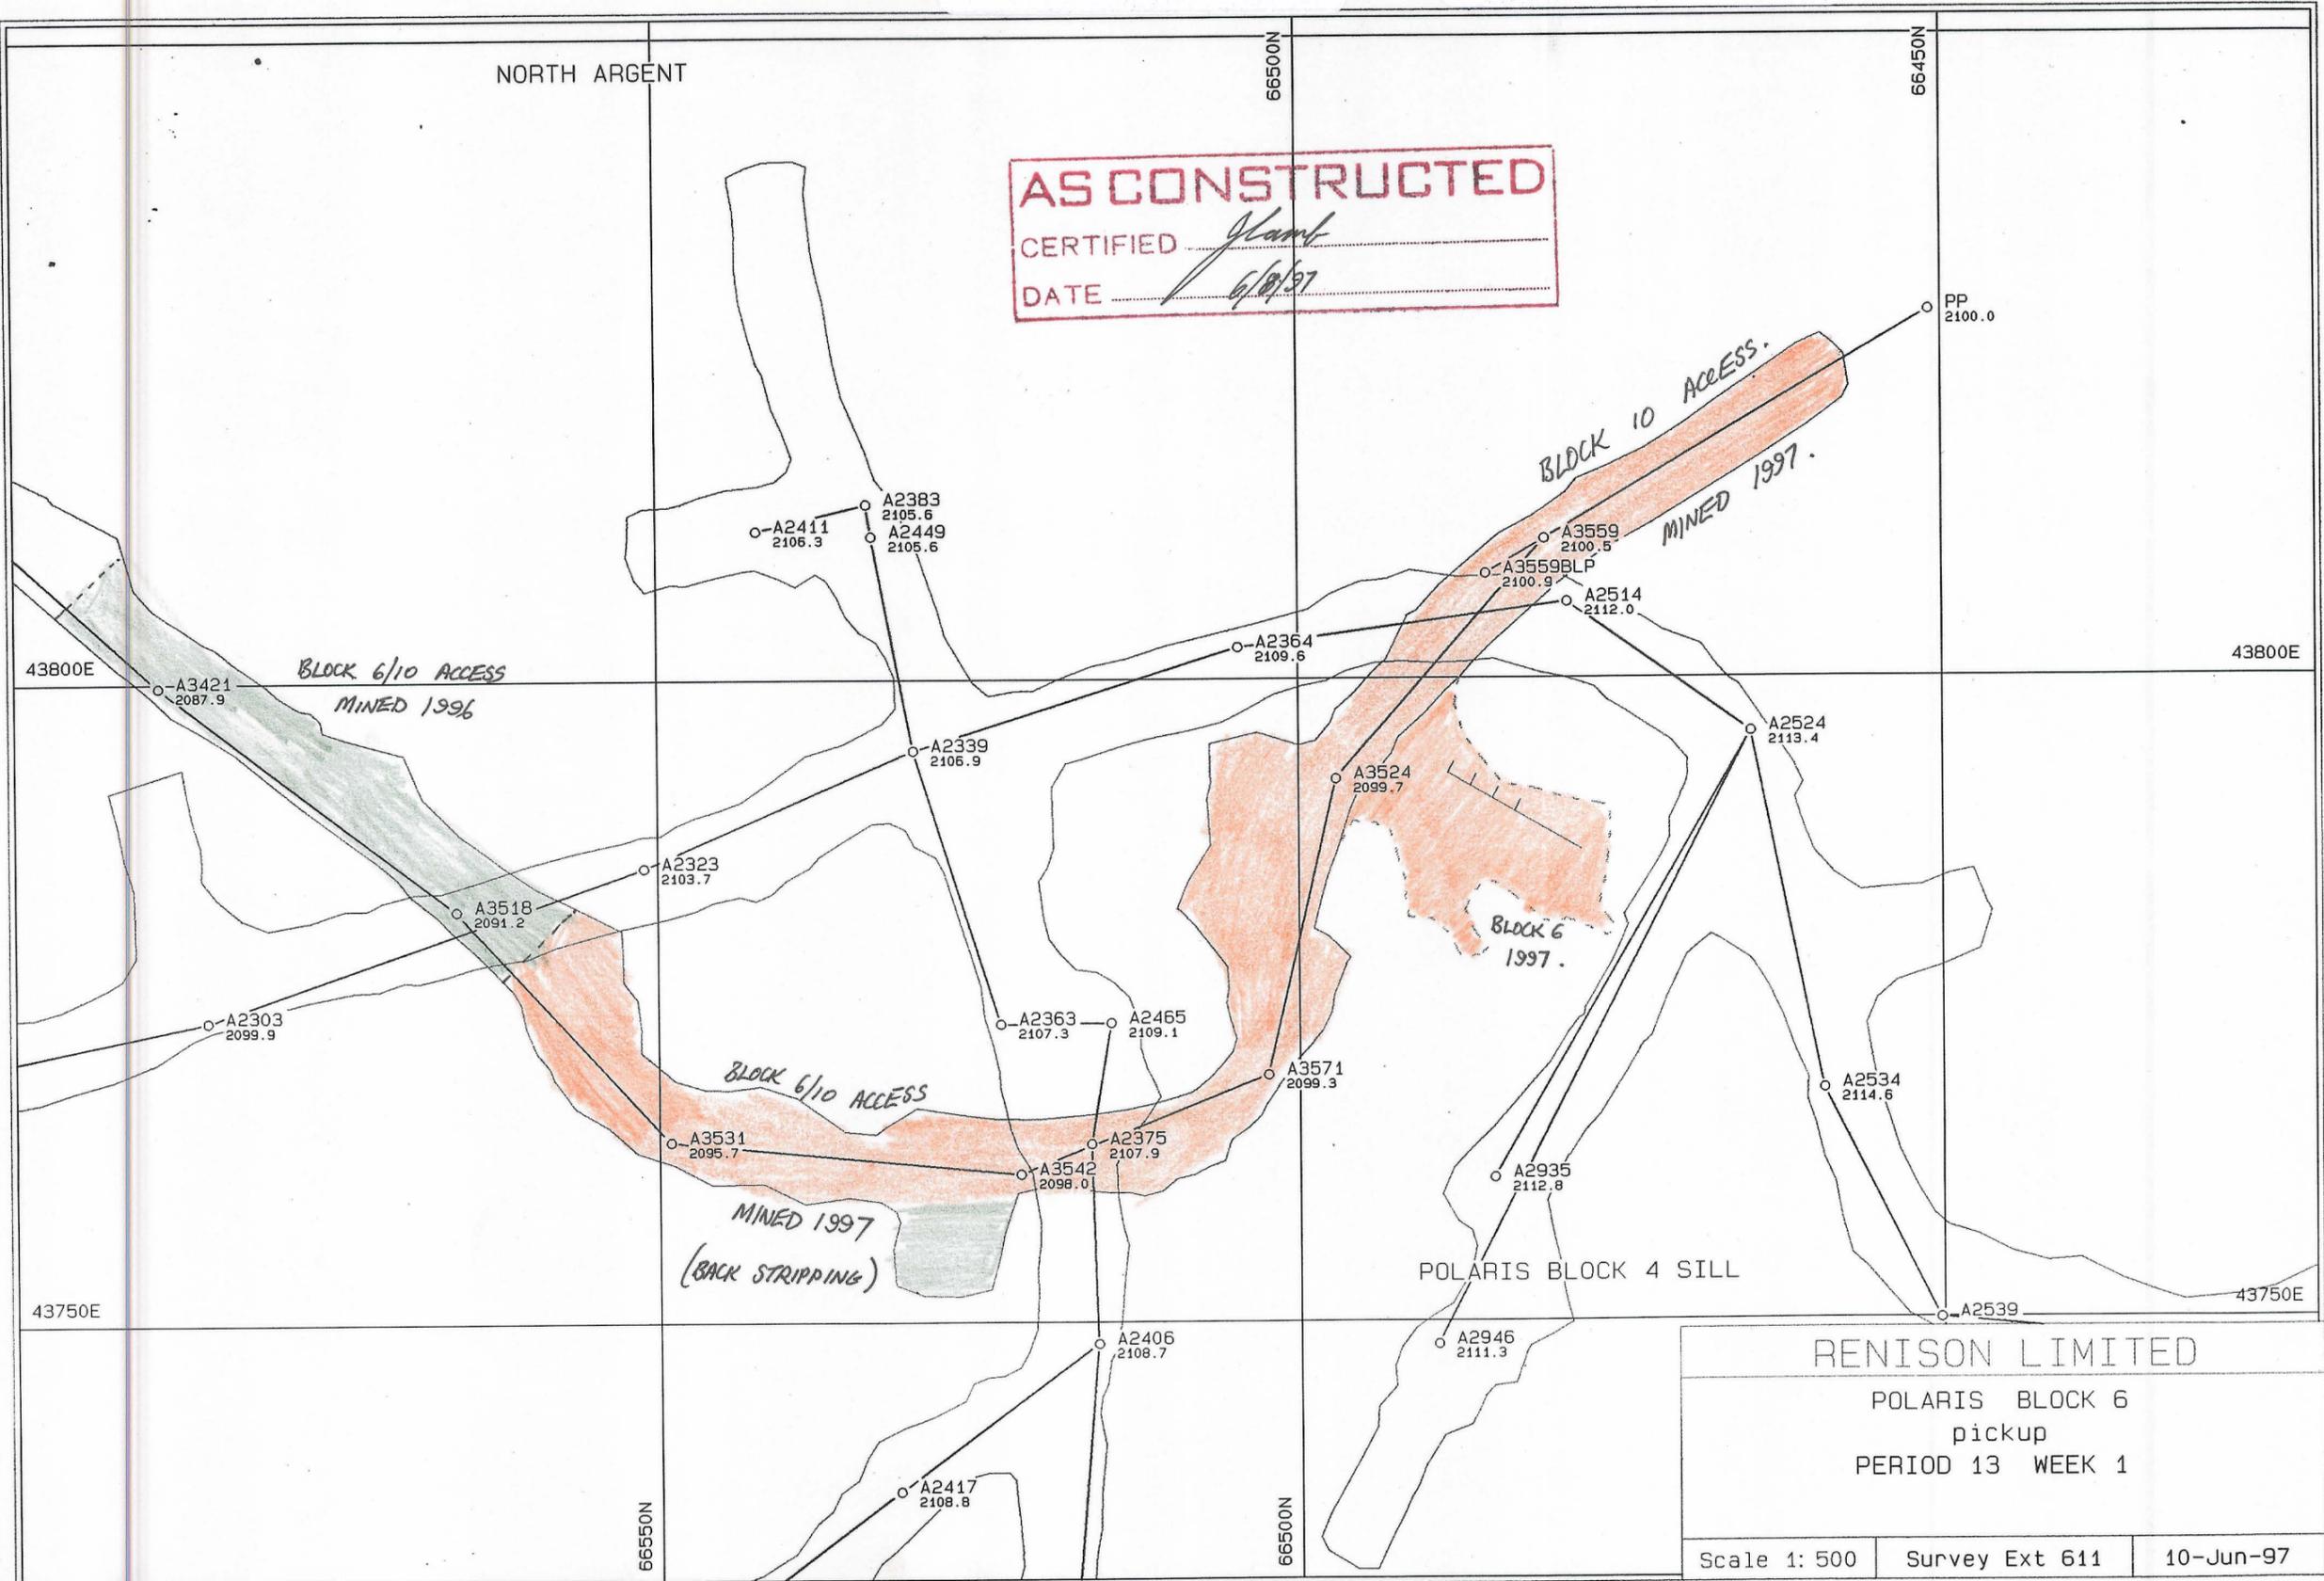

polarisd.dif