



0376\_724

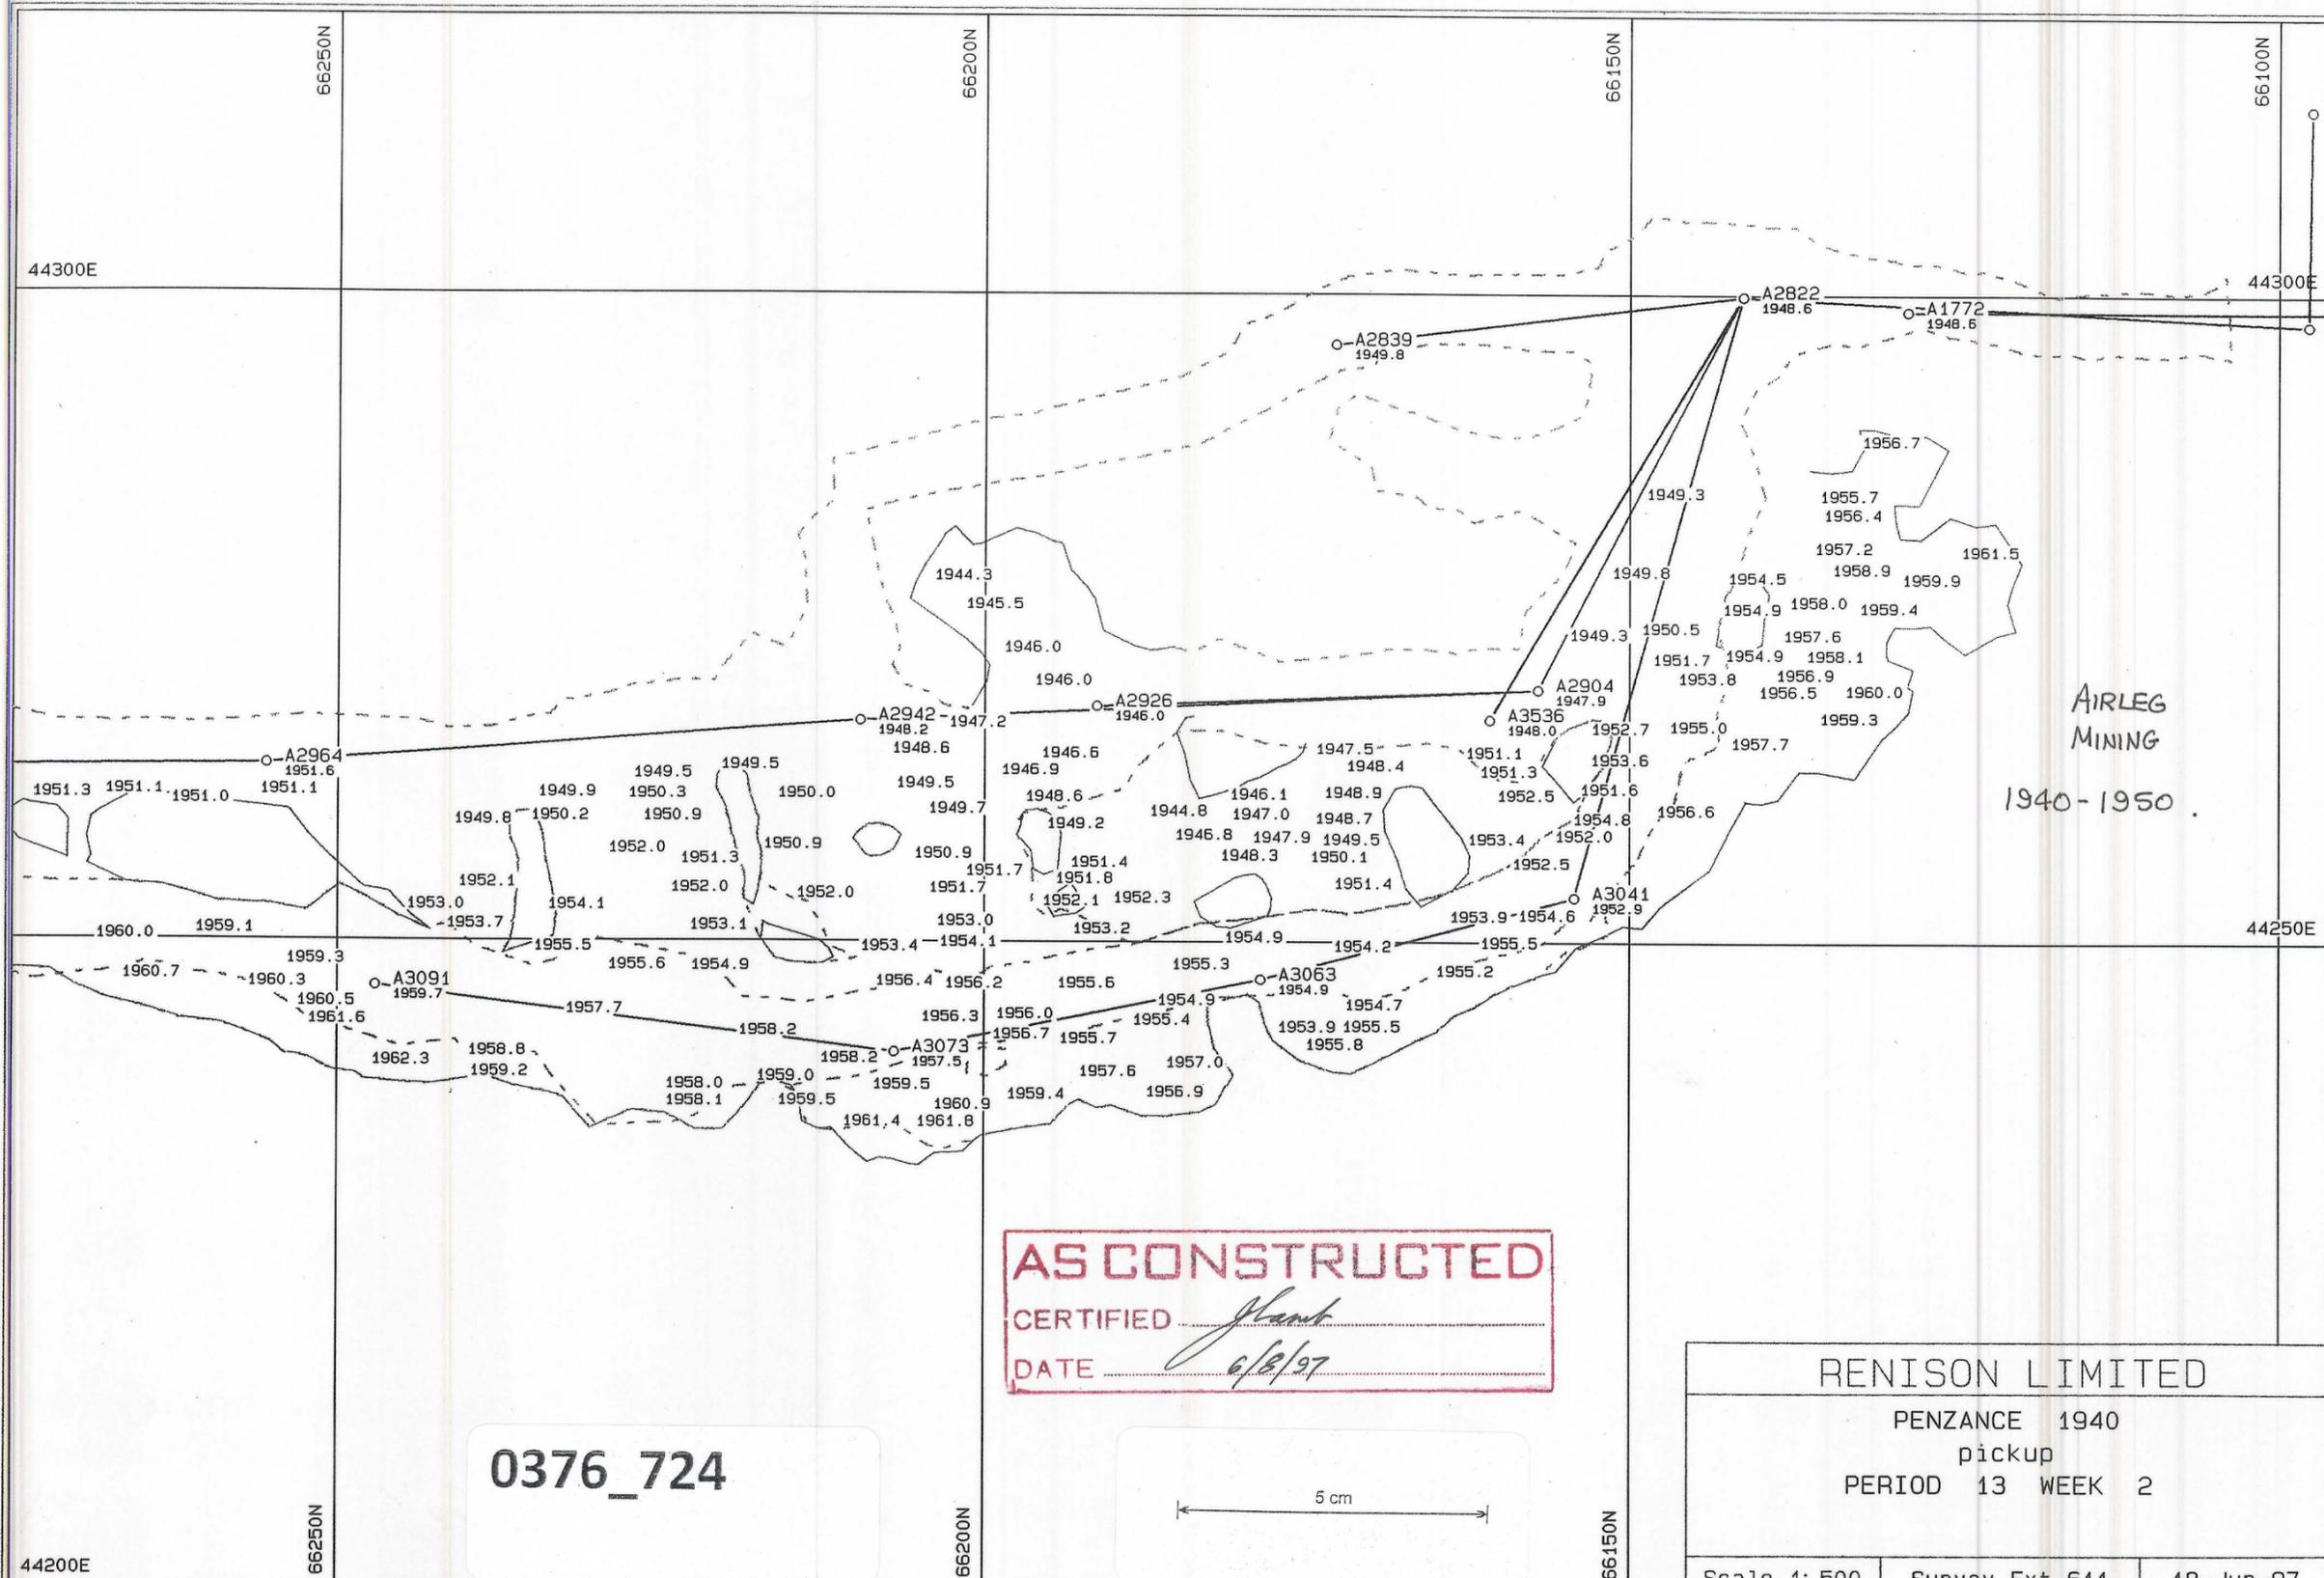

0376\_724

**AS CONSTRUCTED**  
 CERTIFIED *Grant*  
 DATE *6/8/97*

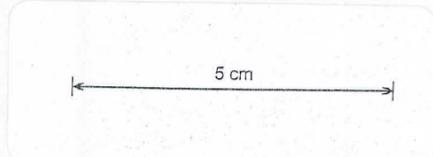

RENISON LIMITED		
PENZANCE 1940		
pickup		
PERIOD 13 WEEK 2		
Scale 1: 500	Survey Ext 611	18-Jun-97

penzancd.pf