


0376\_725

0376\_725

5 cm

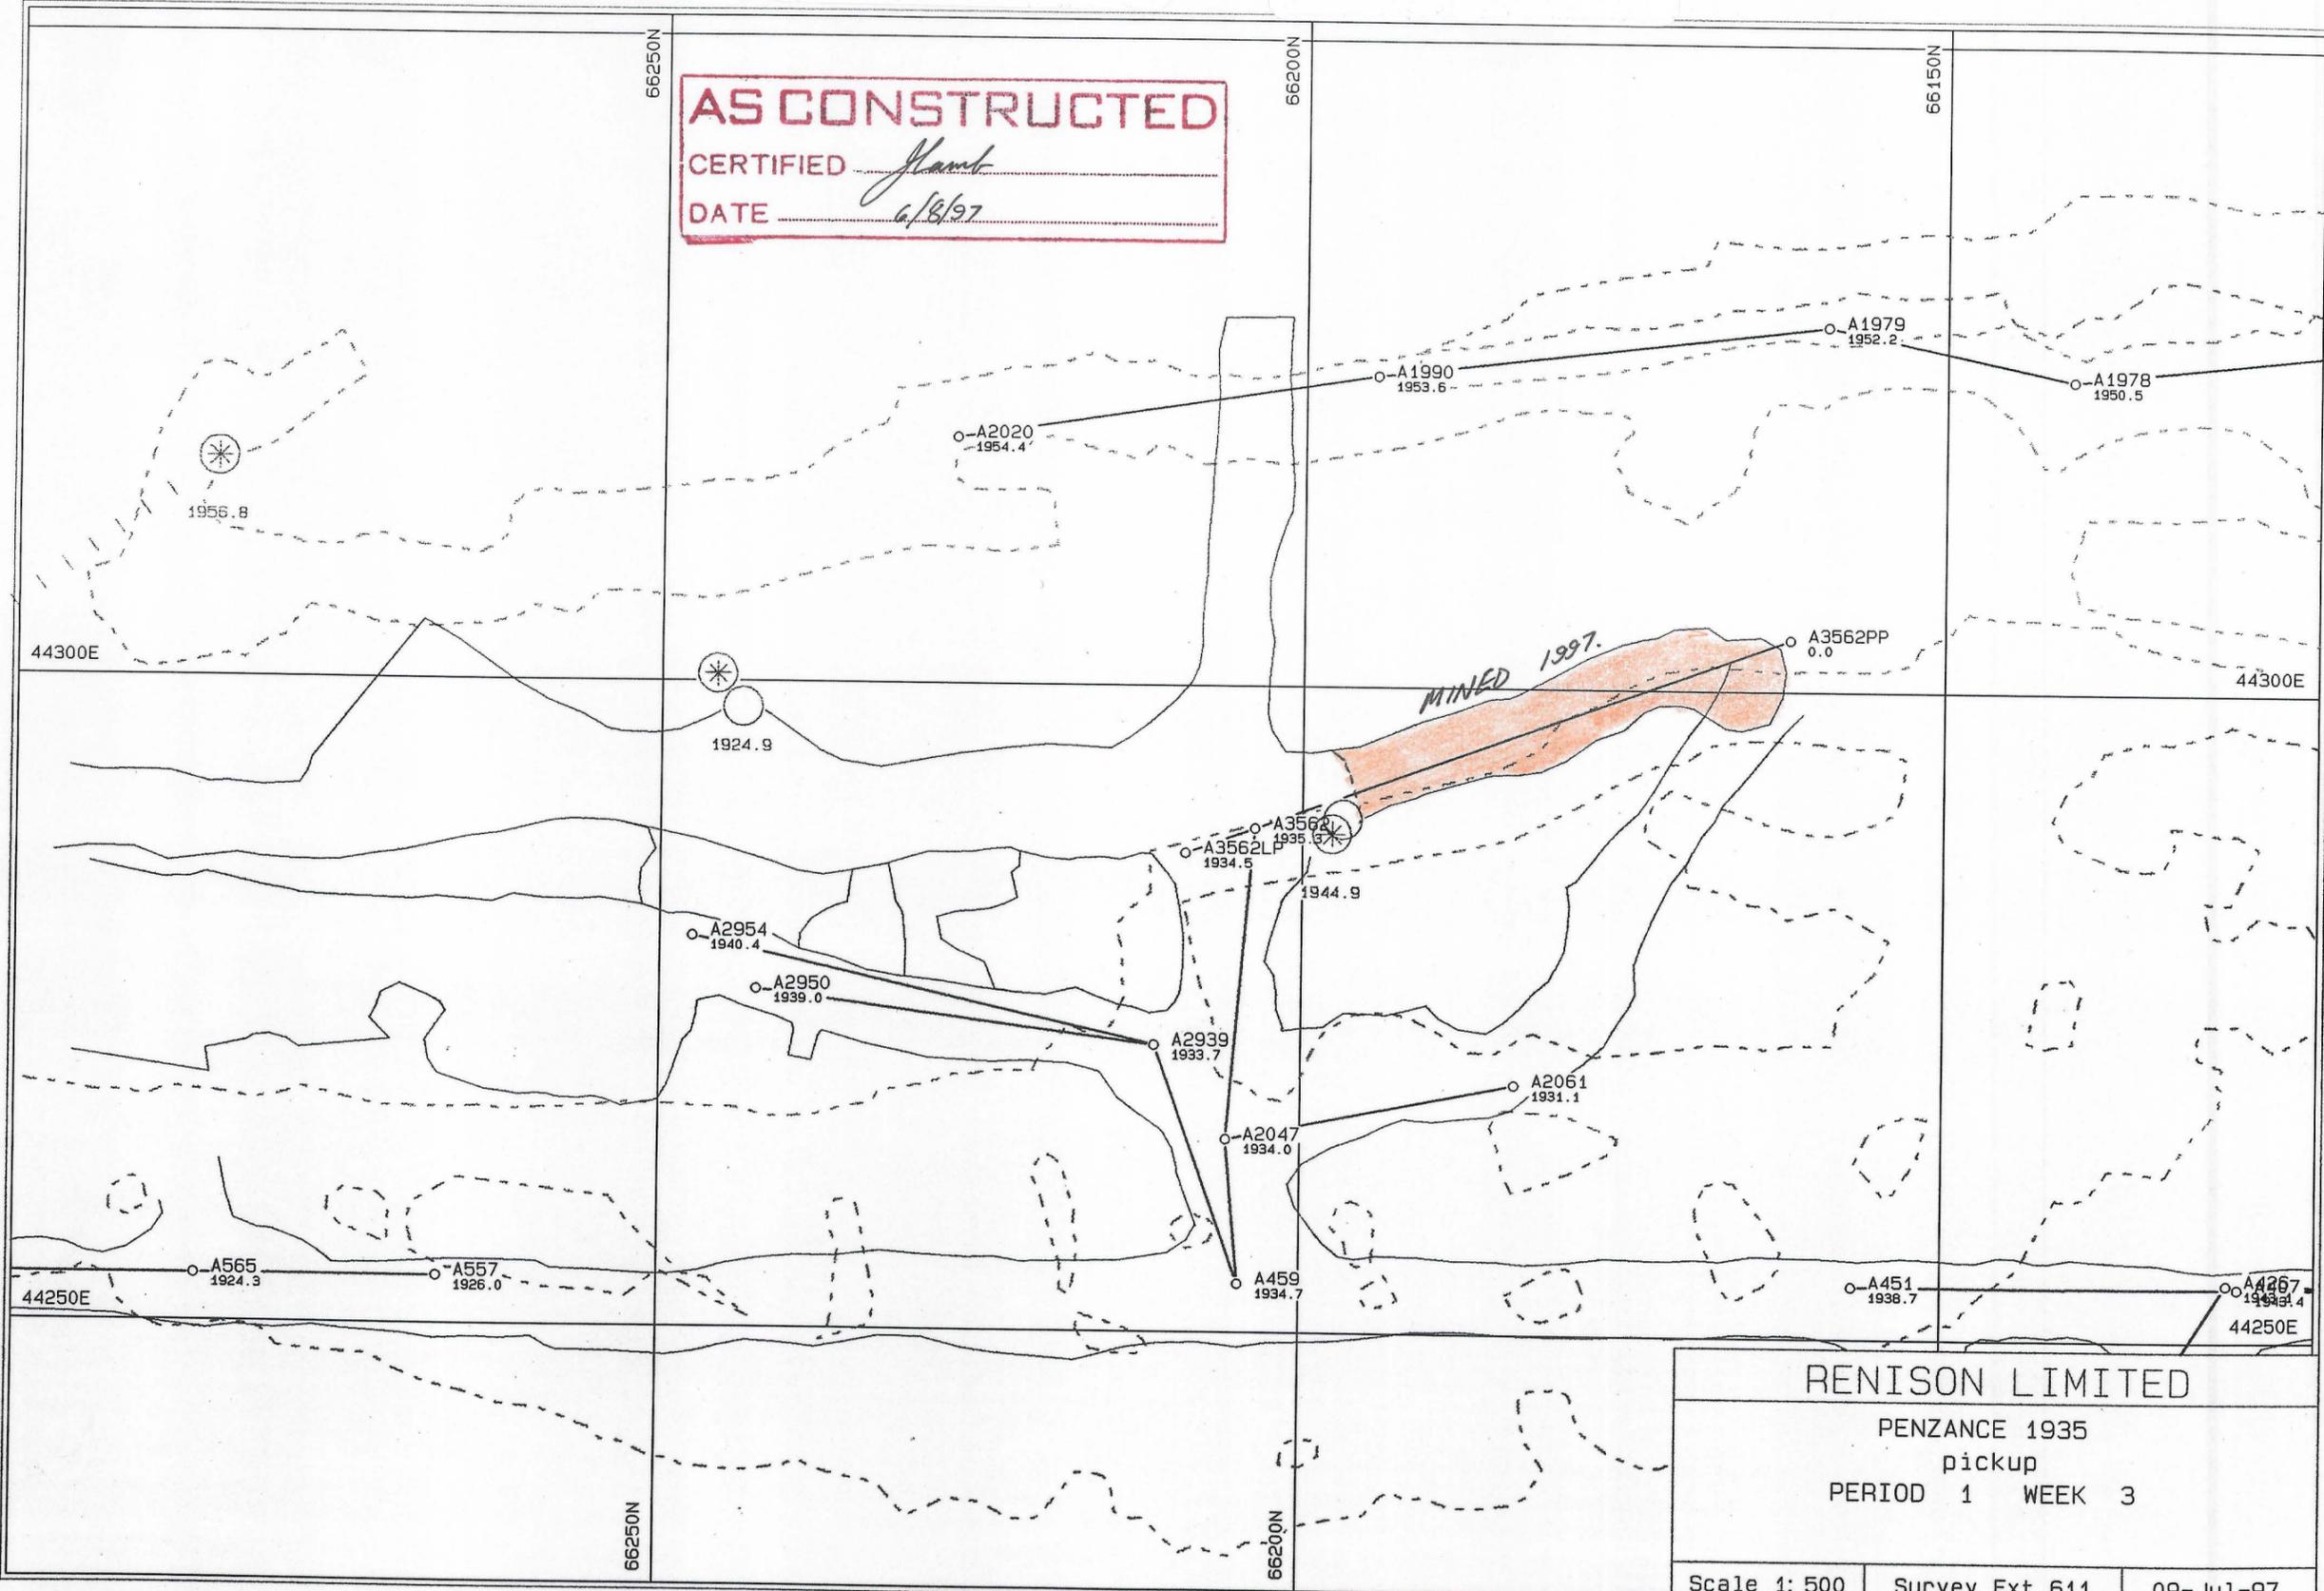

**AS CONSTRUCTED**  
 CERTIFIED *J. Lamb*  
 DATE *6/8/97*

RENISON LIMITED  
 PENZANCE 1935  
 pickup  
 PERIOD 1 WEEK 3  
 Scale 1: 500 | Survey Ext 611 | 09-Jul-97

penzancf.pf