



0376_726

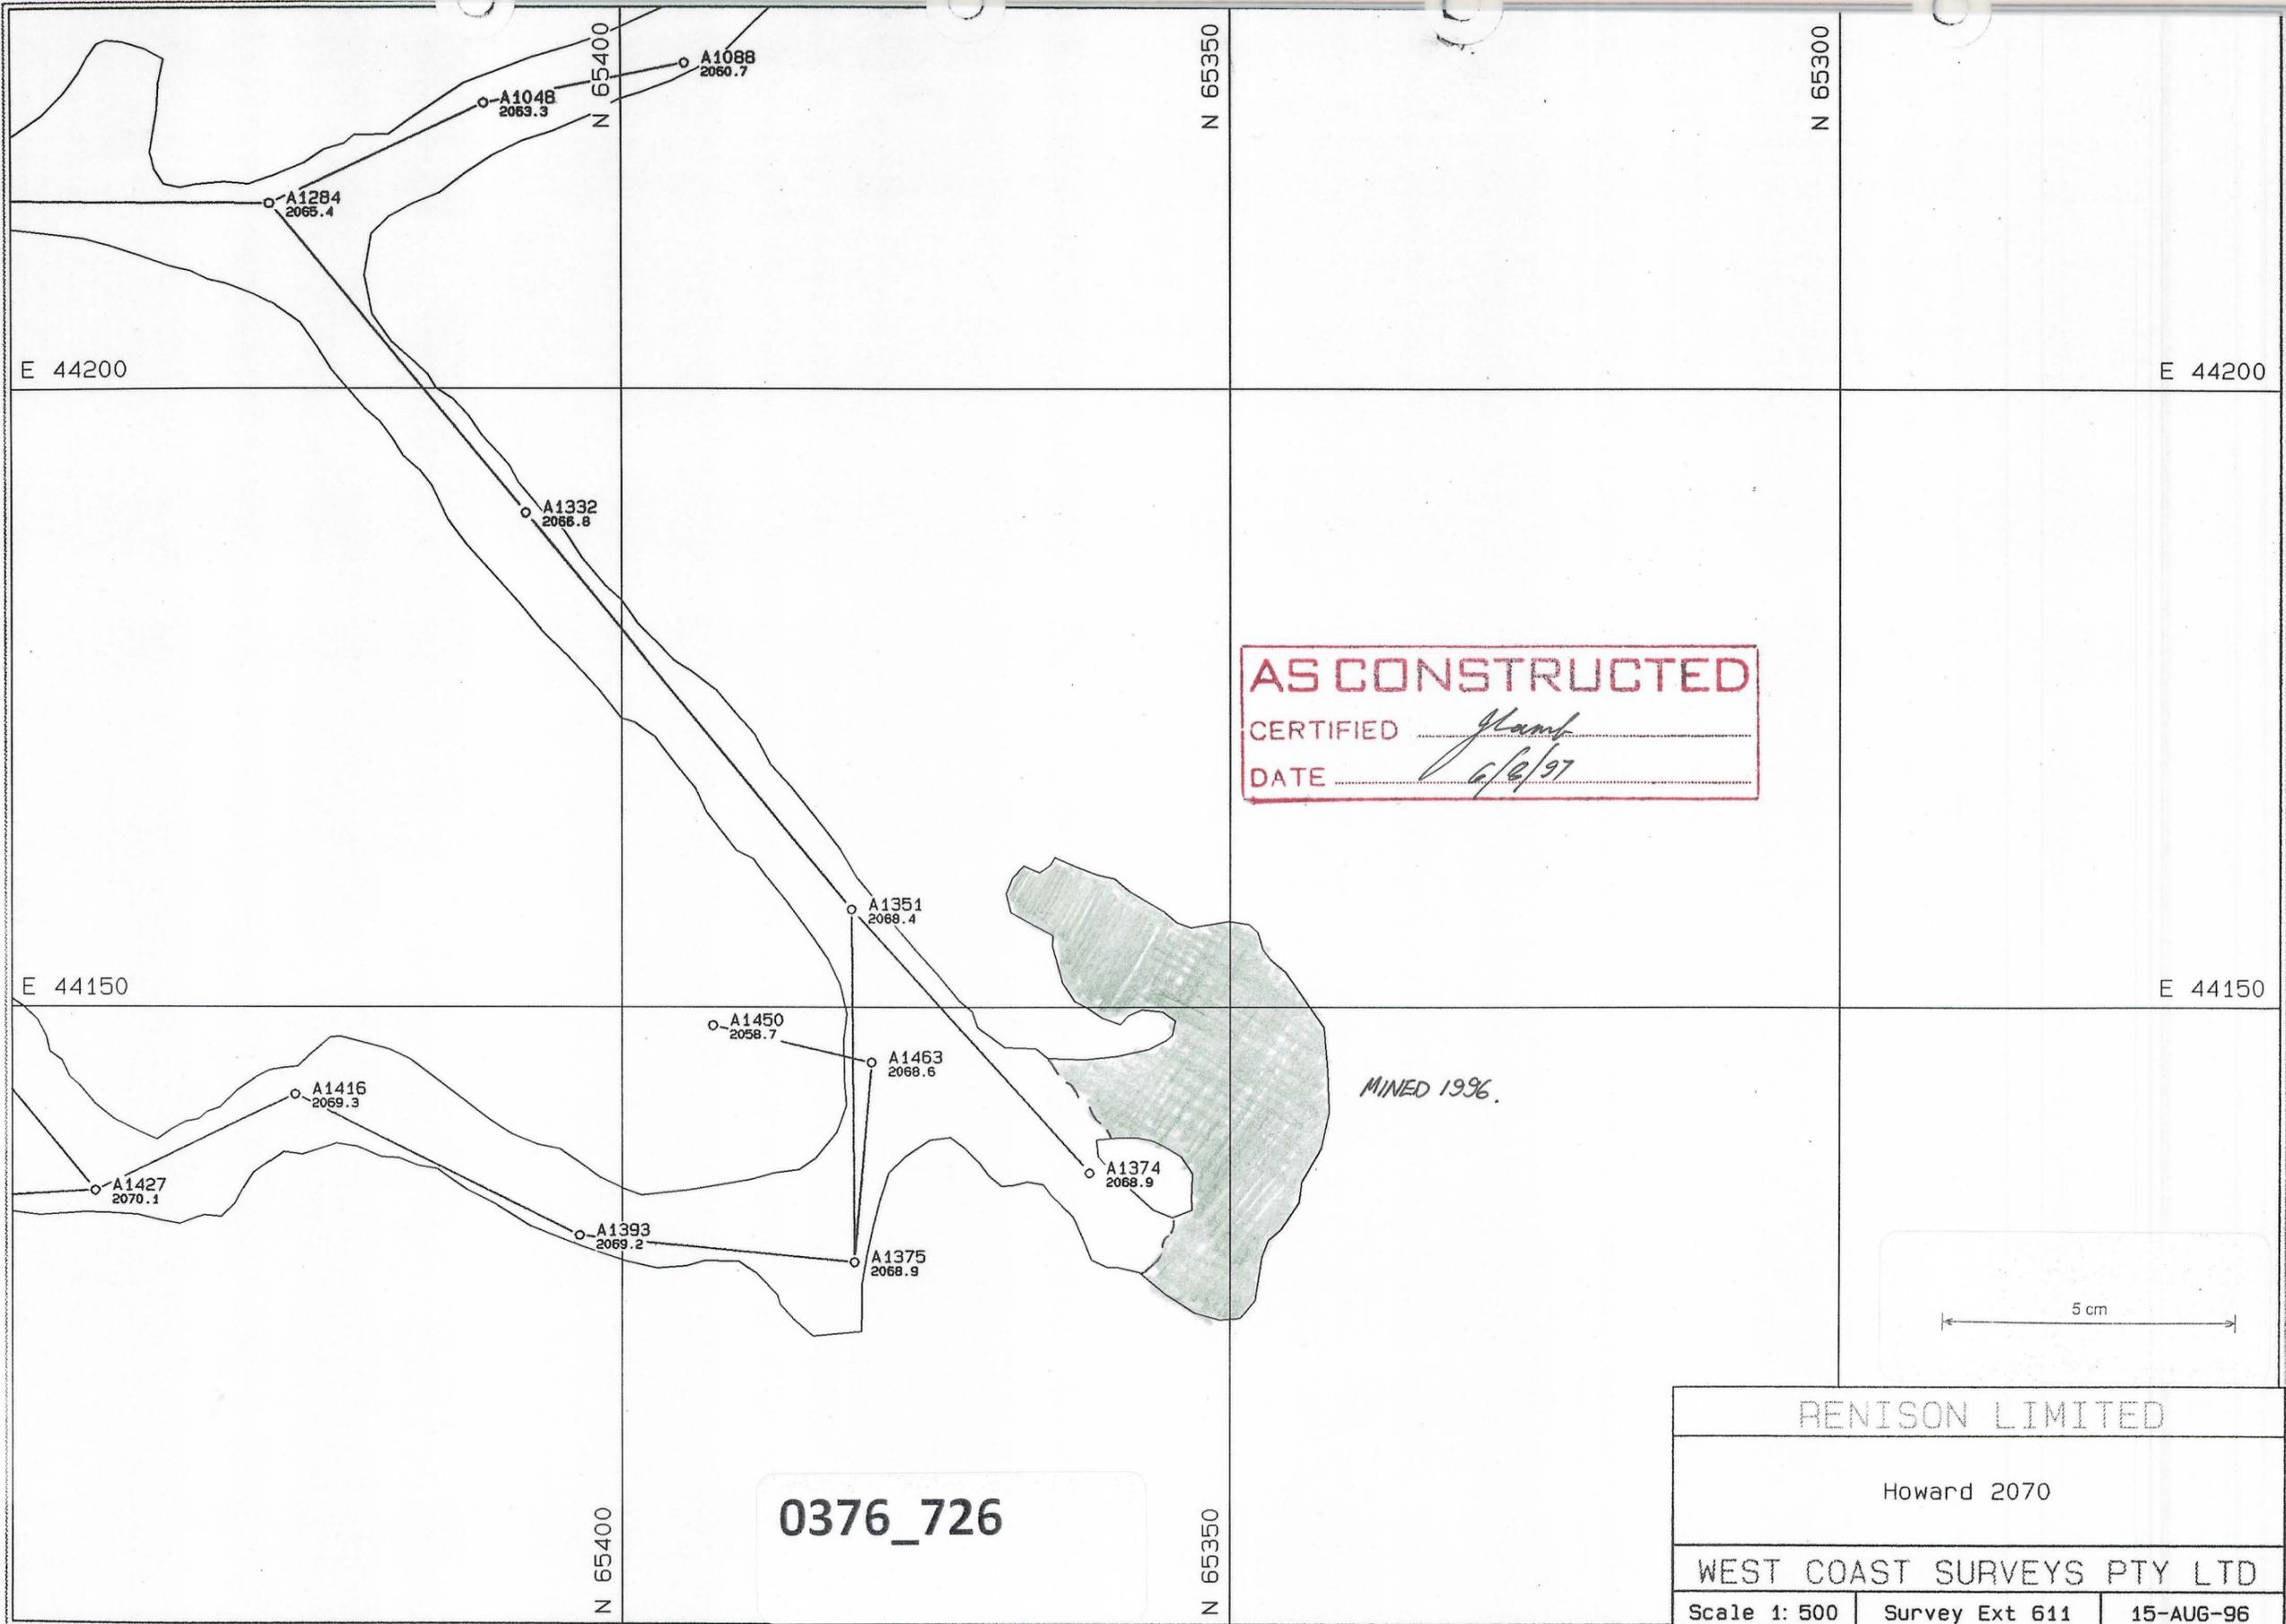

AS CONSTRUCTED
 CERTIFIED *[Signature]*
 DATE *6/2/97*

MINED 1996.

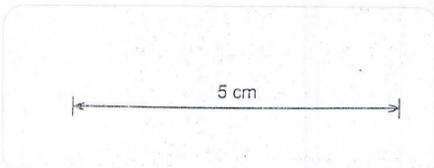

RENISON LIMITED		
Howard 2070		
WEST COAST SURVEYS PTY LTD		
Scale 1: 500	Survey Ext 611	15-AUG-96

0376_726

HOWARA.PF