


0376_727

0376_727

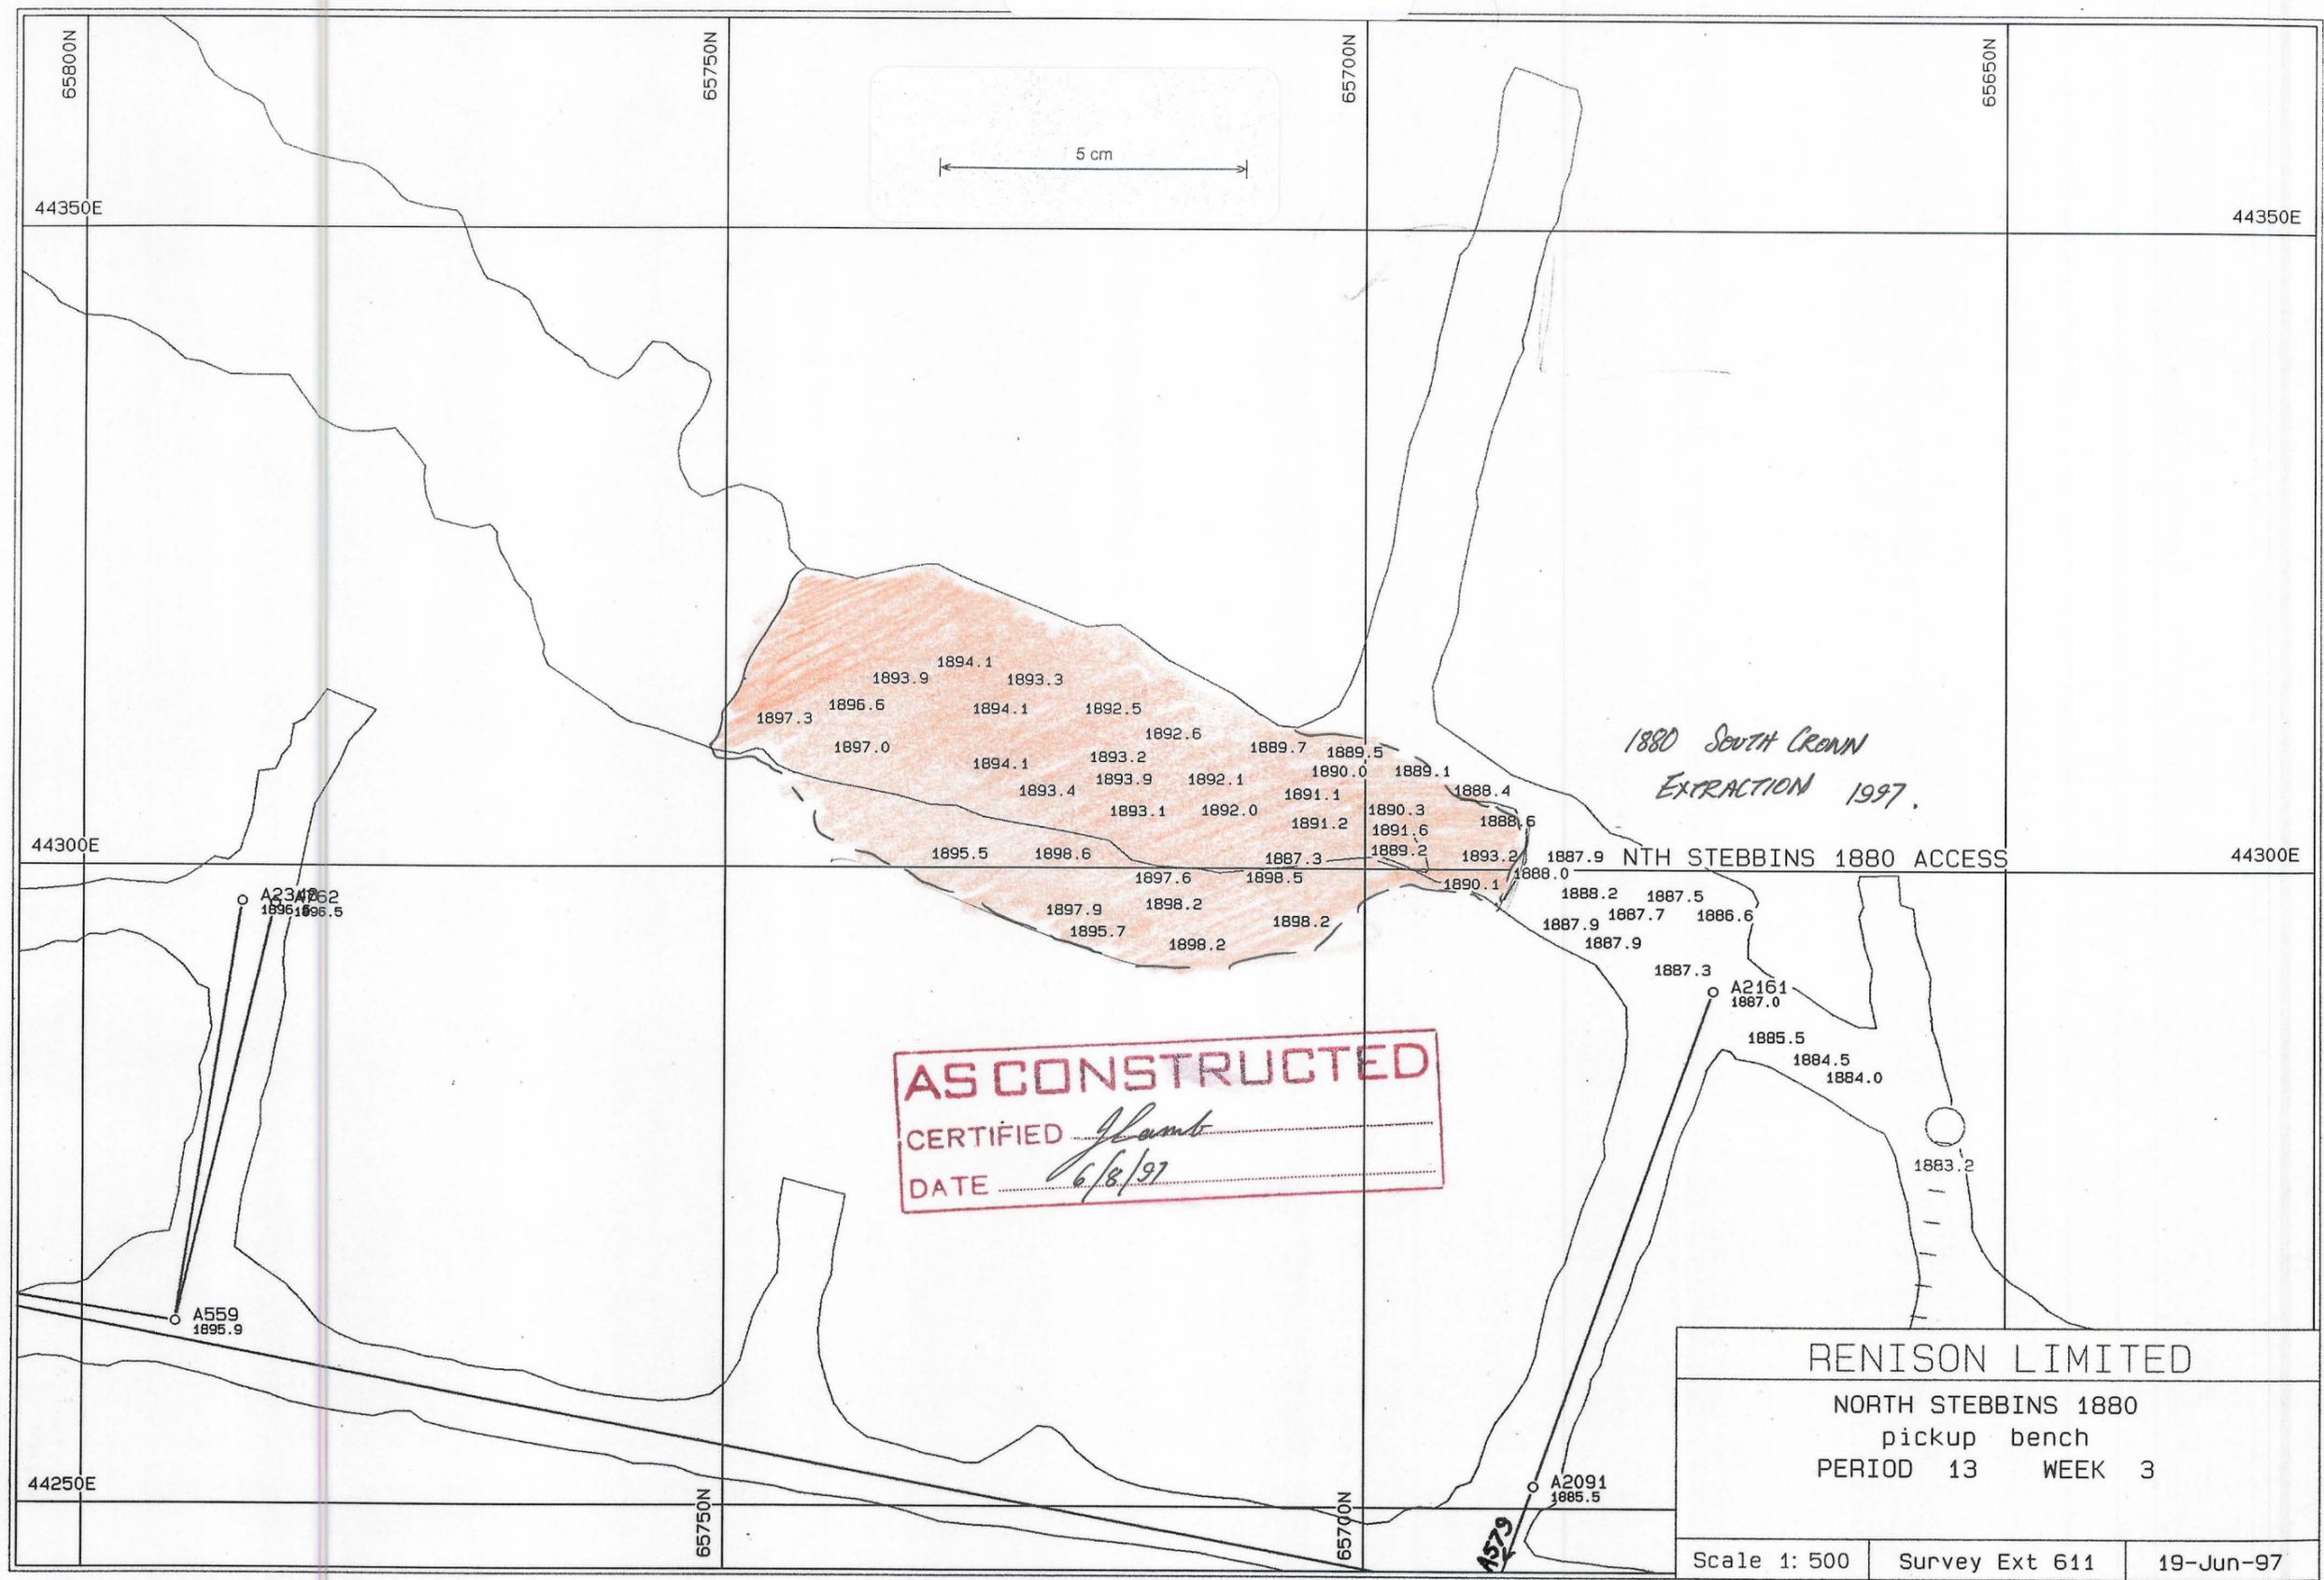

stebbinf.pr