


0376\_728

5 cm

AS CONSTRUCTED

CERTIFIED *Hand*  
DATE *6/8/97*

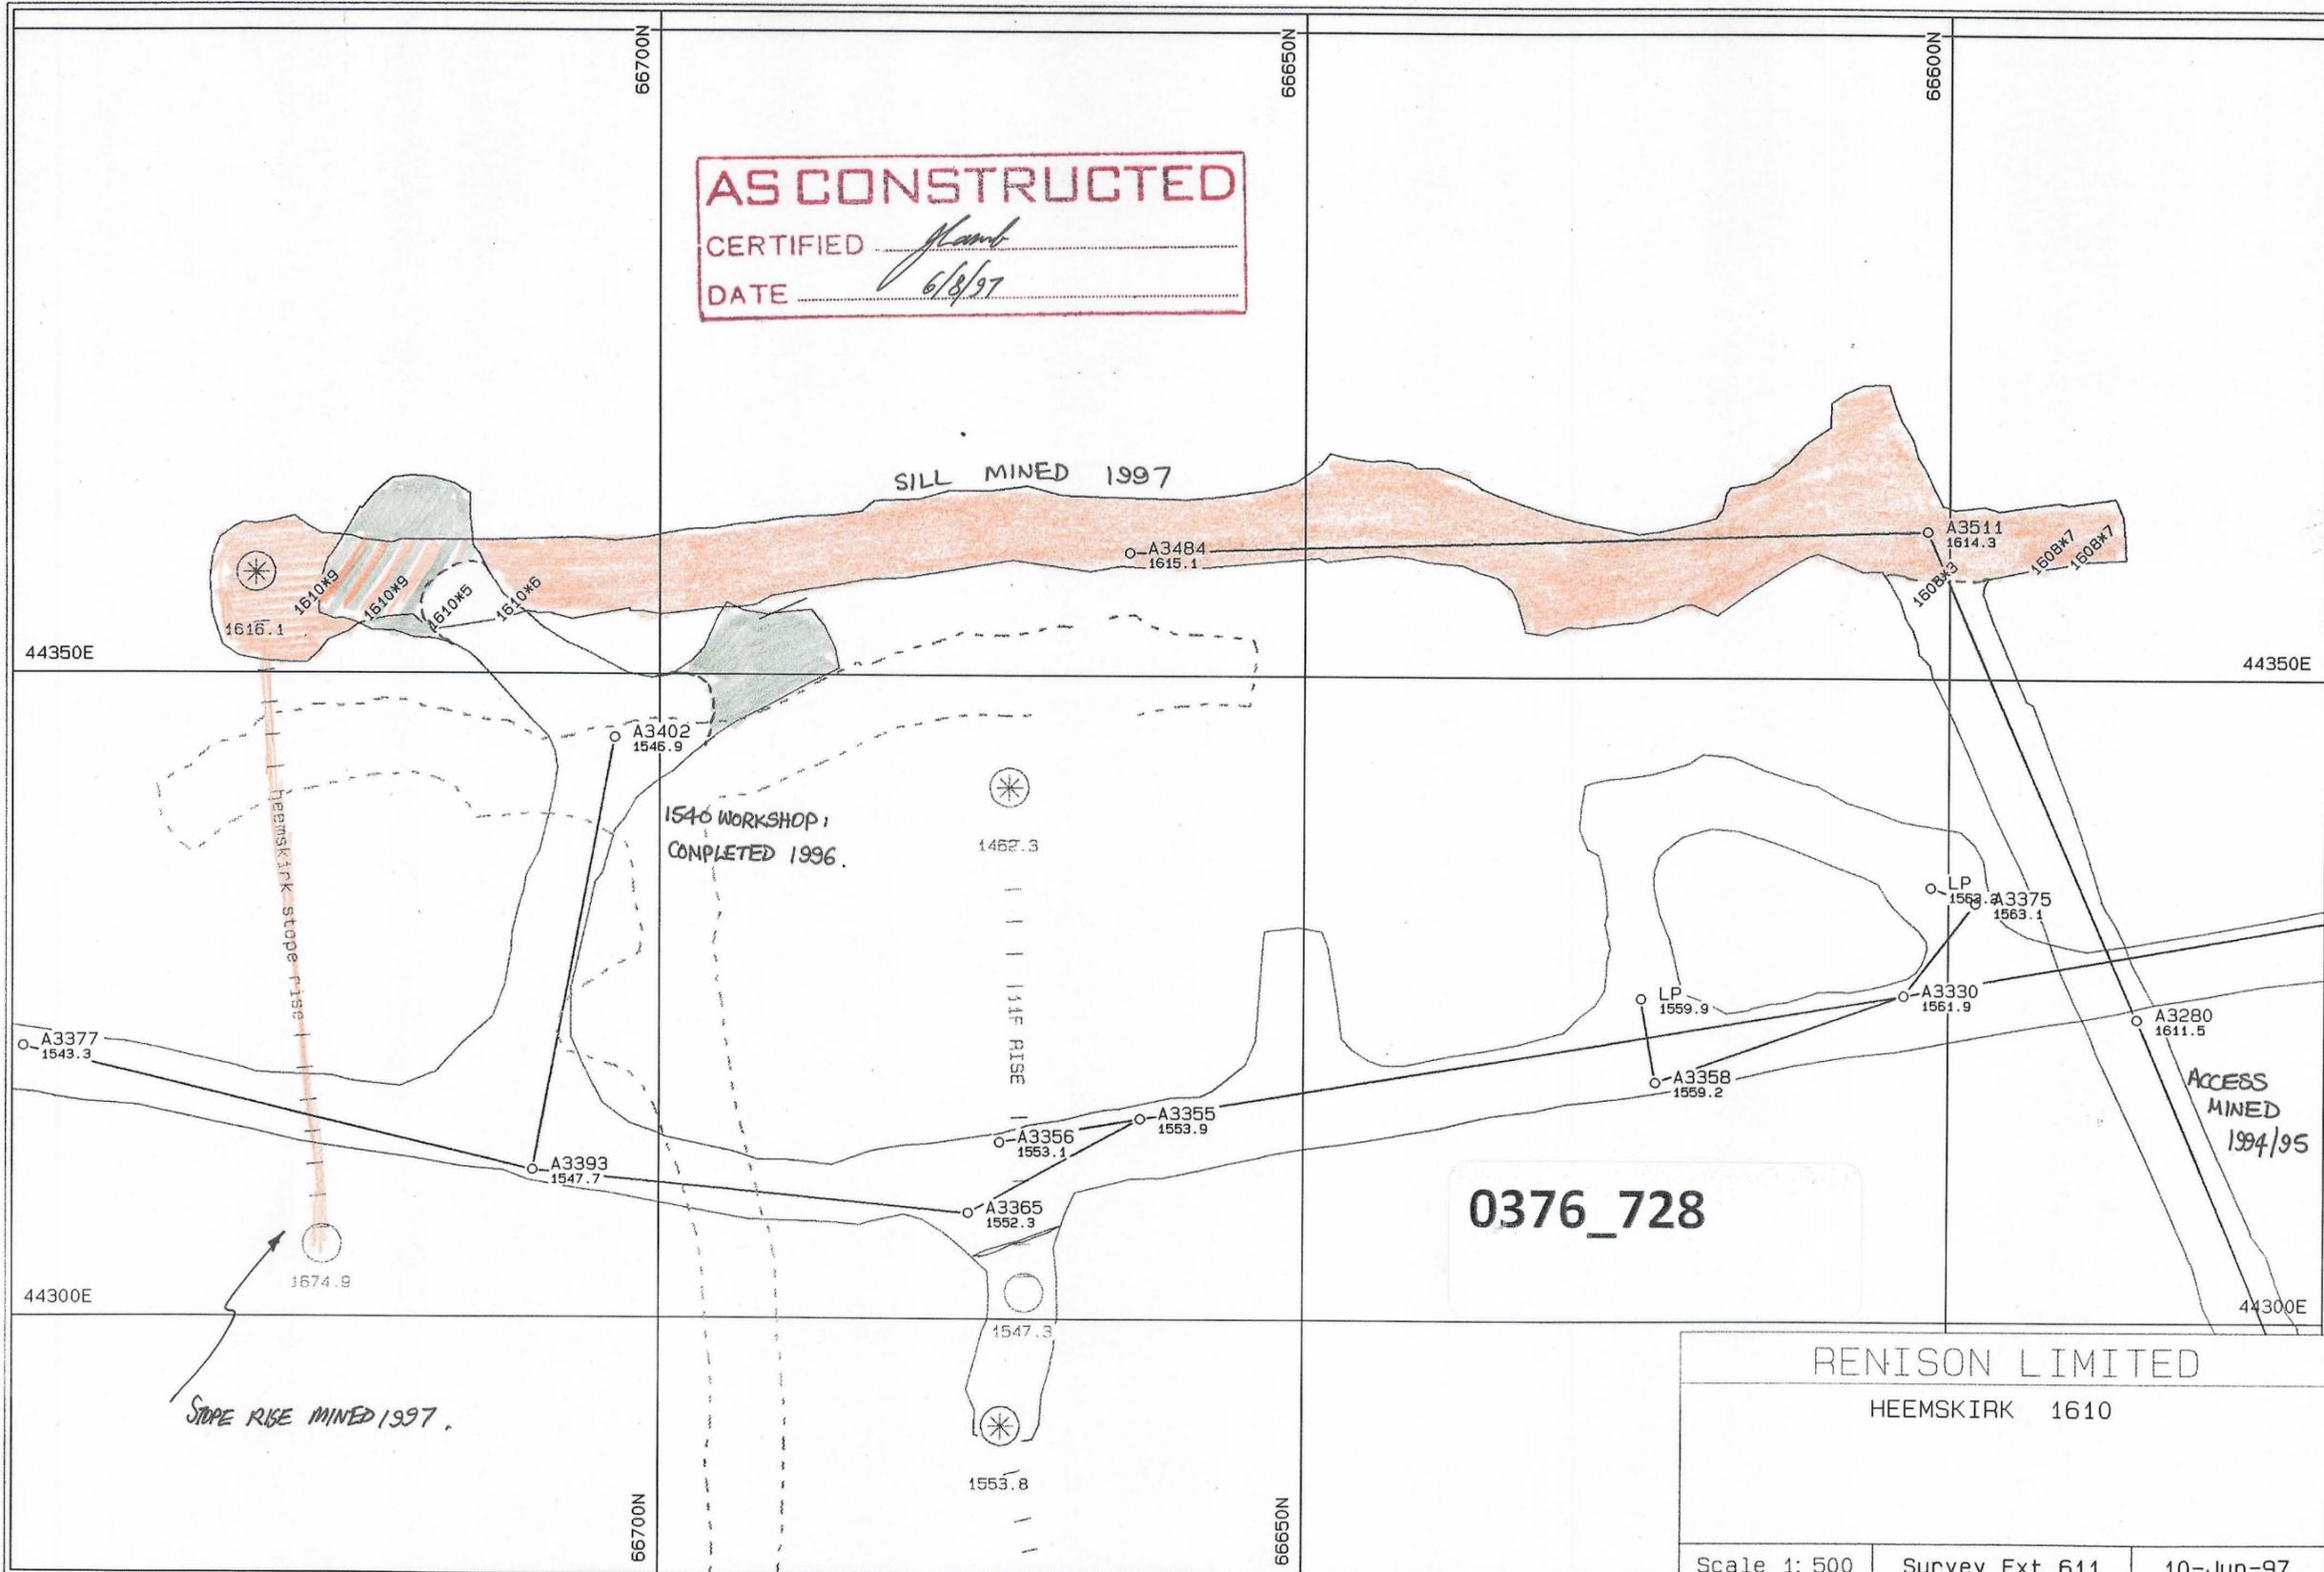

0376\_728

RENISON LIMITED

HEEMSKIRK 1610

Scale 1: 500

Survey Ext 611

10-Jun-97

heemskia.pf